


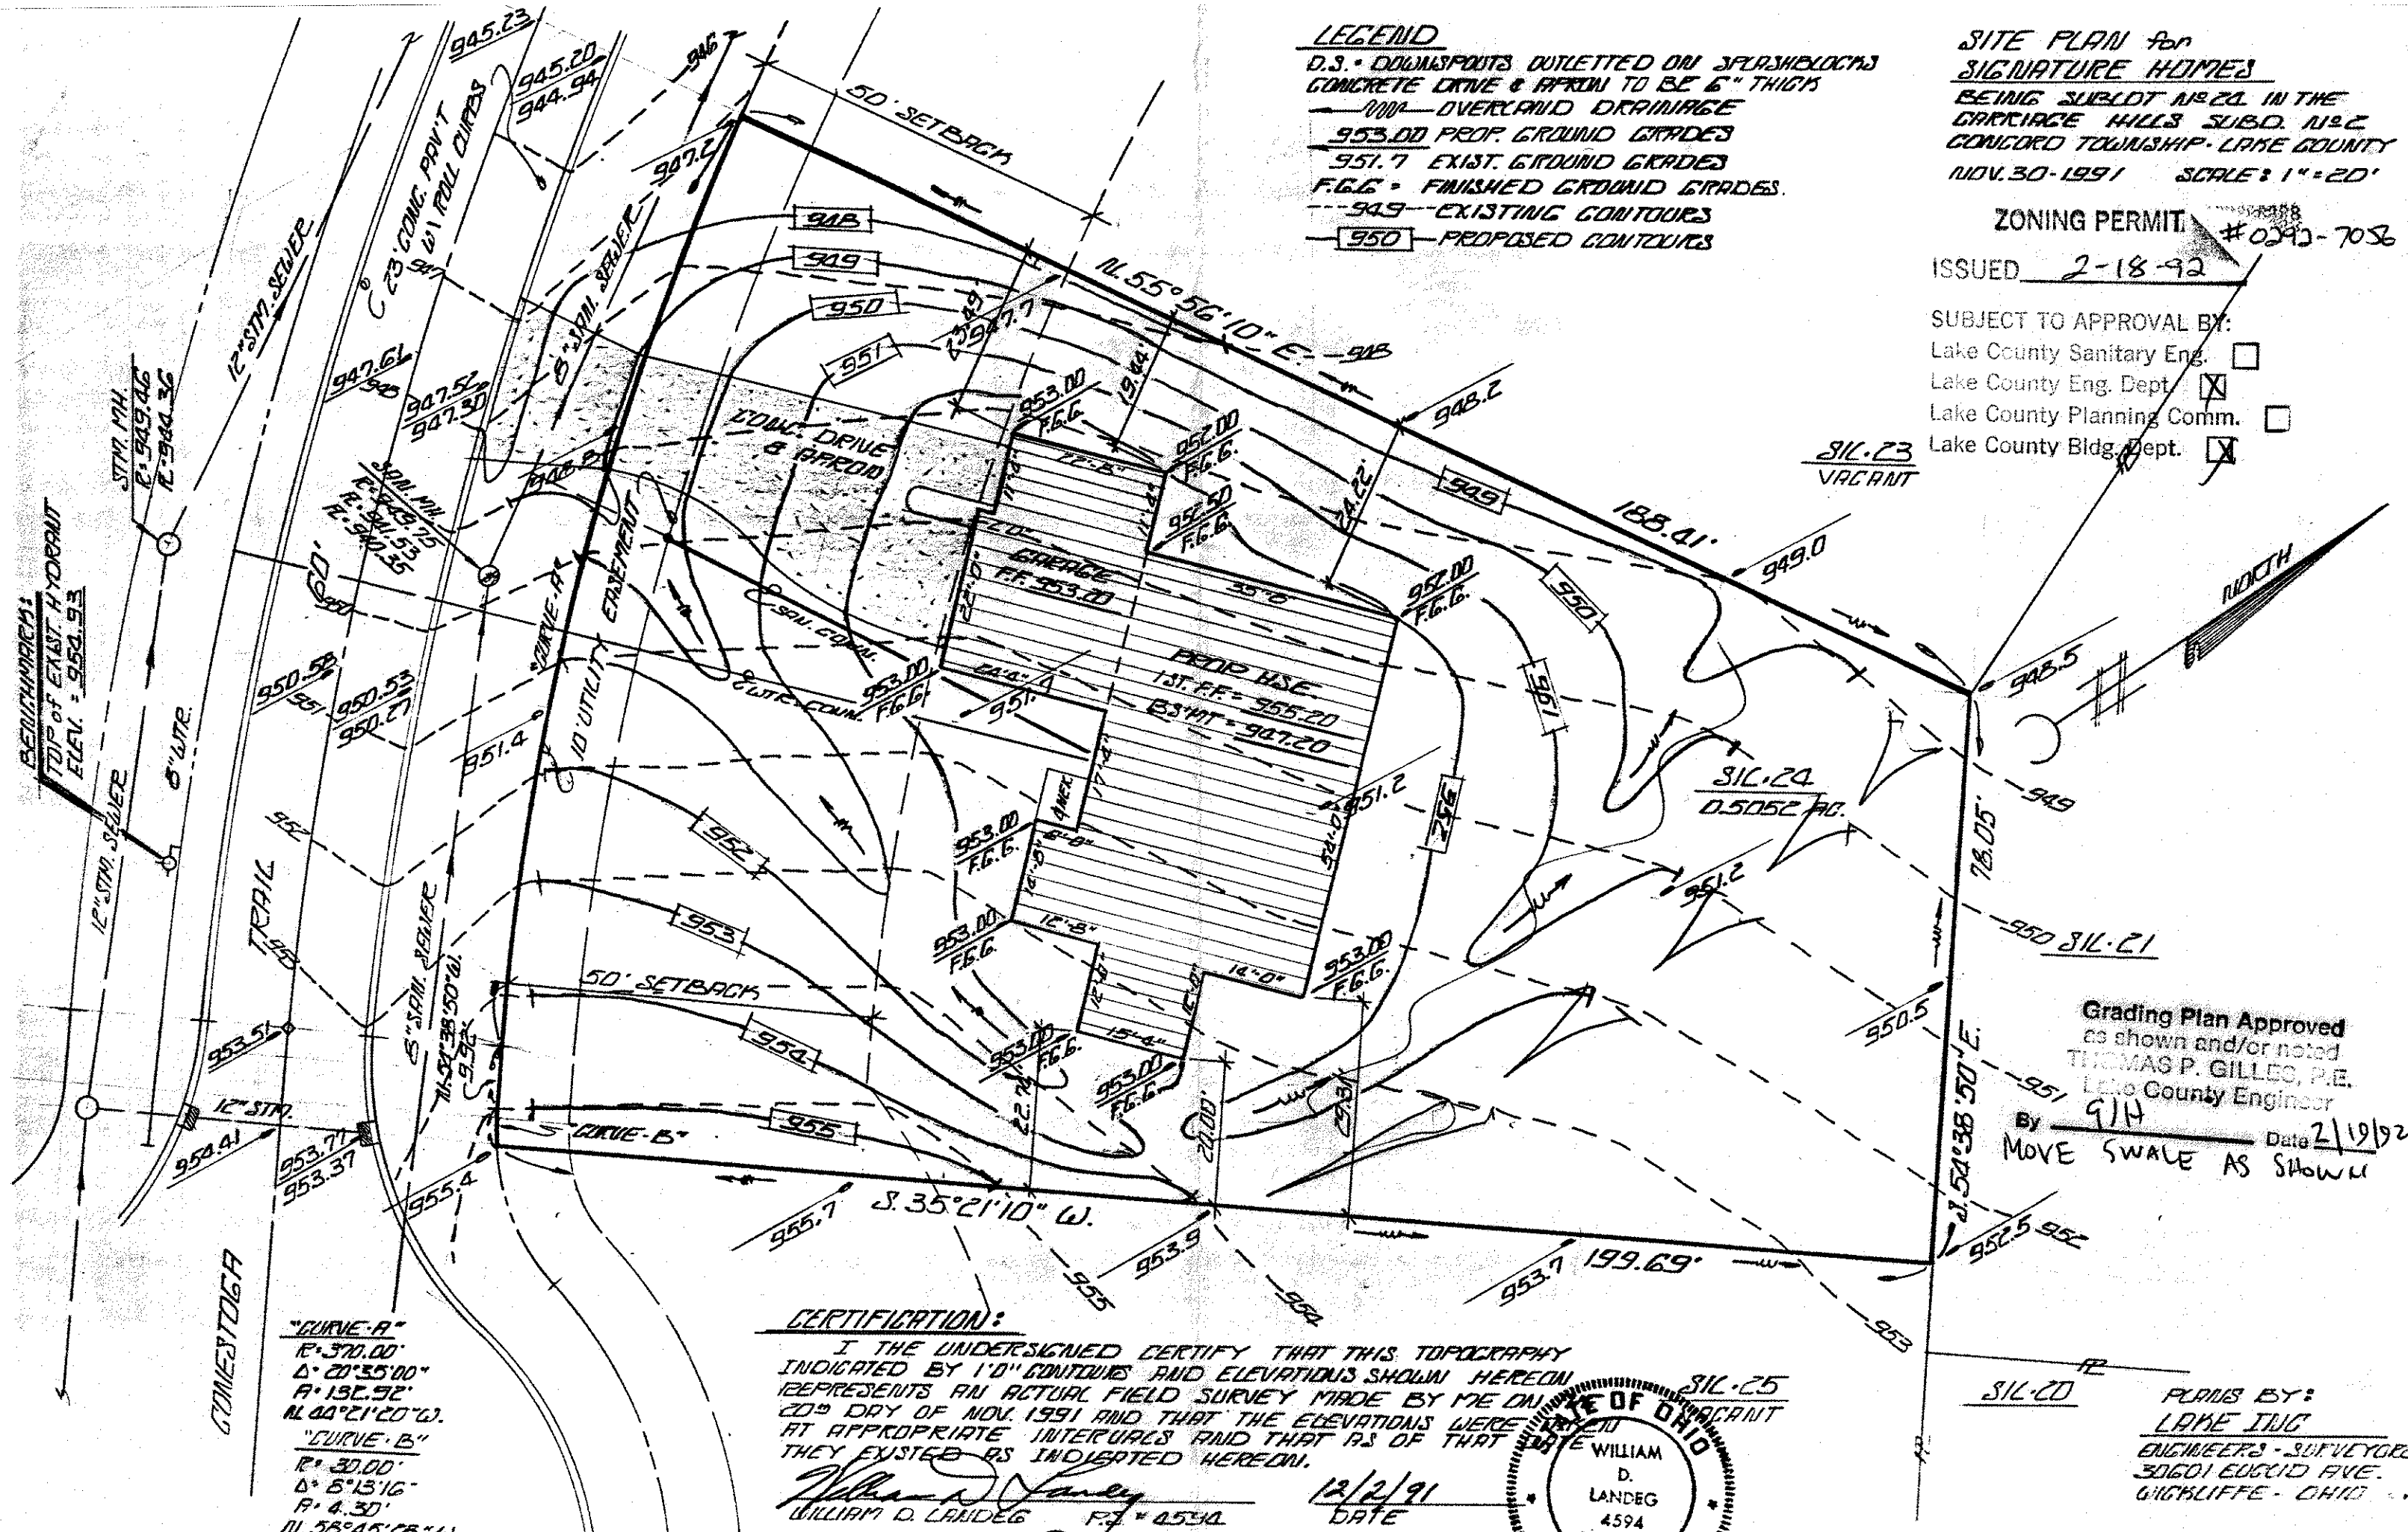

LEGEND

- D.S. - DOWNSPOUTS OUTLETED ON SPURSHEDS
- CONCRETE DRIVE & APRON TO BE 6" THICK
- OVERLAND DRAINAGE
- 953.00 PROP. GROUND GRADES
- 951.7 EXIST. GROUND GRADES
- F.G.G. - FINISHED GROUND GRADES
- EXISTING CONTOURS
- [950] PROPOSED CONTOURS

SITE PLAN for
SIGNATURE HOMES
BEING SUBLOT NO. 20 IN THE
GARFAGE HILLS SUBD. NO. 2
CONCORD TOWNSHIP - LAKE COUNTY
NOV. 30 - 1991 SCALE: 1" = 20'

ZONING PERMIT #0292-708

ISSUED 2-18-92

SUBJECT TO APPROVAL BY:

- Lake County Sanitary Eng. ☐
- Lake County Eng. Dept. ☒
- Lake County Planning Comm. ☐
- Lake County Bldg. Dept. ☒

811.23
VACANT

Grading Plan Approved
as shown and/or noted
THOMAS P. GILLES, P.E.
Lake County Engineer


By 914 Date 2/19/92
MOVE SWALE AS SHOWN

CERTIFICATION:

I THE UNDERSIGNED CERTIFY THAT THIS TOPOGRAPHY
INDICATED BY 1"0" CONTOURS AND ELEVATIONS SHOWN HEREON
REPRESENTS AN ACTUAL FIELD SURVEY MADE BY ME ON
20th DAY OF NOV. 1991 AND THAT THE ELEVATIONS WERE
AT APPROPRIATE INTERVALS AND THAT AS OF THAT
THEY EXISTED AS INDICATED HEREON.

William D. Landeg
WILLIAM D. LANDEG F.S. # 0530

12/2/91
DATE

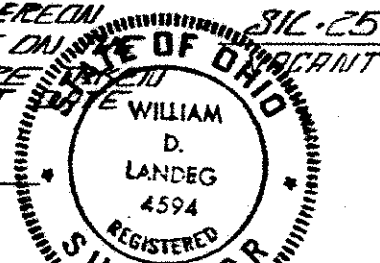

811.20

PERIOD BY:
LAKE INC
ENGINEERS - SURVEYORS
30601 EDGEMO AVE.
WILLOW - OHIO