

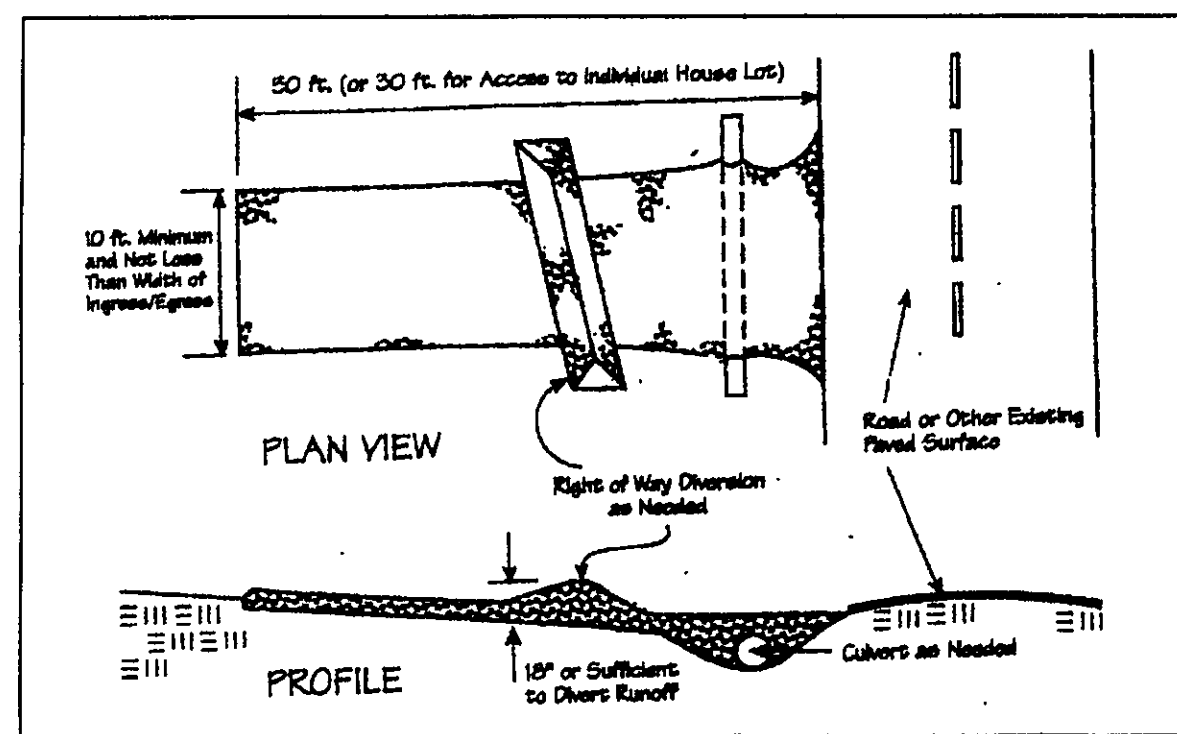


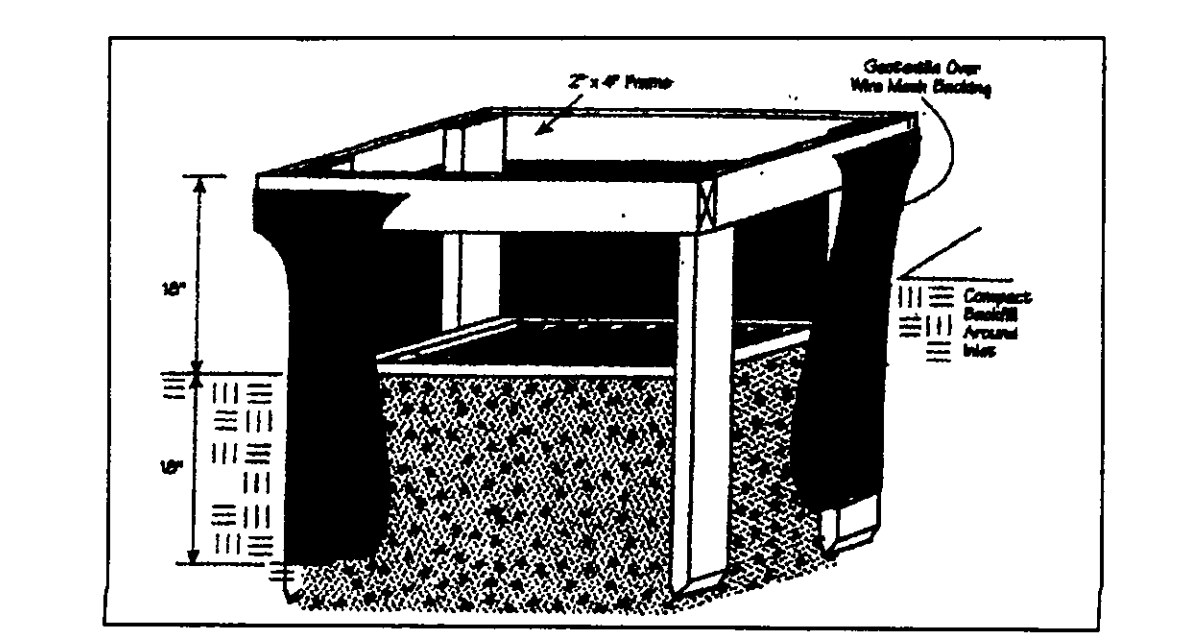

Temporary Seeding Species Selection			
Seeding Dates	Species	Lb./1,000 ft. ²	Per Ac.
March 1 to August 15	Oats	3	4 bushel
	Tall Fescue	1	40 lb.
	Annual Ryegrass	1	40 lb.
	Perennial Ryegrass	1	40 lb.
	Tall Fescue	1	40 lb.
August 15 to November 1	Rye	3	2 bushel
	Tall Fescue	1	40 lb.
	Annual Ryegrass	1	40 lb.
	Wheat	3	2 bushel
	Tall Fescue	1	40 lb.
November 1 to Spring Seeding	Annual Ryegrass	1	40 lb.
	Perennial Ryegrass	1	40 lb.
	Tall Fescue	1	40 lb.
	Annual Ryegrass	1	40 lb.
	Annual Ryegrass	1	40 lb.

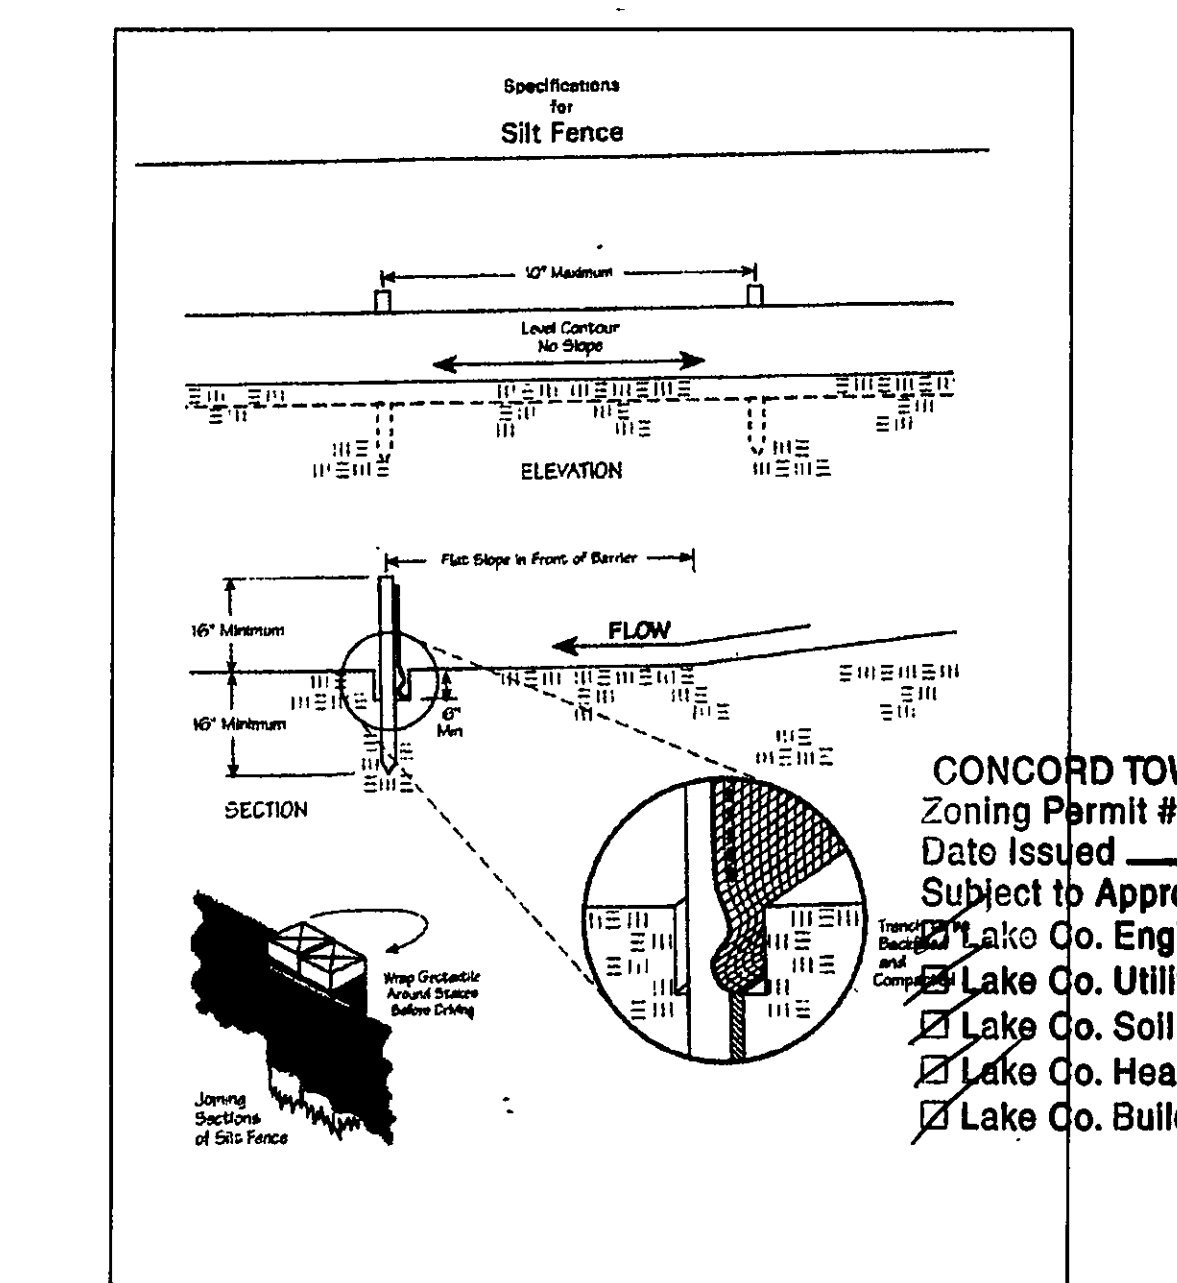

DENISE DE CROW
#970033790
8A-10-55

CONCORD TOWNSHIP ZONING OFFICE
Zoning Permit # 0526-17222
Date Issued 5/17/06
Subject to Approval By:
Lake Co. Engineer/Storm Water Mgmt.
Lake Co. Utilities Dept.
Lake Co. Soil + Water District
Lake Co. Health District
Lake Co. Building Dept.


8A-10A-07
DARRIN PRICE & MELANIE INGRAM
VOL. 1195 - PG. 733

JOSHUA & MELISA ROSENHECK
No. 2004R005873
9.20056 Ac.

JULIE M. LOXTERMAN
VOL. 1149 - PG. 682
8A-11-39

CONLEY ROAD - 60'

DRIP DISTRIBUTION PLAN SUBMITTAL REVIEW

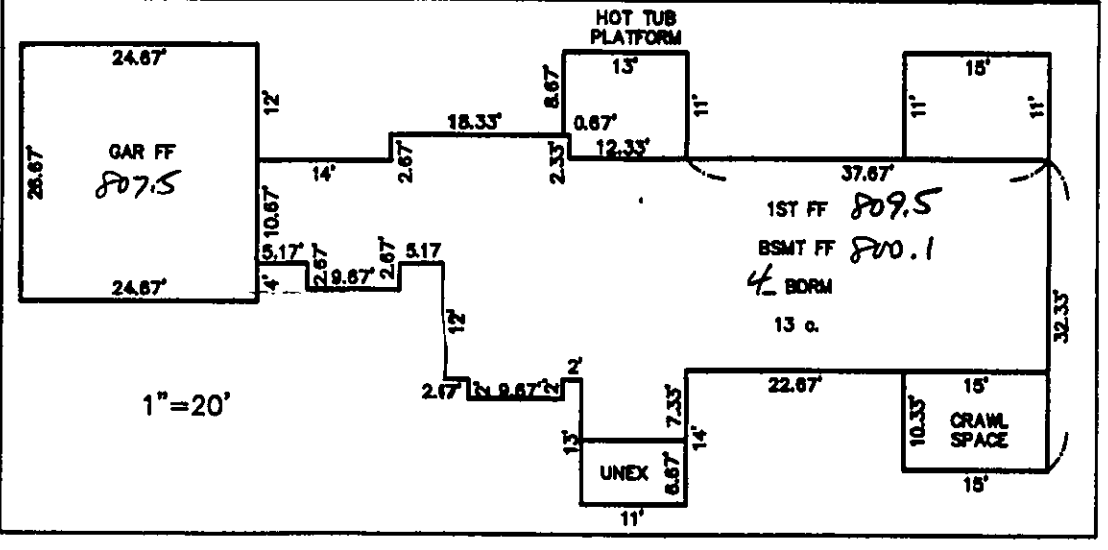

I CERTIFY THIS SEWAGE SYSTEM DESIGN MEETS THE MINIMUM REQUIREMENTS ESTABLISHED BY THE LCGHD IN THE HSTS GUIDANCE MANUAL AND THE REQUIREMENTS AND RECOMMENDATIONS OF THE SYSTEM MANUFACTURER.

Harry Jones 6343
Name Reg. No.

LIR = 3.0
4/7
3.0 = 139 LE


babcock, jones and associates, inc
CIVIL ENGINEERS - SURVEYORS - LAND PLANNERS
PAINESVILLE OHIO 44077

DATE 10/5/04
DESIGN BY HJ
DRAWN BY BC
APPROVED BY HJ


SITE PLAN
FOR
JOSH ROSENHECK
CONLEY ROAD PARCEL NO. 8A-10-46-69
CONCORD TOWNSHIP LAKE COUNTY STATE OF OHIO

SCALE 1"=50'
JOB NO 03-314
SHEET 1 OF 2

AERMOTOR MODEL: TEP20-50-115
1.25" DISCHARGE 1/16" MAX. SOLIDS HANDLING
0.5 HORSEPOWER 1 PHASE
115 VOLT 60 HZ
12.0 AMPS MULTI-STAGE CENTRIFUGAL

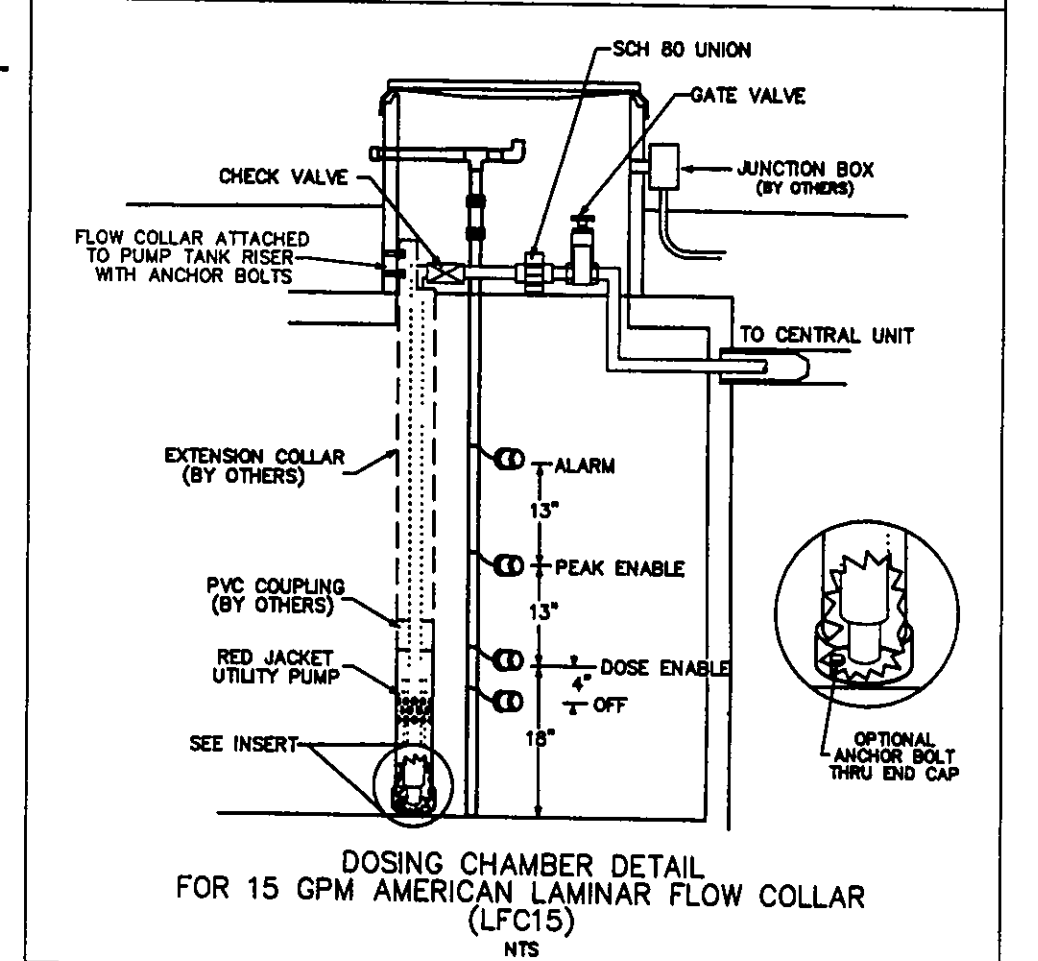

Erosion and Sediment Control Schedule
Ingress-Egress
A stone access drive complete with under lying geo-textile fabric (20 feet wide and 50 feet long) for ingress and egress at the site shall be installed. This drive shall be the only entrance and exit to the site.
Silt Fence
A silt fence shall be installed prior to any earthwork activities at the site in the locations shown on the site plan as well as along the front of any lot that slopes towards the street.
Temporary Seeding
Disturbed areas of the site that are to remain idle for more than twenty-one(21) days shall be properly seeded and straw mulched within seven(7) days of completion of initial grading.
Temporary seeding and mulching as a thirty(30) foot strip of the entire front of the lot shall be maintained on the site once initial grading is complete.
Stabilization of critical areas within fifty(50) feet of any stream or wetland shall be complete within two(2) days of the disturbance if the site is to remain inactive for longer than fourteen(14) days.
Mulching
Straw-mulch shall be applied at a rate of 1 bale per every ten (10) feet of curb, at a width of thirty(30) feet to the entire length of the lot. Wood chips may also be used but must be spread at a minimum depth of four inches over the thirty-foot width and must be accompanied by a properly installed silt fence.
Maintenance
Erosion and sediment controls shall be inspected every seven(7) days or within 24 hours of a 0.5" or greater rainfall event. Necessary repairs shall be made at this time.

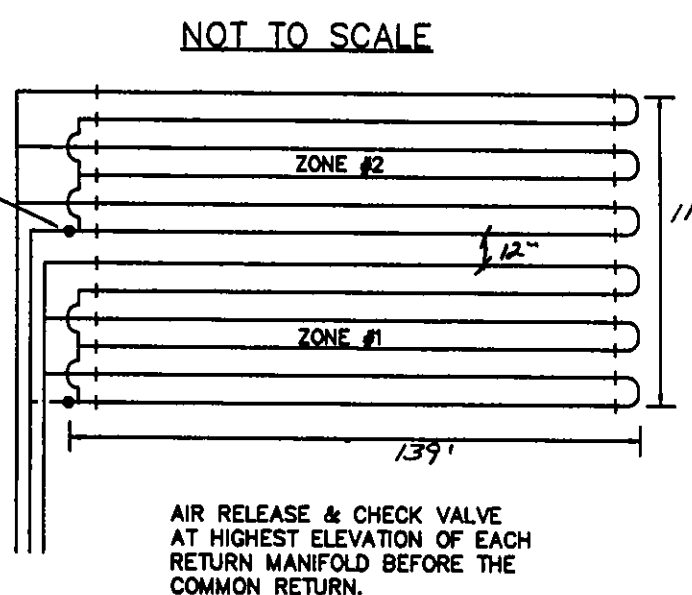

EACH LATERAL WILL FEED FROM THE LOWER RUN IN THE LATERAL AND RETURN FROM THE HIGHER RUN IN THE LATERAL.

TBM MONUMENT
ELEV=810.85

Stormwater Management
Approved as shown and/or
JAMES H. GILLS, P.E.
County Drainage Engineer
By J.S. Date 6/1/06
INSTALL LEVEL SPEEDER
PER SPECIFICATION



EXISTING UTILITIES NOTE:
THE SIZE AND LOCATION, BOTH HORIZONTAL AND VERTICAL OF THE UNDERGROUND UTILITIES SHOWN HEREON HAVE BEEN OBTAINED BY A SEARCH OF AVAILABLE RECORDS.
VERIFICATION BY FIELD OBSERVATION HAS BEEN CONDUCTED WHERE PRACTICAL, HOWEVER, BABCOCK, JONES AND ASSOCIATES, INC. DOES NOT GUARANTEE THE COMPLETENESS NOR ACCURACY THEREOF.

REV NO.	DESCRIPTION	DATE	BY	CHK'D
1	REVISED SITE PLAN	11/1/04	B.P.	H.J.
2	NEW FOUNDATION PLAN & DRIP SYSTEM	6/5/05	B.P.	H.J.
3	REVISED DRIP SYS LENGTH TO 139	4/24/06	H.J.	H.J.
4	REVISED DWG TO 1"=50' PER L.C.H.D.	4/28/06	B.P.	H.J.

Drip distribution area has been field verified and protected with marking tape
Plans submitted to LCGHD and meet design criteria
Hydraulic calculations verified and accurate

Date 5/10/6
Name DJL
Date 5/10/6
Name DJL
Date 5/10/6
Name DJL