

- ENGINE ROOM
FRODOLOP
T-CROCODILE TAIL WALL
E-ENGINE ROOM TAIL WALL

REFERENCES:

- 1.) LITTLE MOUNTAIN COUNTRY CLUB SUBDIVISION
PLAT VOLUME 39, PAGE 13
DATED: JANUARY 5th, 2001
- 2.) COUNTY ROAD RECORDS
- 3.) LAKE COUNTY GIS
- 4.) FORESIGHT SUBDIVISION PLANS


NOTES:

UTILITY INFORMATION
TAKEN FROM COUNTY
IMPROVEMENT PLANS

UTILITY LATERALS
MUST BE FIELD VERIFIED
BEFORE CONSTRUCTION

"I, the undersigned hereby certify that this topography, indicated by 6", 1' or 2' contours, and elevations shown hereon represent an actual field survey made by me on the 15th day of JUNE, 20 04 and that the elevations were taken at appropriate intervals and that as of that date they existed as indicated hereon."

DSU 6-8-06
Name P.S. Reg.# 8247

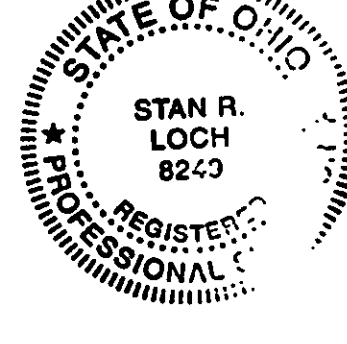

CURVE TABLE						
CURVE	DELTA	LENGTH	RADIUS	TANGENT	BEARING	CHORD
C11	31°42'18"	166.01'	300.00'	85.19'	N73°06'21"W	163.90'
C125	21°22'04"	123.07'	330.00'	62.26'	N78°16'38"W	122.16'

THOMAS + DAWN SCHEETZ
#2046033689

NOTE: 1) WITHIN THE GEOTEKSTILE GRID REINFORCEMENT AREAS BEHIND BOTH TIENS OF THE VERTS-LOCK WALLS, THERE SHALL BE NO BURIED UTILITIES AND FUTURE EXCAVATIONS 1' BELOW FINISHED GRADE.

**LAKE COUNTY ENGINEER'S OFFICE
580 BLACKBROOK ROAD
FAIRBURY, OHIO 44137**

APPROVED FOR CONSTRUCTION OF FBO

Checking is only for general conformance with the design concept of the project and general compliance with the information given in the contract documents. Any action shown is subject to the requirements of the plans and specifications. The contractor is responsible for dimensions which shall be confirmed and controlled at the job site; for methods, processes and techniques; construction; coordination of his work with that of all other trades; and the satisfactory performance of his work.

3RD. SUBMISSION
Stormwater Management Plan
Approved as shown and/or noted
JAMES R. GILLS, P.E.
County Drainage Engineer.

By L.S. Date 5/22/0

1

2ND SUBMISSION
APPROVED 2/2/10

APPROVED 2/20/09
Stormwater Management Plan

Approved as shown and/or noted

JAMES R. GILLS, P.E.
County Drainage Engineer

By L.S. Date 6/29/

AS NOTED IN LAKE COUNTY ENGINEER'S
6/28/06 MEMO TO JERRY FLANIK

5/4/0

SITE PLAN FOR
BRUCE BEATY
BEING SUBLOT 80 IN THE
LITTLE MOUNTAIN COUNTRY CLUB SUBDIVISION
10515 CROOKED STICK DRIVE
TOWNSHIP OF CONCORD
COUNTY OF LAKE, STATE OF OHIO

38879 MENTOR AVENUE SUITE A
WILLOUGHBY OHIO 44094
440-602-9071

FAX 602-940

AZTECH
ENGINEERING and SURVEYING
Civil Engineering · Land Surveying

HORIZ. SCALE 1" = 20'

VERT SCALE

DRAWN BY CL

DATE: 6/8/06

CHECKED BY:

DRAWING NO. 141564

141564

SHEET 1 OF 3

20-179-80