


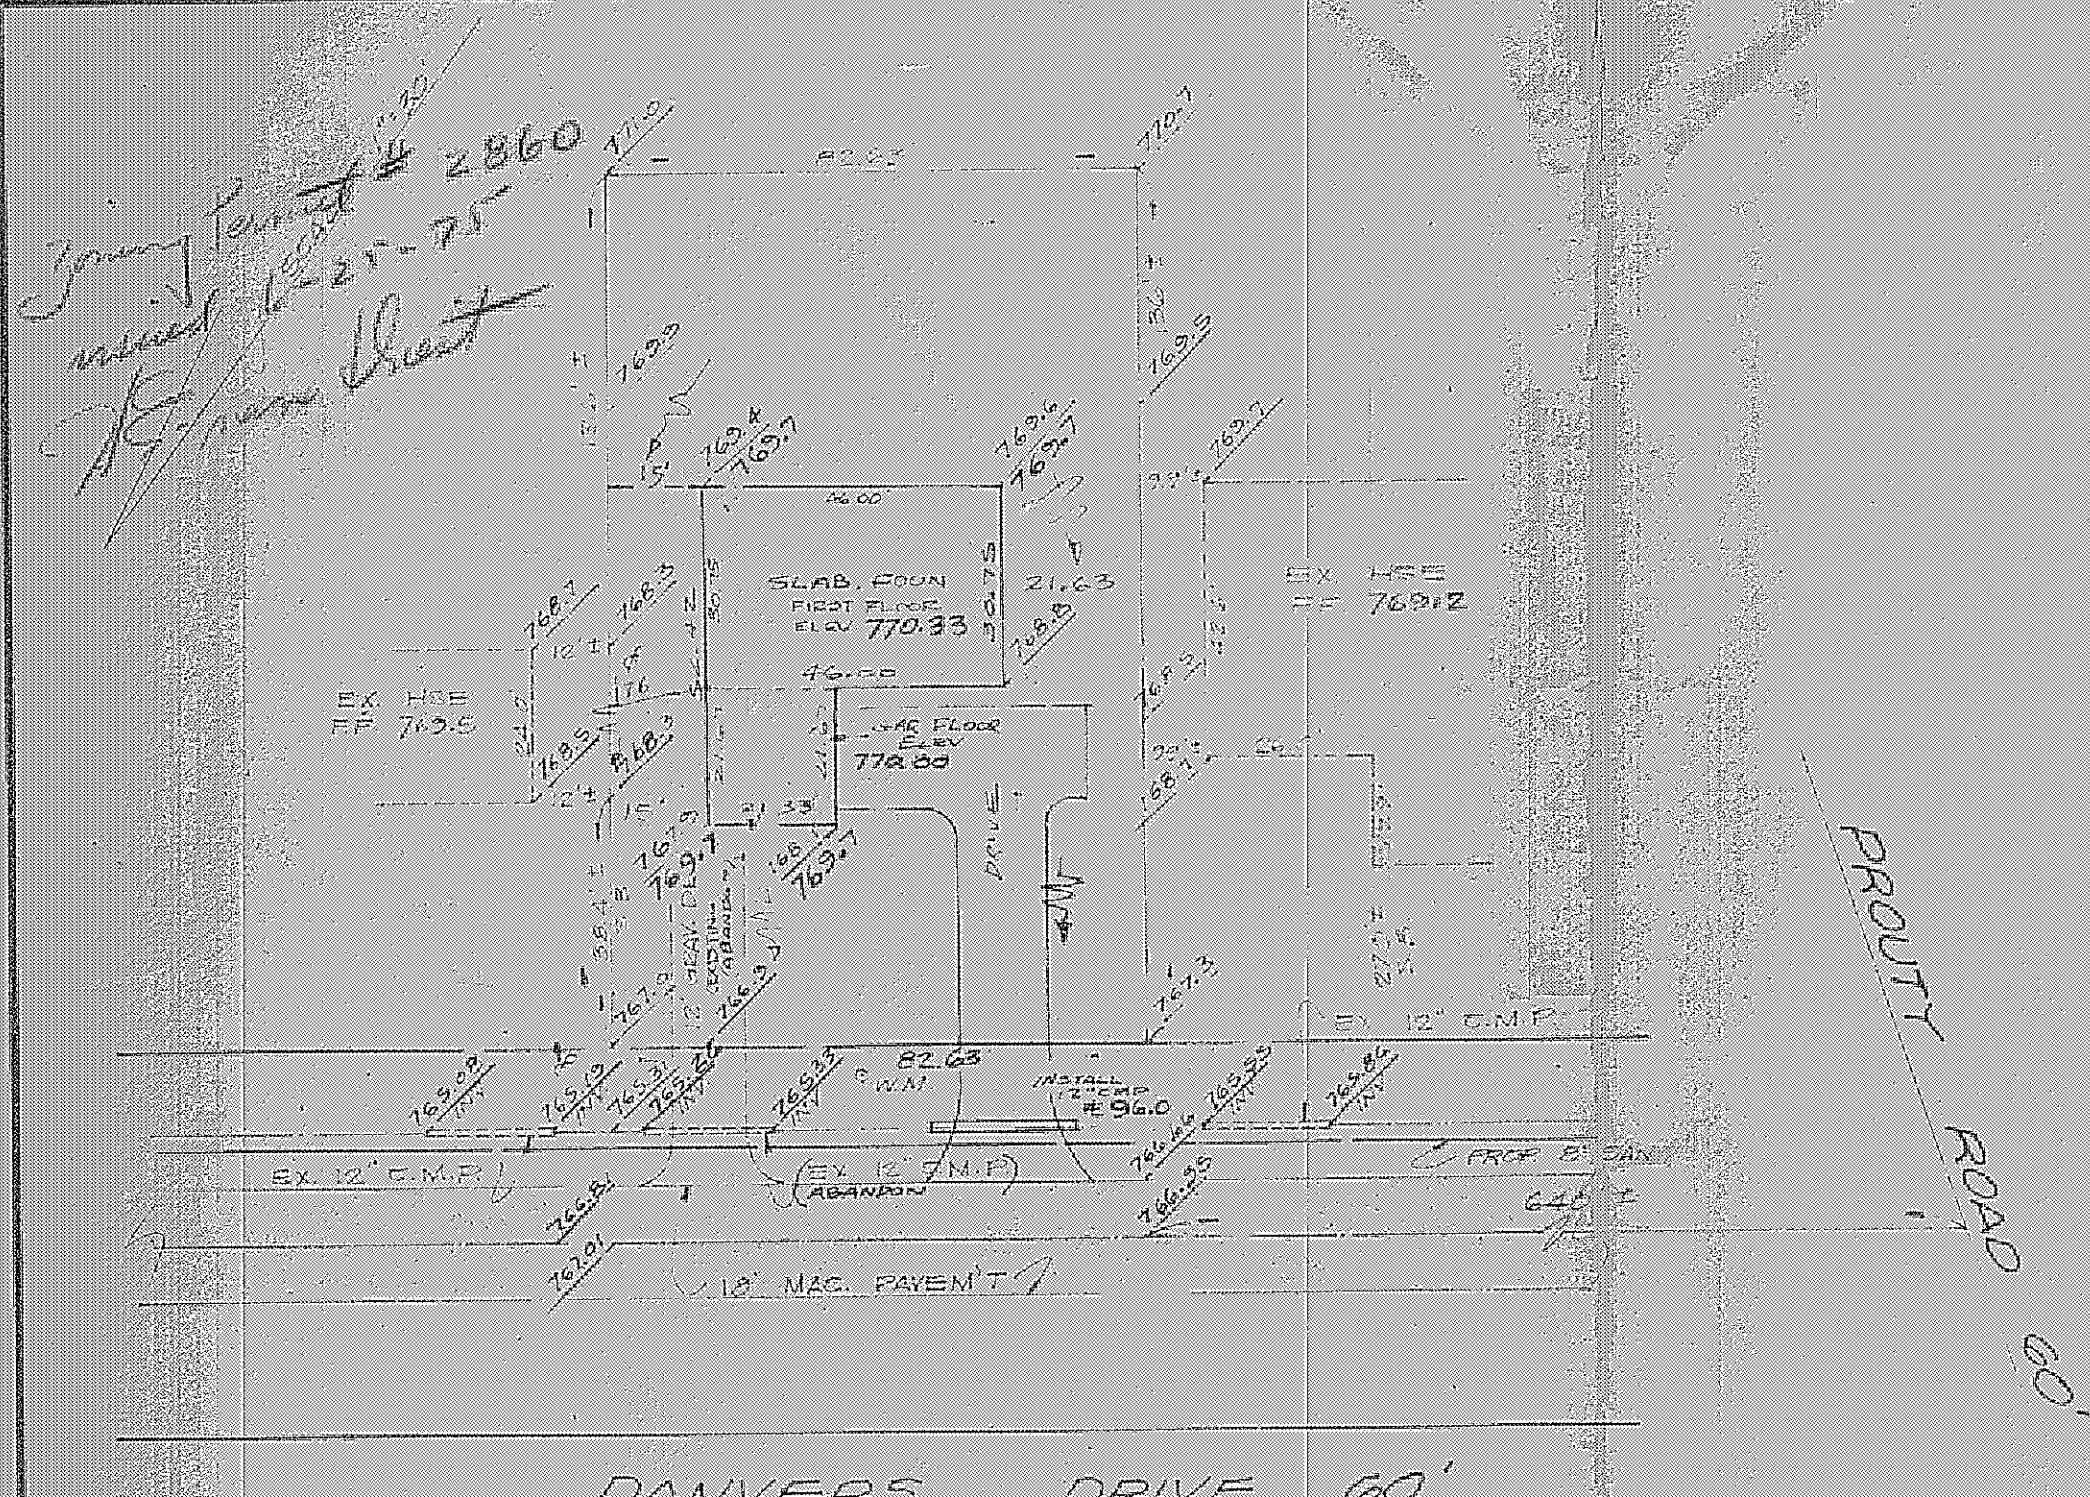

*Joining Parcel # 2860
mined lot 25-75
to new street*

Grading Plan Approved
as shown and/or noted
THOMAS P. GILLES, P.E.
Lake County Engineer

By JWR Date 6-27-75

"AS BUILT" CERTIFICATION
I, HEREBY CERTIFY THAT THE CIRCLED GRADES ARE EXISTING FINISH
GRADES CHECKED IN FIELD ON 19 BY
SURVEYING AND ARE CORRECT TO THE BEST OF MY KNOWLEDGE AND BELIEF.

REGISTERED SURVEYOR REG. NO.

SITE PLAN

CONCORD TOWNSHIP LAKE COUNTY, OHIO

for: KEN SOWUL
CLIENT OWNER

ADDRESS STREET CITY ZIP

SUBDIVISION NAME		LOT	TRACT
VOL. PG.		VOLUME	PAGE
SUBLOT NO. STREET		PERM. PARCEL NO.	STREET

LEGEND

SANITARY MANHOLE	---	WATER VALVE (GAS)	---
STORM MANHOLE	---	WATER METER (GAS)	---
INLET OR CATCH BASIN	---	AS BUILT ELEVATION	---
HYDRANT	---		
EXISTING CONTOURS	---	INDICATES	
PROPOSED CONTOURS	---	DIRECTION OF	
EXIST. ELEV. 100.0		SURFACE DRAINAGE	
100.0 PROP. ELEV.			

REMARKS

ALL BOUNDARY DATA SHOWN WAS OBTAINED FROM (DEEDS, RECORDED SUBDIVISION PLAT OR OTHER PUBLIC RECORDS)

LOCATIONS AS SHOWN OF ADJACENT WELLS AND SEPTIC TANKS OBTAINED FROM LAKE COUNTY HEALTH DEPARTMENT

DESIGN CERTIFICATION

THIS PLAT WAS PREPARED BY ME, AND IS CORRECT
TO THE BEST OF MY KNOWLEDGE AND BELIEF

Richard B. Bick PS #5244
NAME SURVEYOR REGISTRATION NO.

CHECK LIST

NO. OF BEDROOMS	WATER MAIN SIZE, LOCATION
DIMENSIONS	SAN. SEWER SIZE & GR. LOC.
BEARINGS	SAN. MH. CAST. ELEV. INV. ELEV.
TIE TO NEAREST STREET	SAN. CONN. SIZE, LOC. DEPTH
SUBLOT NO. PARCEL NO.	STORM SEWER SIZE & GR. LOC.
SURROUNDING OWNERS	STORM MH. CAST. ELEV. INV. ELEV.
BLDG. DIMENSIONS FIN. GR.	PAV'T TYPE GRADE CURBS
BLDG. TIES FL'R. GRADES	GAS LINE LOC. SIZE PRESSURE
APRON TYPE WIDTH THICKNESS	SEPTIC TANK LOCATION & DUPLICATION AREA
SIDEWALK TYPE WIDTH THICKNESS	WELL LOCATION
CULVERT TYPE DIA. LENGTH	ISOLATION RADIUS FROM WELL
ROCK OUTCROPPINGS	

REVISIONS			PLAN PREPARED BY:	
NO.	DATE	BY	DEBEVEC-SALO & ASSOCIATES, INC.	
1	May 1	JTB	130 EAST JACKSON ST. PAINESVILLE, OHIO	
2				
3			DRAWN BY <u>JTB</u>	SCALE <u>1"=30'</u>
4			CHK'D <u>JTB</u>	DATE <u>4-8-75</u>
5			CREW CHIEF <u>JTB</u>	PHONE NO. <u>352-9250</u>
			DRAWING NO. <u>#4435</u>	