


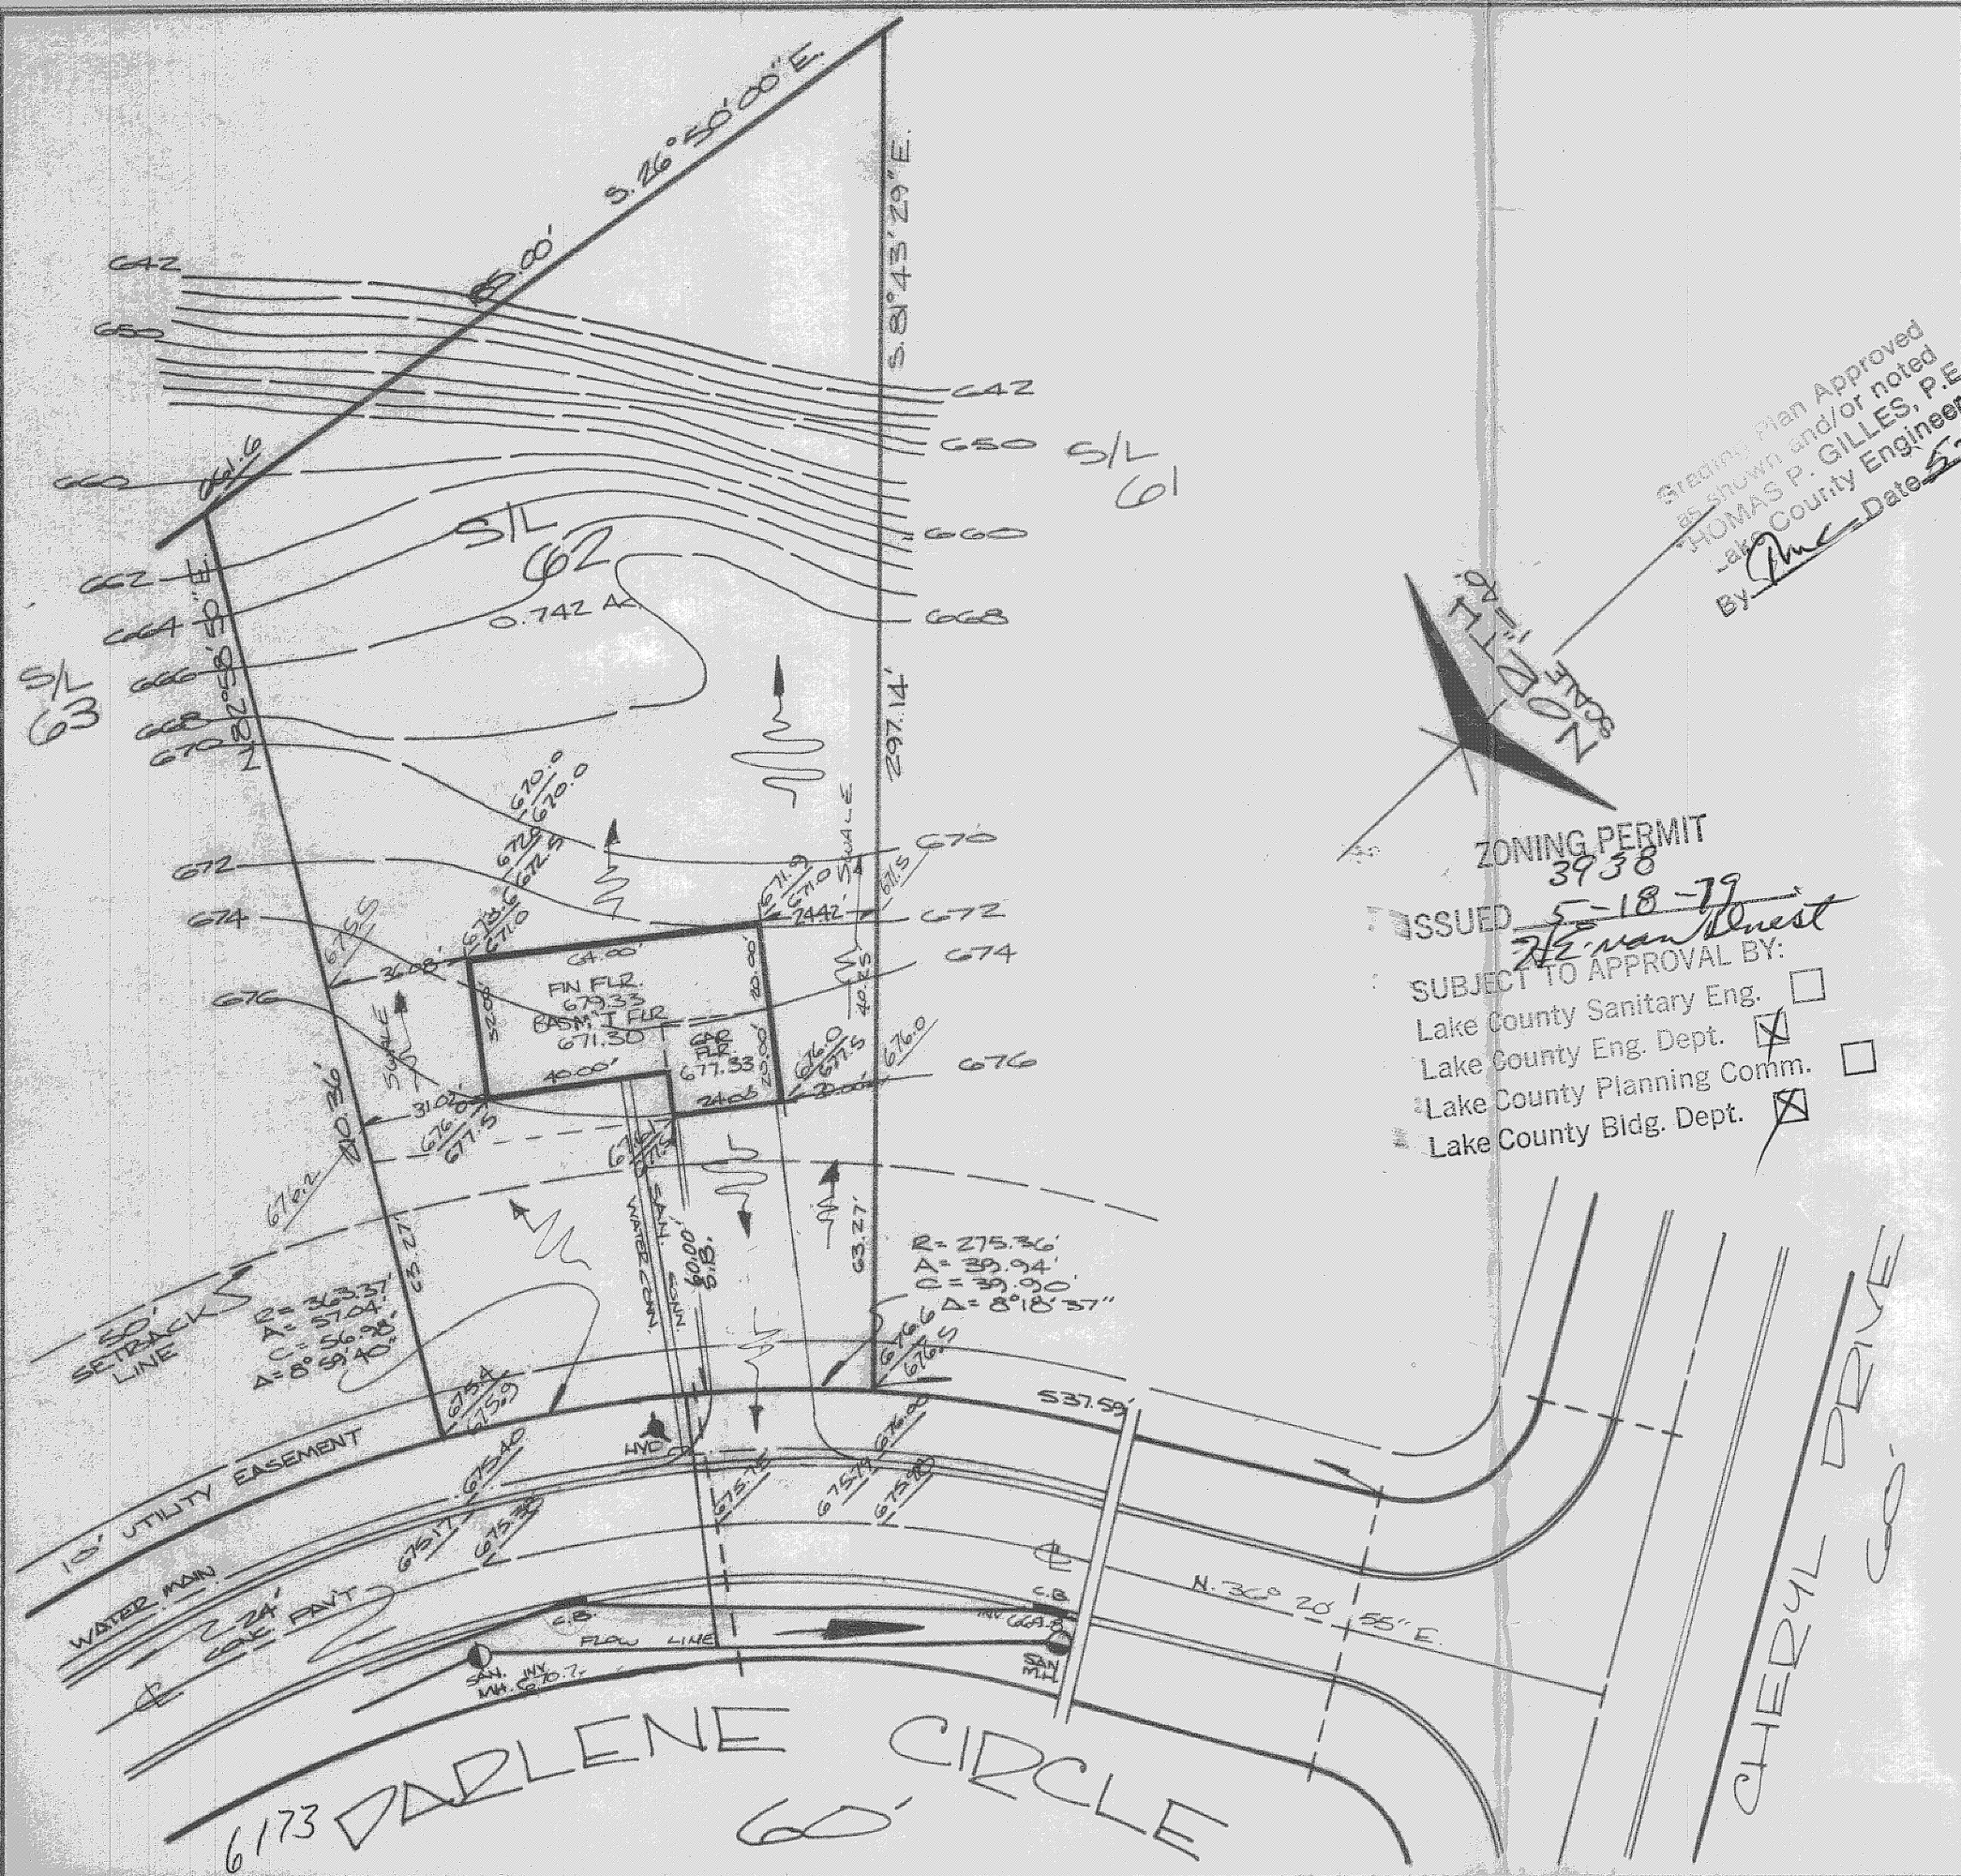

Tom Reed **SITE PLAN**
for WM. E. YOUNG
CLIENT OWNER
63 NORTH PARKWAY DRIVE, EASTLAKE, OHIO
ADDRESS STREET CITY

62 CONCORD KELLER X 13
SUBLOT NO. SUBDIVISION NAME VOL. PAGE
62 CONCORD TWP, LAKE COUNTY OHIO
LOT, TRACT

REMARKS
ALL BOUNDARY DATA SHOWN WAS OBTAINED FROM (DEEDS, RECORDED SUBDIVISION PLAT OR OTHER PUBLIC RECORDS). LOCATIONS AS SHOWN OF ADJACENT WELLS AND SEPTIC TANKS OBTAINED FROM LAKE COUNTY HEALTH DEPARTMENT.

LEGEND
SANITARY MANHOLE --- WATER VALVE (GAS) ---
PROPOSED CONTOURS --- DIRECTION OF SURFACE DRAINAGE
EXIST. ELEV. → 100.0
100.0 ← PROP. ELEV.

CHECK LIST
NO. OF BEDROOMS
DIMENSIONS
BEARINGS
TIE TO NEAREST STREET
SUBLOT NO. PARCEL NO.
SURROUNDING OWNERS
BLDG. DIMENSIONS FIN. GR.
BLDG. TIES FLR. GRADES
APRON TYPE WIDTH THICKNESS
SIDEWALK TYPE WIDTH THICKNESS
CULVERT TYPE DIA., LENGTH
ROCK OUTCROPPINGS
WATER MAIN SIZE, LOCATION
SAN. SEWER SIZE % GR. LOC.
SAN. MH. CAST. ELEV. IN. ELEV.
SAN. CONN. SIZE, LOC. DEPTH
STORM SEWER SIZE % GR. LOC.
STORM MH. CAST ELEV. INV. ELEV.
PAVT TYPE GRADE CURBS
GAS LINE LOC. SIZE PRESSURE
SEPTIC TANK LOCATION & DUPLICATION AREA
WELL LOCATION
ISOLATION RADIUS FROM WELL

DESIGN CERTIFICATION
THIS PLAN WAS PREPARED BY ME, AND IS CORRECT TO THE BEST OF MY KNOWLEDGE AND BELIEF.
Richard J. B. J. PS# 5244
NAME SURVEYOR REGISTRATION NO.

"AS BUILT" CERTIFICATION
I HEREBY CERTIFY THAT THE CIRCLED GRADES ARE EXISTING GRADES OBTAINED ON THE SITE ON 19 79 AND ARE CORRECT TO THE BEST OF MY ACKNOWLEDGMENT AND BELIEF.

LAND DESIGN consultants, inc.
9613 JACKSON STREET, MENTOR, OHIO 44060
TELEPHONE (216) 951-6872 or 354-6646

1		DRAWN BY R.S.B. J.	SCALE 1"=40'	DRAWING NO.
2		CHK'D. R.A.H.	DATE 4/20/79	296-62
3		CREW CHIEF R.A.H.	APP'D.	