


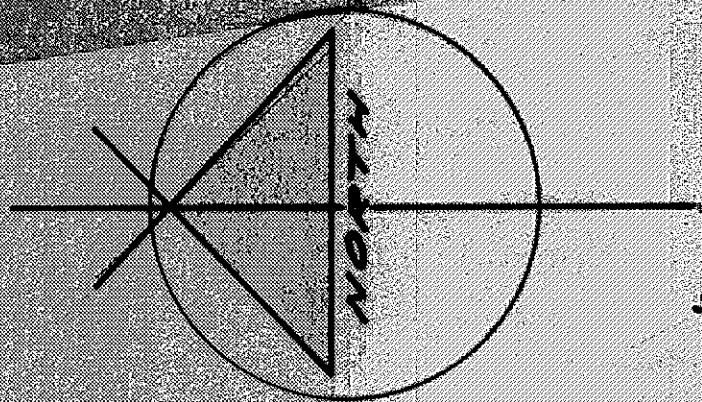

S 26° 50' 00" E 39.47'

SITE PLAN

FOR


WILLIAM BORER

OF A PARCEL OF
LAND KNOWN AS S/2 61
IN THE CONCORD KELLOGG
PARK ESTATES SUBDIVISION



CONCORD TOWNSHIP
LAKE COUNTY OHIO

SCALE 1" = 30'

JUNE 1979

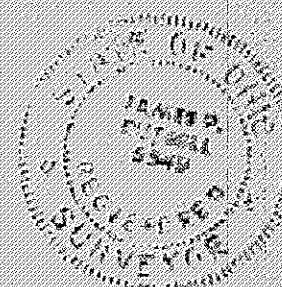

James P. Russell

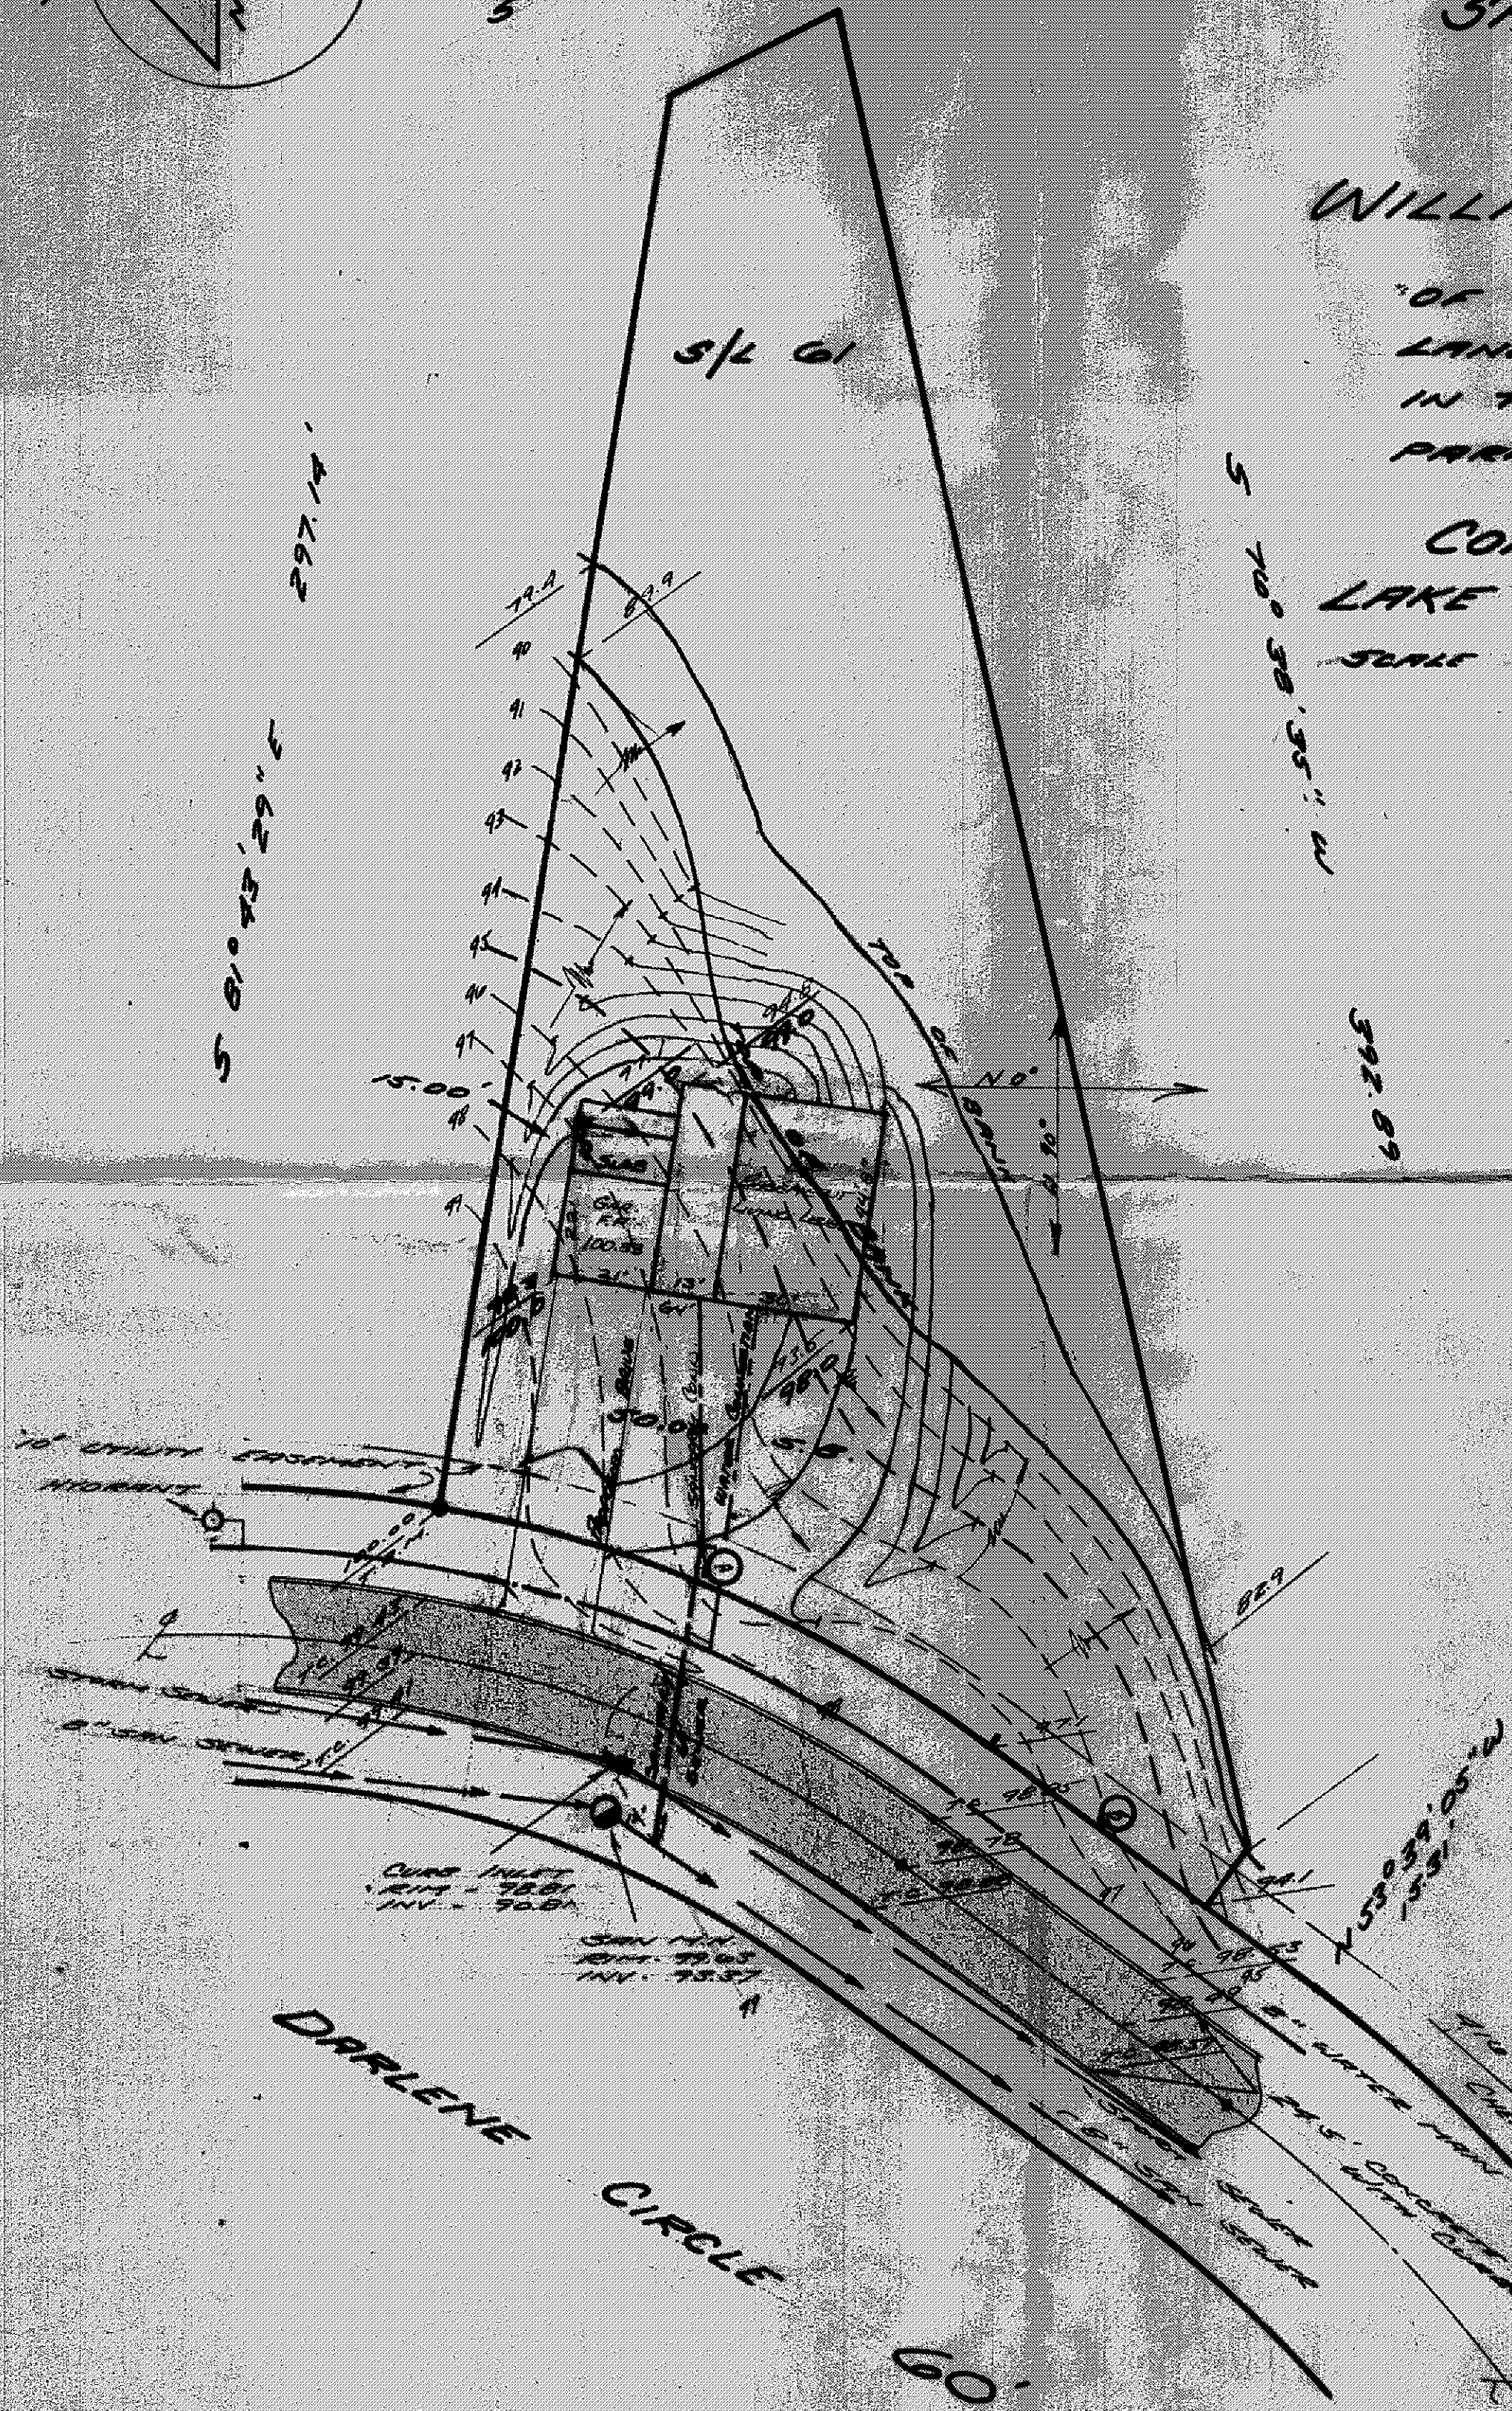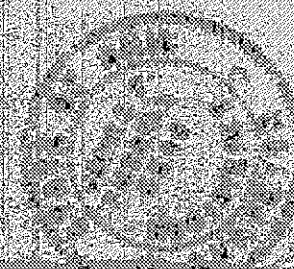

CURVE ②
N 23° 19' 01" E
A = 125.20' C = 124.18'
DISTANCE ②
N 30° 20' 55" E
56.66'

Grading Plan Approved
as shown and/or noted
THOMAS P. GILLES, P.E.
Lake County Engineer
By Me Date 8-8-79

ZONING PERMIT
3740
ISSUED 7-9-79
SUBJECT TO APPROVAL BY:
Lake County Sanitary Eng. ☐
Lake County Eng. Dept. ☒
Lake County Planning Comm. ☐
Lake County Bldg. Dept. ☒

T.B.M. TOP OF IRON PIN
AT NORTHWEST CORNER OF S/2 61.
ASSUMED ELEVATION = 100.00