


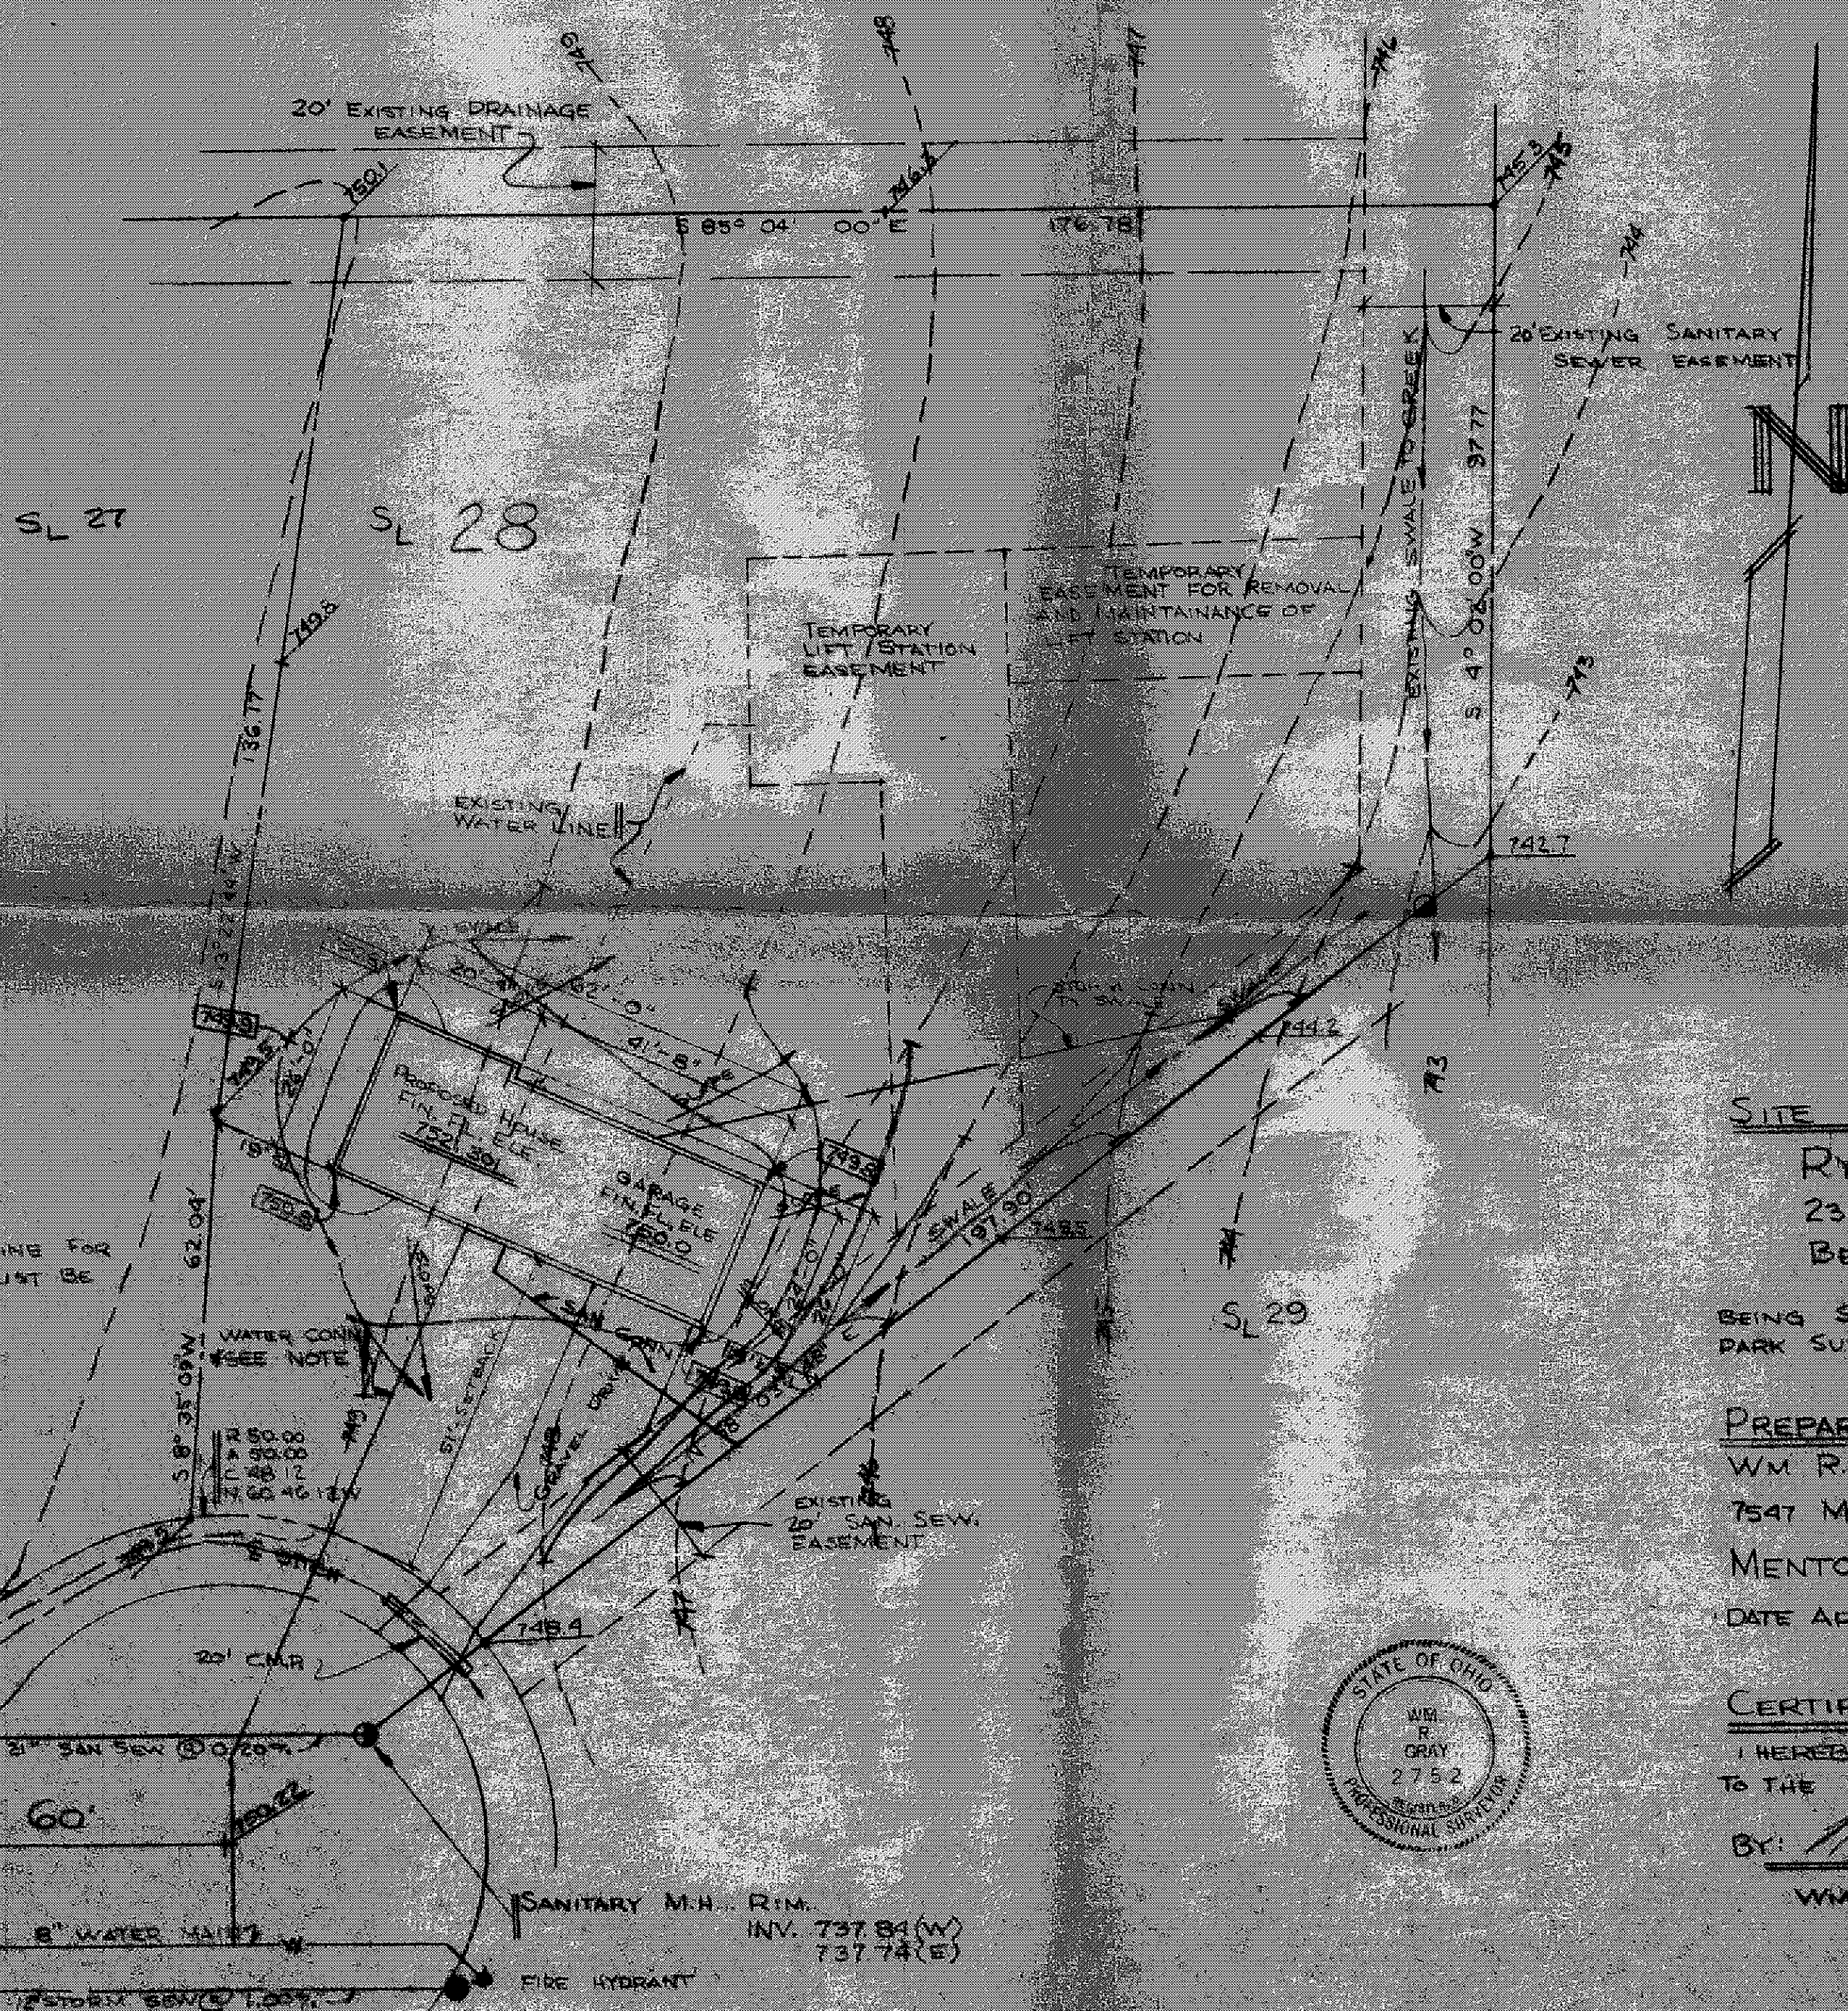

* NOTE:
EXISTING WATER LINE FOR
LIFT STATION MUST BE
MAINTAINED


Grading Plan Approved
as shown and/or noted
THOMAS P. GILLES, P.E.
Lake County Engineer

SITE PLAN FOR:
RYAN HOMES
23600 MERCANTILE RD.
BEACHWOOD, OHIO.

BEING SUBLOT NO 28 IN THE CREEKVIEW
PARK SUBDIVISION, CONCORD, OHIO

PREPARED BY:
WM R. GRAY ASSOC., INC.
7547 MENTOR AVENUE
MENTOR, OHIO.
DATE APRIL 26, 1976

**ZONING
PERMIT**
Approved #1226
RSH

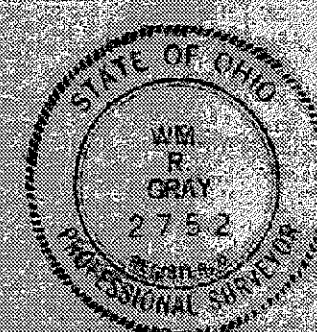

CERTIFICATION:
I HEREBY CERTIFY THAT THIS PLAT IS CORRECT
TO THE BEST OF MY KNOWLEDGE.
BY: WM R. Gray
WM. R. GRAY REG. SURV. No. 2752