


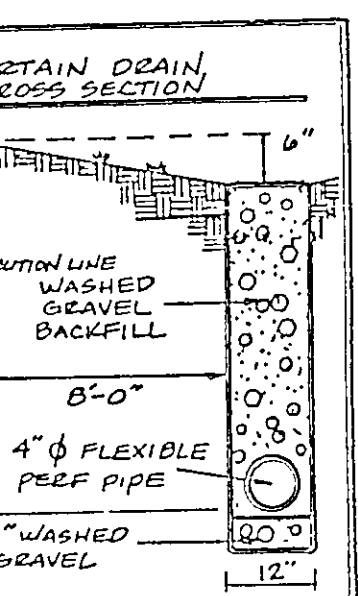

STATE OF
HARRIS
JONES
S-63
REGIST
SURVE