


S&L 101
ELEV. 100.43
ELEV. 93.29
ELEV. 93.07 (CRCP)

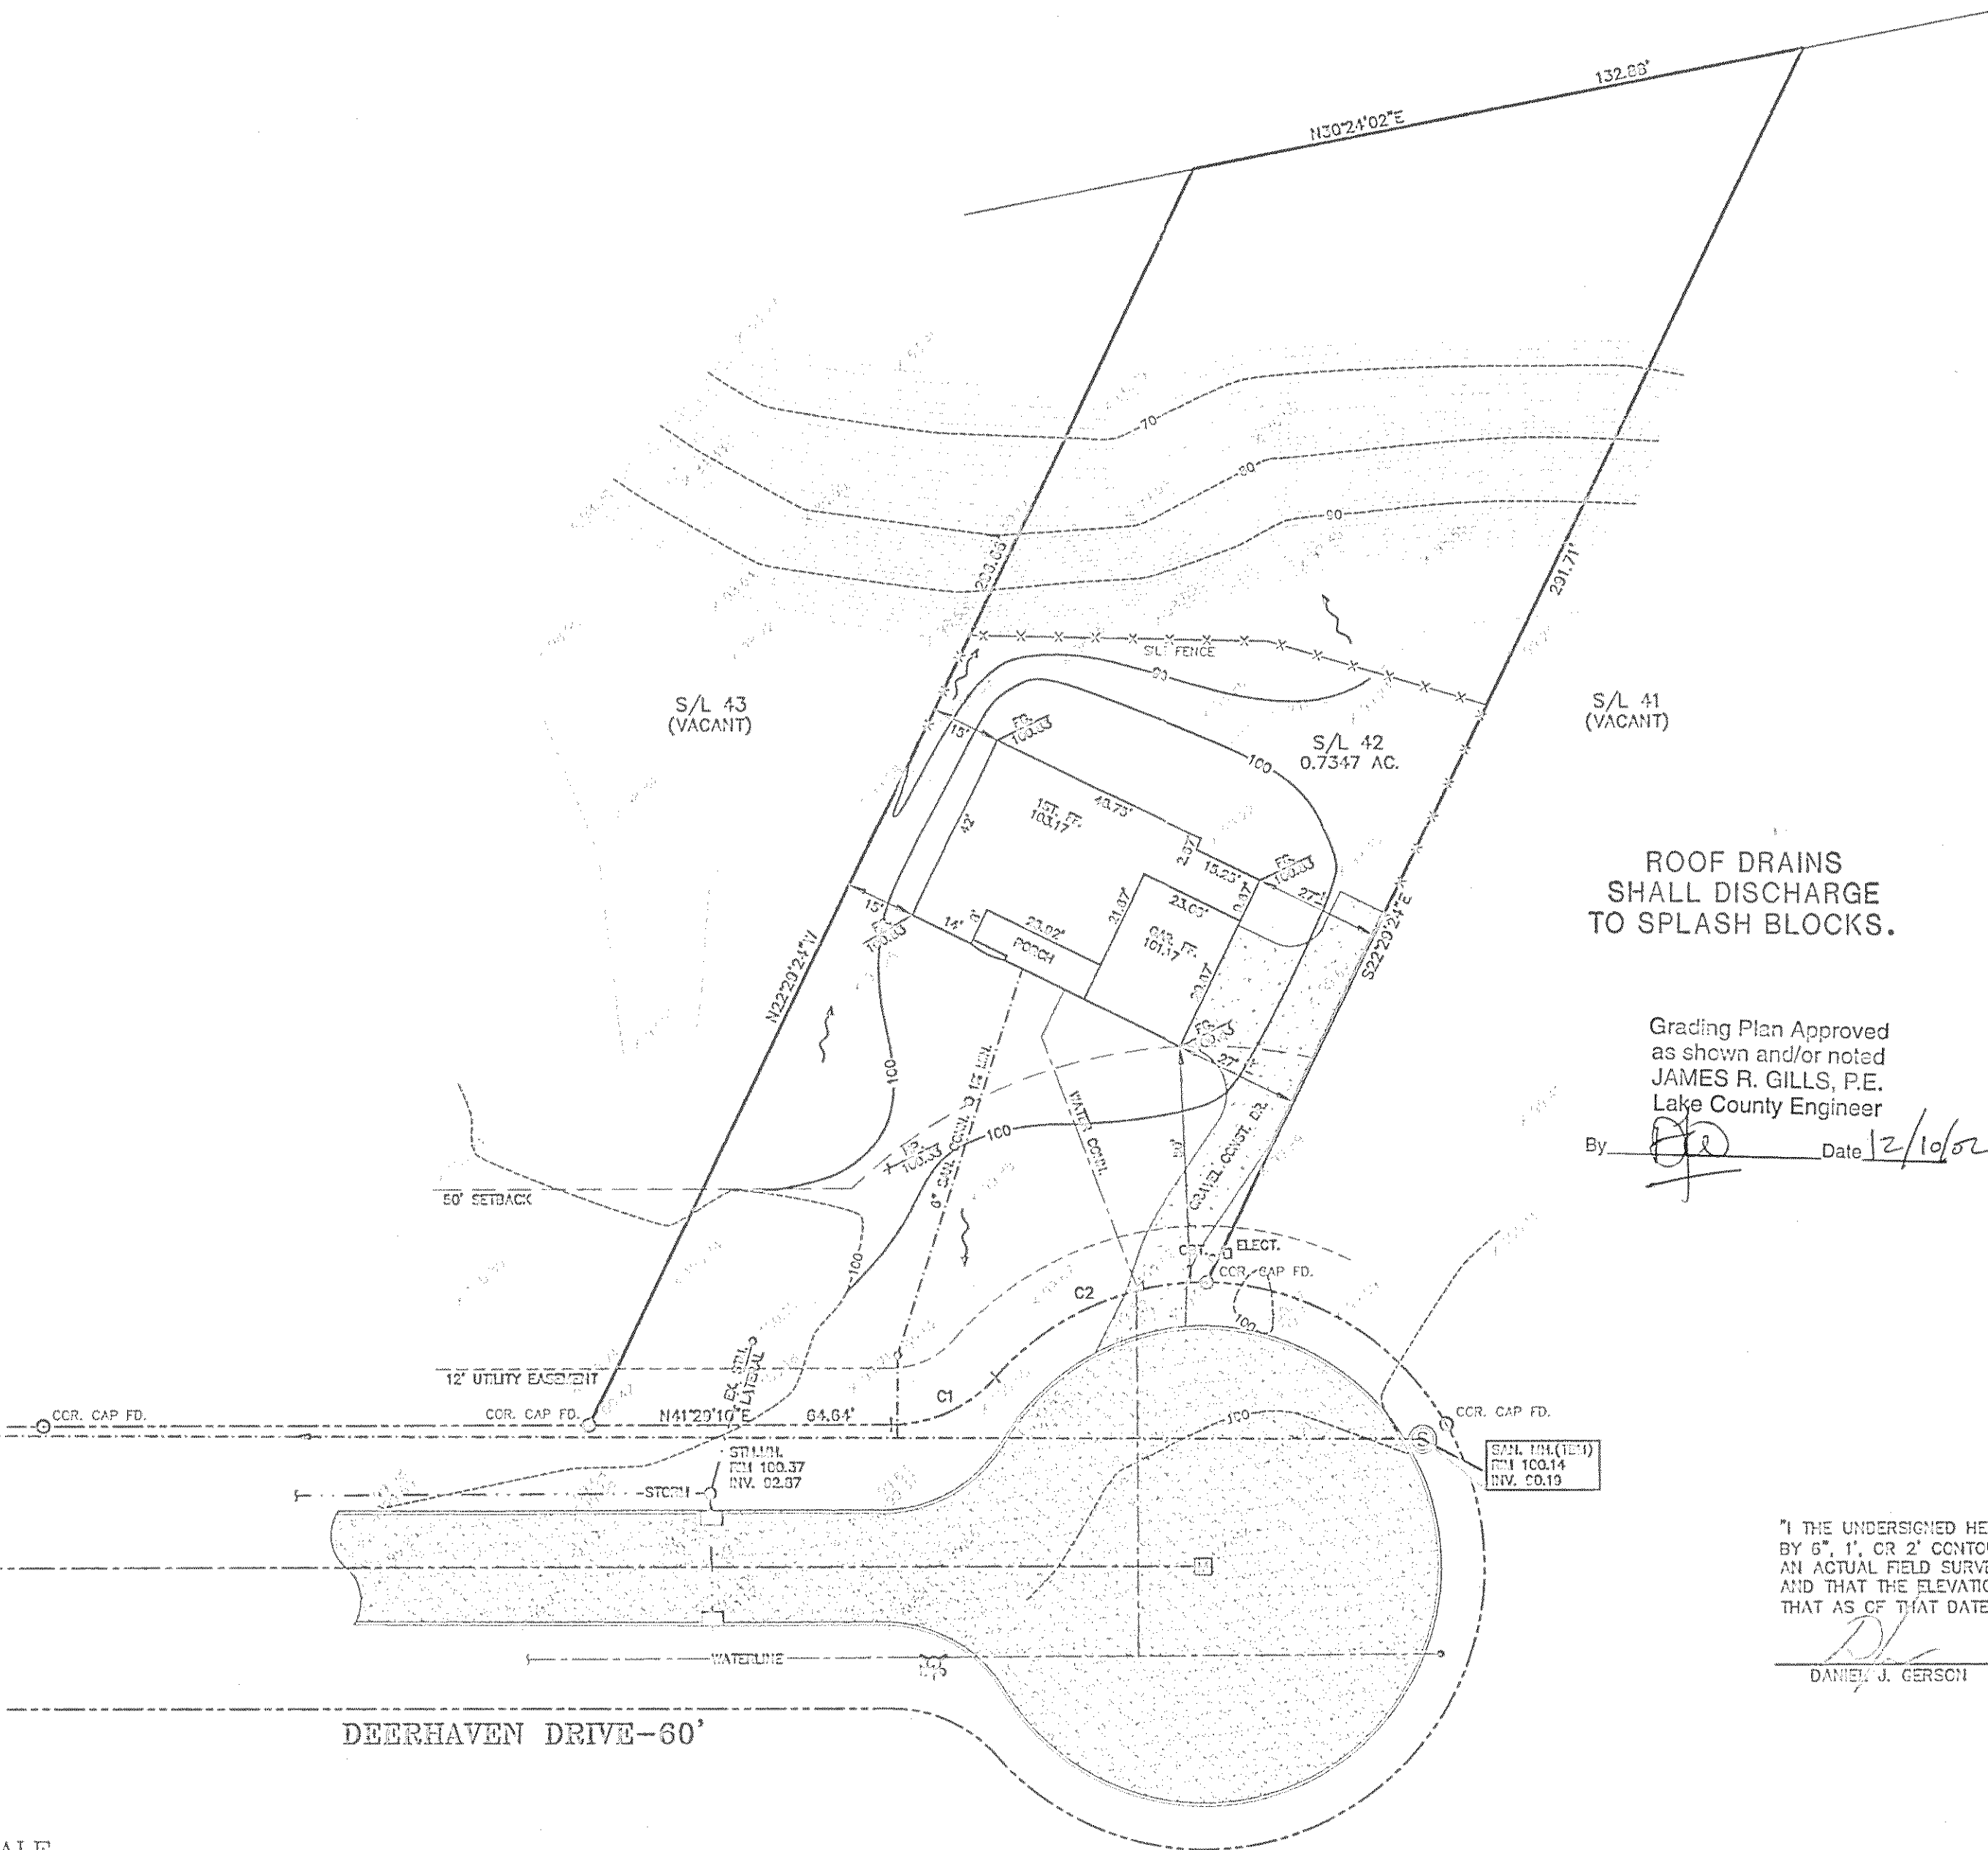

ROOF DRAINS
SHALL DISCHARGE
TO SPLASH BLOCKS.

Grading Plan Approved
as shown and/or noted
JAMES R. GILLS, P.E.
Lake County Engineer
By: [Signature] Date 12/10/02


CONCORD TOWNSHIP ZONING OFFICE

ZONING PERMIT # 1102-10835

ISSUED 11-6-2002

SUBJECT TO APPROVAL BY:

- ☒ Lake Co. Sanitary Engineer
- ☒ Lake Co. Eng. Dept.
- ☐ Lake Co. Planning Comm.
- ☒ Lake Co. Building Dept.
- ☒ Lake Co. Soil & Water Cons. Dist.

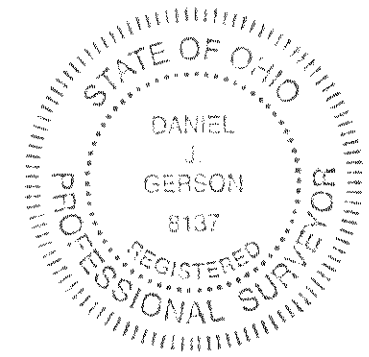

"I, THE UNDERSIGNED HEREBY CERTIFY THAT THIS TOPOGRAPHY, INDICATED BY 6", 1", OR 2" CONTOURS, AND ELEVATIONS SHOWN HEREON REPRESENT AN ACTUAL FIELD SURVEY MADE BY ME ON THE 2 DAY OF DEC, 2002 AND THAT THE ELEVATIONS WERE TAKEN AT APPROPRIATE INTERVALS AND THAT AS OF THAT DATE THEY EXISTED AS INDICATED HEREON."

[Signature] PS 8137
DANIEL J. GERSON REG. NO.

NOTE: ALL DISTURBED AREAS SHALL
BE TEMPORARY SEEDDED.
CONTRACTOR TO VERIFY EXISTING
UTILITY LOCATIONS BEFORE
STARTING CONSTRUCTION.

C1: R=30.00' L=25.23' TAN=13.42' DEL=48'11"23" CH=24.49' N17°23'29"E
C2: R=60.00' L=51.31' TAN=27.34' DEL=48'59"56" CH=49.76' S17°47'45"W

THE MATEJKA FAMILY	TITLE	SITE PLAN		
		S/L 42 ELLISON CREEK SUB.		
		CONCORD TOWNSHIP-LAKE COUNTY-OHIO		
SHEET NO.	DATE	DRAWN BY	CHECKED BY	SCALE
	10-3-02	TDR	DUG	1" = 30'

WILLIAM R. GRAY ASSOCIATES, INC.
7519 MENTOR AVE. MENTOR, OHIO 44060
(440) 946-1616