


I CERTIFY THAT THIS PLAN
WAS PREPARED BY ME AND
IS CORRECT TO THE BEST OF
MY KNOWLEDGE AND BELIEF

John C. Skonieczny
REG. SURVEYOR #6356

JOHN C. SKONIECZNY
7739 VIEWMOUNT DR.
PAINESVILLE, OHIO 44077
PH. 352-7742

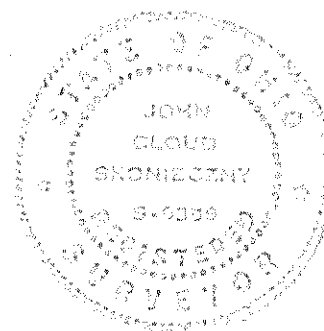

NOTE 1
EXCAVATING CONTRACTOR TO FIELD VERIFY
SERVICE CONNECTION LOCATION AND ELEVATIONS
PRIOR TO BASEMENT EXCAVATION.

- NOTE 1
③ 6" P.V.C., STR. SETTER 01.00% MIN.
④ 6" P.V.C., SAN. SETTER 01.00% MIN.
⑤ 1" WATER CONN. TYPE "A" COPPER

CONCORD TOWNSHIP ZONING OFFICE

ZONING PERMIT # 0504-11593

ISSUED 5/6/04

SUBJECT TO APPROVAL BY:

- ☒ Lake Co. Sanitary Engineer
☒ Lake Co. Eng. Dept.
☐ Lake Co. Planning Comm.
☒ Lake Co. Building Dept.
☒ Lake Co. Soil & Water Cons. Dist.

Stormwater Management Plan
Approved as shown and/or noted
JAMES R. GILLS, P.E.
County Drainage Engineer

By JS Date 05/04

ROOF DRAINS
SHALL DISCHARGE
TO SPLASH BLOCKS.

20' INGRESS/EGRESS EASEMENT

20' INGRESS/EGRESS EASEMENT

160.06'
N. 63°39'00" W.

S/L 62

SITE PLAN FOR: CENDOL CONSTRUCTION

SCALE: 1" = 30'

APPROVED:

DRAWN BY: SWC

DATE: MAR. 04

REVISED:

BEING SUBLT 61 IN THE ELLISON CREEK SUBDIVISION AS RECORDED
IN VOLUME 39 PAGE 17-2 OF THE LAKE COUNTY RECORD OF PLATS
TOWNSHIP OF CONCORD - COUNTY OF LAKE - STATE OF OHIO

JOB# 01-3147

DRAWING NUMBER
01-2053

GRAPHIC SCALE



CALL TOLL FREE 800-362-2764

OHIO UTILITIES PROTECTION SERVICE