

2

510' 15" 27' 30" 27' 30" 27' 30"

SITE PLAN

COLUMBIA TOWNSHIP, LAKE COUNTY, OHIO

FOR: J.L. BETTERLEY BUILDING CO.

ADDRESS: STREET: CITY: ZIP:

OWNER: CLIENT: OWNER:

DATE: 10/15/85
SUBDIVISION: 10/15/85
VOLUME: 10/15/85
PAGE: 10/15/85
SHEET: 10/15/85

Grading Plan Approved
as shown and/or noted
THOMAS P. GILLES, P.E.
Lake County Engineer

By: J.L. BETTERLEY
DATE: 10/15/85
CITY: LAKE COUNTY, OHIO

LEGEND

WATER VALVE (GAS)
WATER METER (GAS)
AS BUILT ELEVATION
HYDRANT
EXISTING CONTOURS
PROPOSED CONTOURS
INDICATES DIRECTION OF SURFACE DRAINAGE

REMARKS

ALL BOUNDARY DATA SHOWN WAS OBTAINED FROM IDEEDS, RECORDED
SUBDIVISION PLAT OR OTHER PUBLIC RECORDS
LOCATIONS AS SHOWN OF ADJACENT WELLS AND SEPTIC TANKS OBTAINED FROM
LAKE COUNTY HEALTH DEPARTMENT

DESIGN CERTIFICATION

THIS PLAT WAS PREPARED BY ME, AND IS CORRECT
TO THE BEST OF MY KNOWLEDGE AND BELIEF.

NAME: J.L. BETTERLEY
SURVEYOR REGISTRATION NO. 10/15/85

CHECK LIST

NO. OF BEDROOMS
DIMENSIONS
SEALINGS
TIE TO NEAREST STREET
SUBJECT NO. PARCEL NO.
SURROUNDING OWNERS
BLDG. DIMENSIONS FIN. GR.
BEDS, THIS PLAN, GRADERS
APPROX. TYPE WIDTH THICKNESS
SIDEWALK TYPE WIDTH THICKNESS
CULVERT TYPE DIA. LENGTH
ROCK OUTCROPPINGS

PLAN PREPARED BY:


BABCOCK • JONES & ASSOCIATES, INC.
PAINESVILLE, OHIO

NO.	DATE	BY
1	10/15/85	HT
2	10/15/85	HT
3	10/15/85	HT
4	10/15/85	HT
5	10/15/85	HT

"AS BUILT" CERTIFICATION

I, HEREBY CERTIFY THAT THE CIRCLED GRADES ARE EXISTING
FINISH GRADES CHECKED IN THE FIELD ON 10/15/85
AND ARE CORRECT TO THE BEST OF MY KNOWLEDGE AND BELIEF.



REGISTERED SURVEYOR REG. NO. 10/15/85

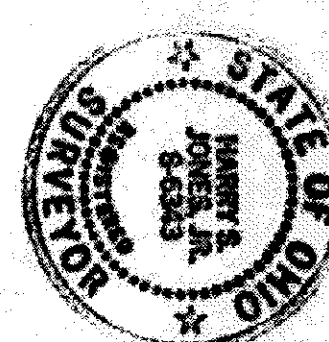

T.B.M. - 10' OF HEADWALL -

5/15 02105091
ELEV. = 1082.75

Subsidence
Sand Filter
Slitter
1087.2
5' 0" 1071.8

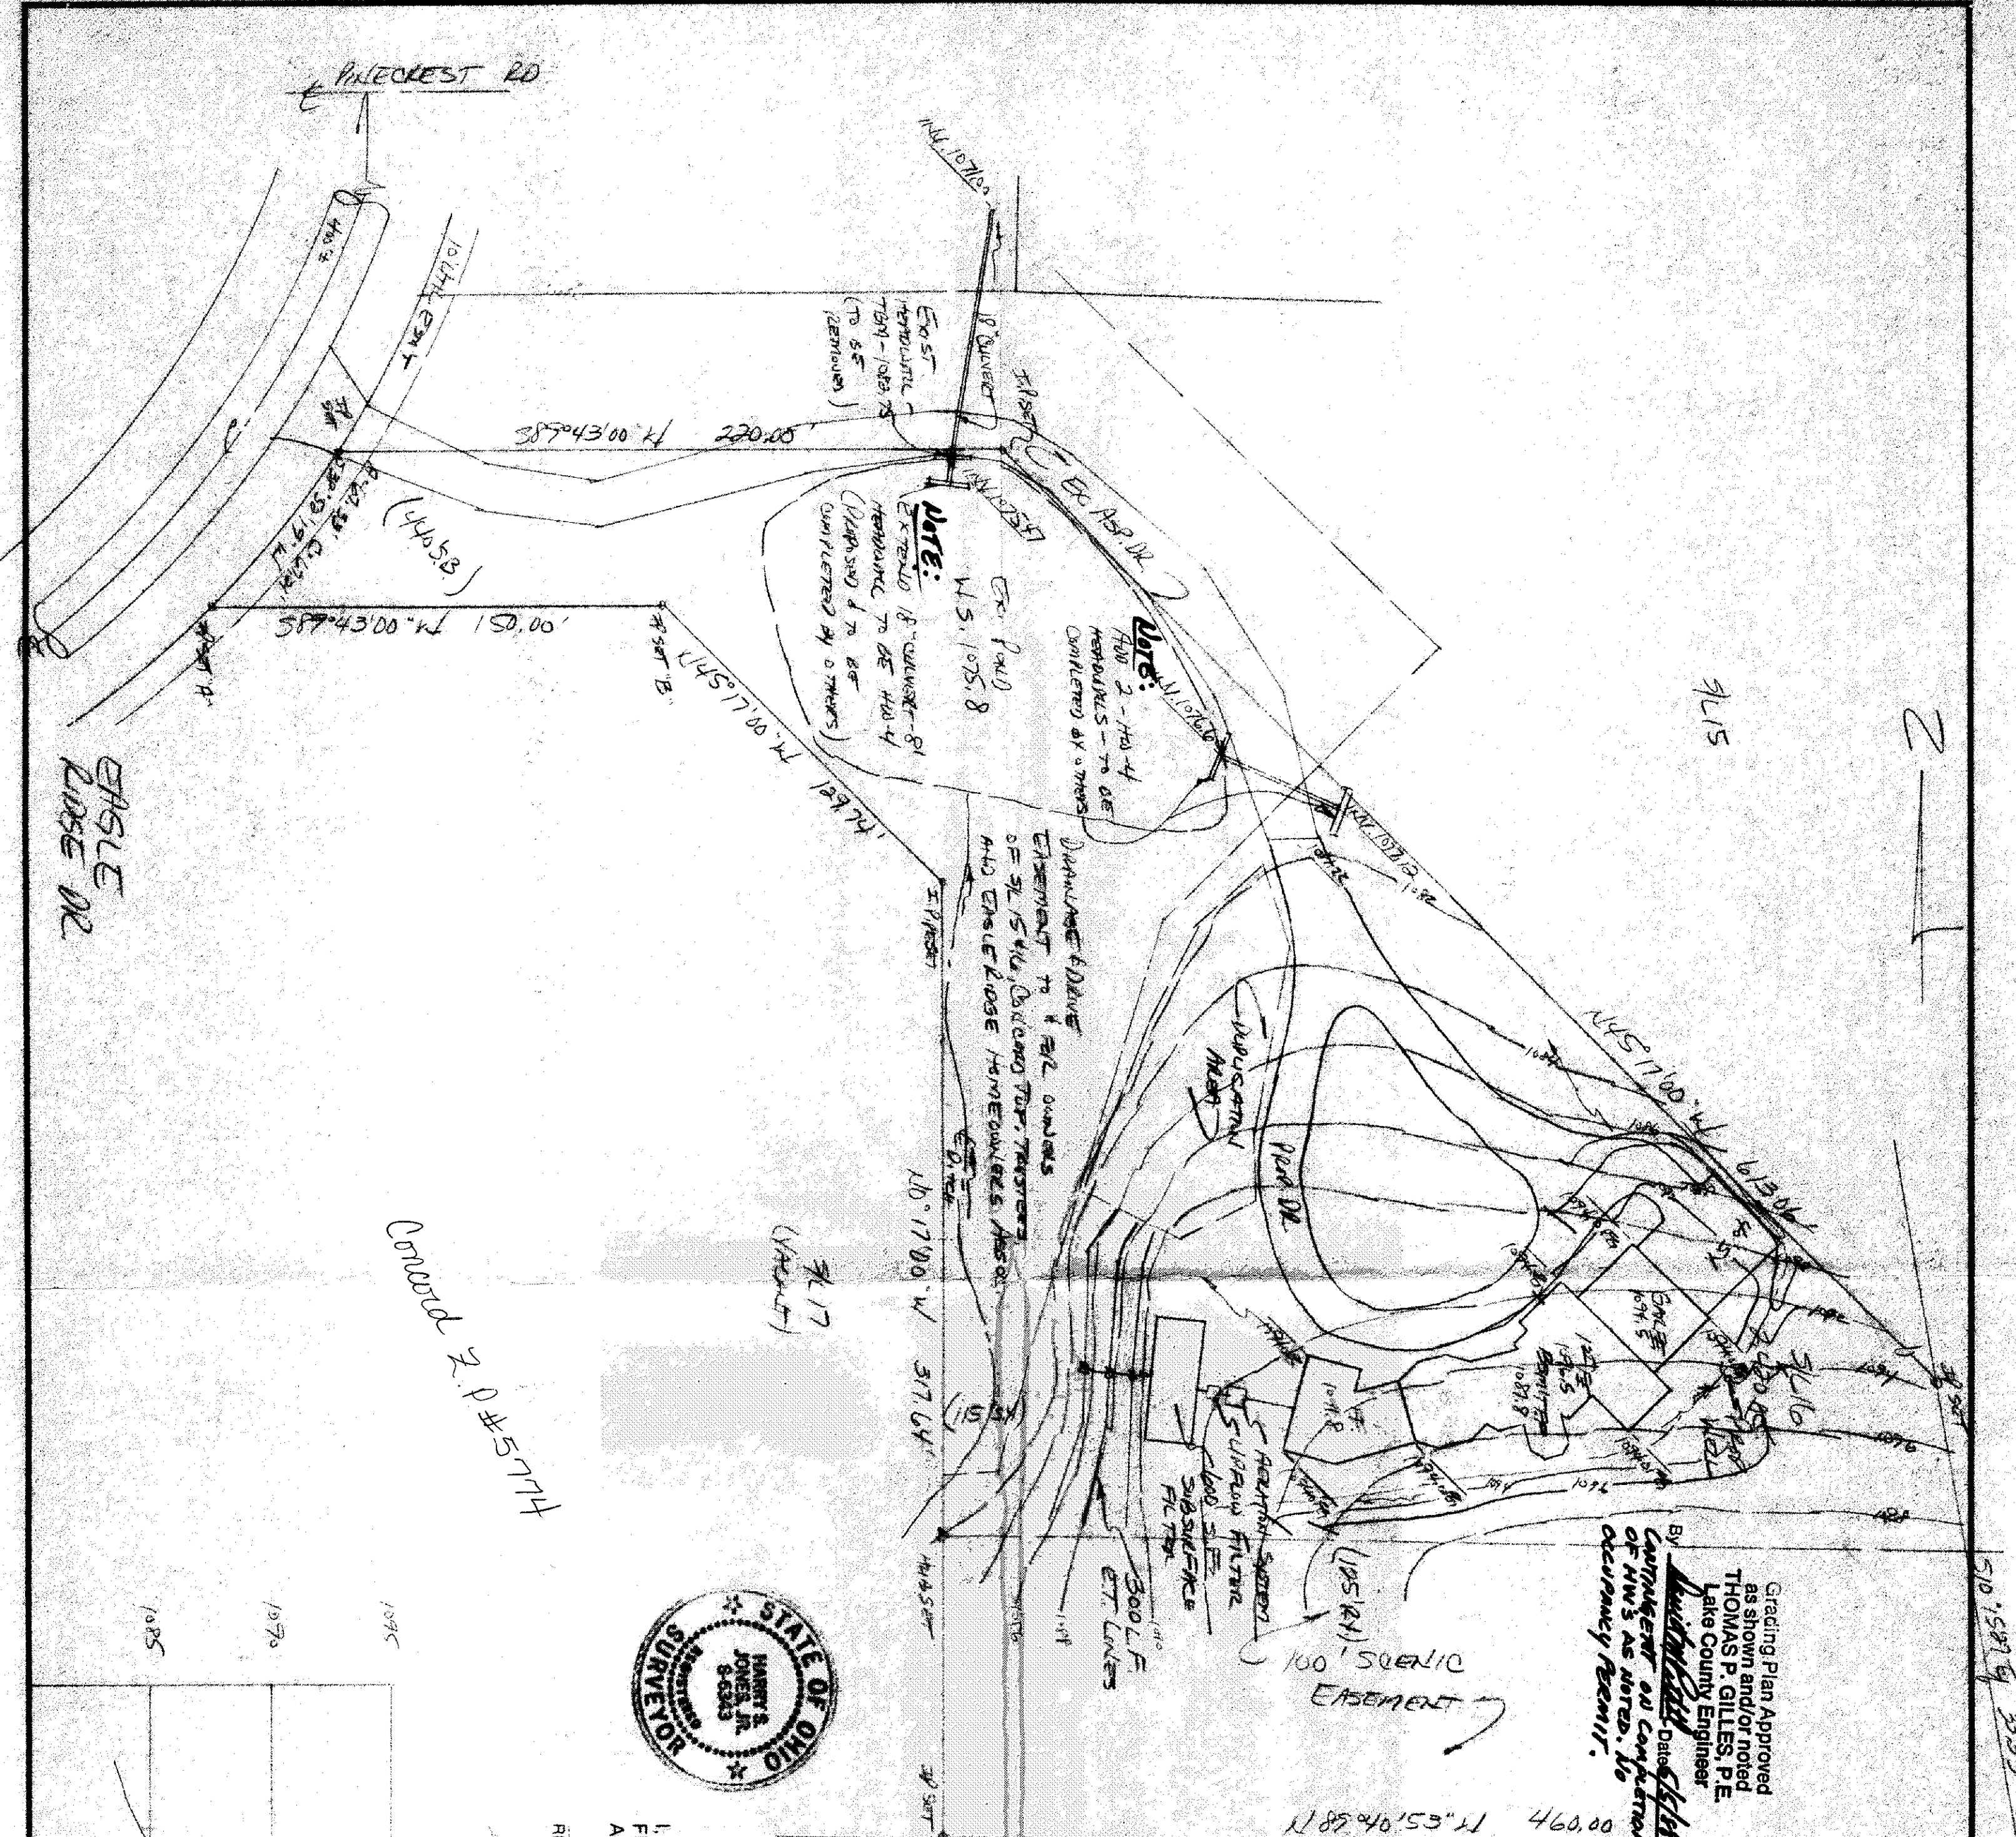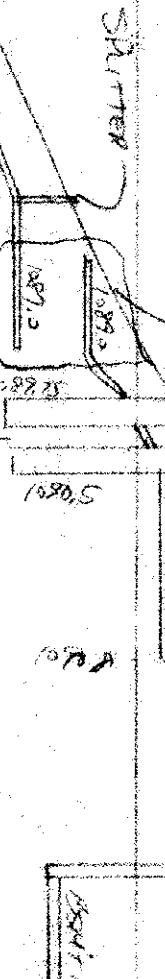

CHASLE
LANE DR

COLUMBIA TWP. #5-7-17H

1085
1070
1095