

SITE PLAN

for: JOHNSON & SONS BUILDERS, Inc.

11785 ARBOR GLEN DR. CHARDON

SUBJECT No. 24 EAGLE RIDGE 9 VOL. 48  
DIVISION No. CONCORD  
DATE 1/1/84



DESIGN CERTIFICATION

THIS PLAN WAS PREPARED BY ME AND IS CORRECT TO THE BEST OF MY KNOWLEDGE AND BELIEF.

*Michael*  
MICHAEL

CHECK LIST

|                    |                     |
|--------------------|---------------------|
| 1. DESIGNER'S NAME | 2. DATE             |
| 3. PROJECT NAME    | 4. SCALE            |
| 5. SHEET NO.       | 6. TOTAL SHEETS     |
| 7. CLIENT'S NAME   | 8. PROJECT ADDRESS  |
| 9. PROJECT PHONE   | 10. PROJECT FAX     |
| 11. PROJECT E-MAIL | 12. PROJECT WEBSITE |

AS BUILT CERTIFICATION  
I HEREBY CERTIFY THAT THE CIRCLED DIMENSION IS EXISTING AS OBTAINED ON THE SITE SURVEY AND IS CORRECT TO THE BEST OF MY KNOWLEDGE AND BELIEF.

| LEGEND         | DATE            |
|----------------|-----------------|
| 1. 1" = 20'-0" | 2. 1" = 20'-0"  |
| 3. 1" = 20'-0" | 4. 1" = 20'-0"  |
| 5. 1" = 20'-0" | 6. 1" = 20'-0"  |
| 7. 1" = 20'-0" | 8. 1" = 20'-0"  |
| 9. 1" = 20'-0" | 10. 1" = 20'-0" |


BENCHMARK B.M. - T.B.M. SET ON RIM OF INLET BASIN LOCATED IN FRONT OF SUBJECT 24. ELEV. 1113.48

*Michael*  
MICHAEL

ISSUED 10-6-84

SUBJECT TO APPROVAL BY  
Lake County Engineering Dept.  
Lake County Planning Comm.  
Lake County Zoning Dept.



PRINTED  
AUG 16 1985  
LDC, INC.

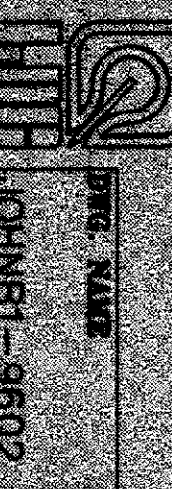

JOHNST-9602

EAGLE RIDGE DRIVE 60'

N 01°37'00" E  
347.00' (16' CL. PL.)

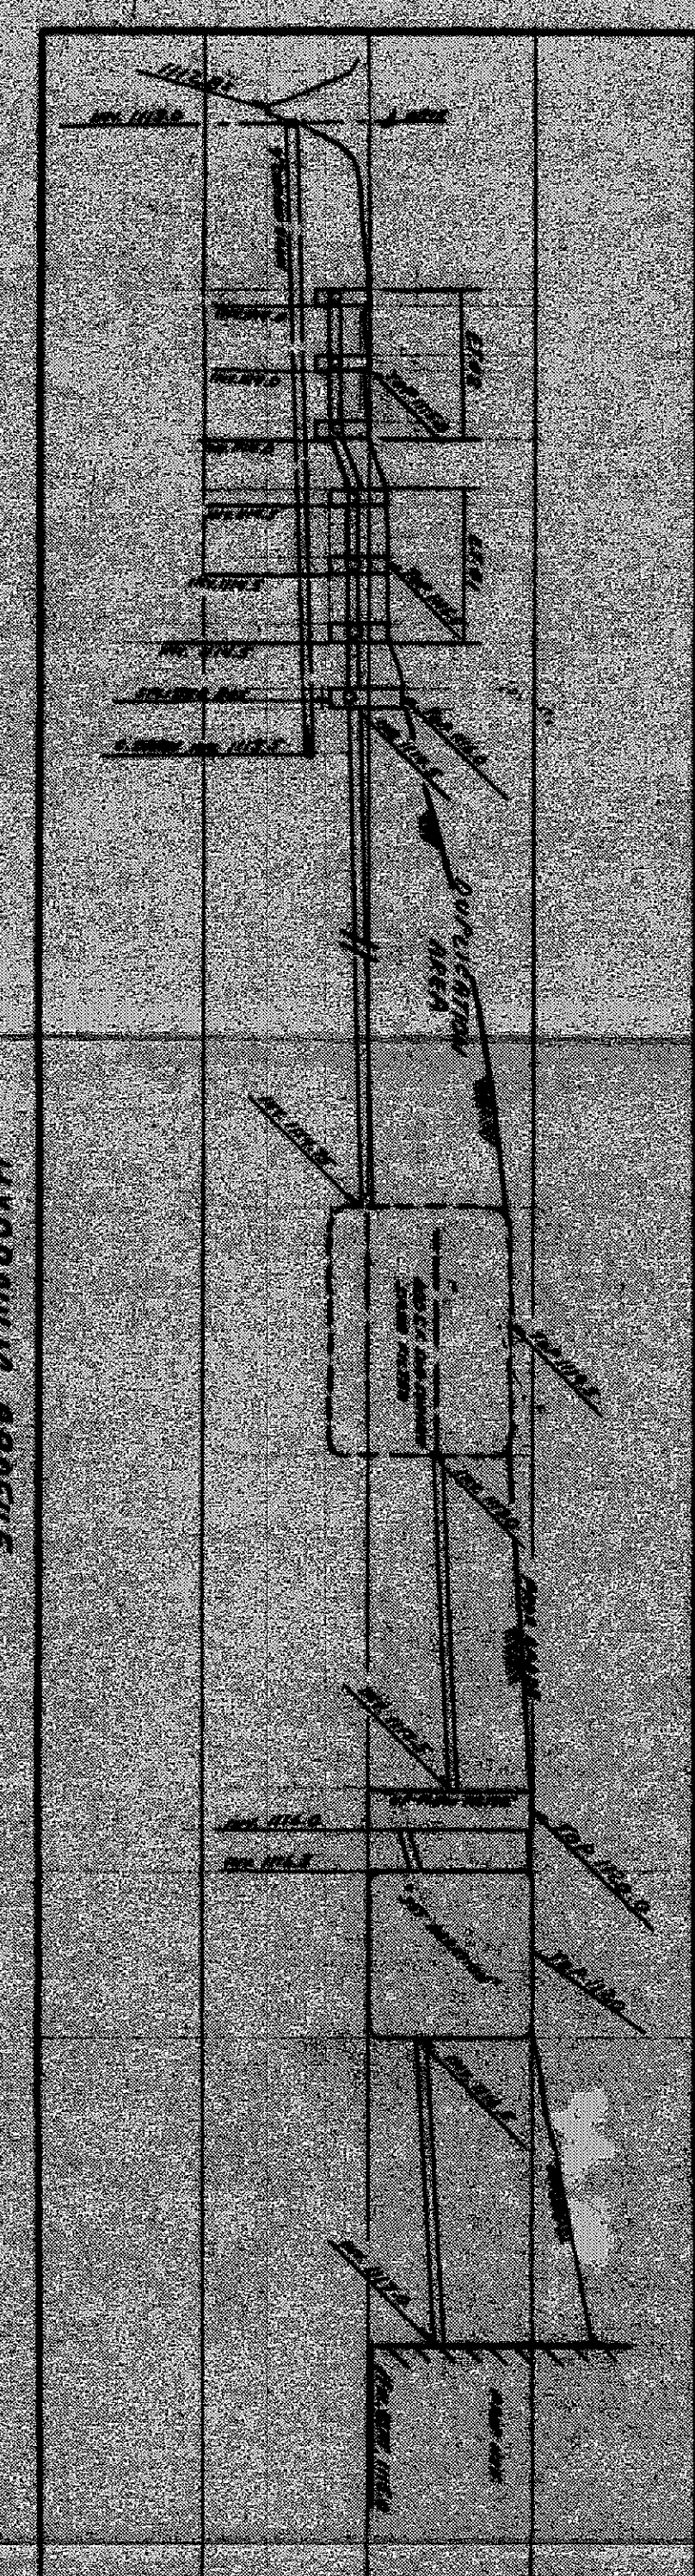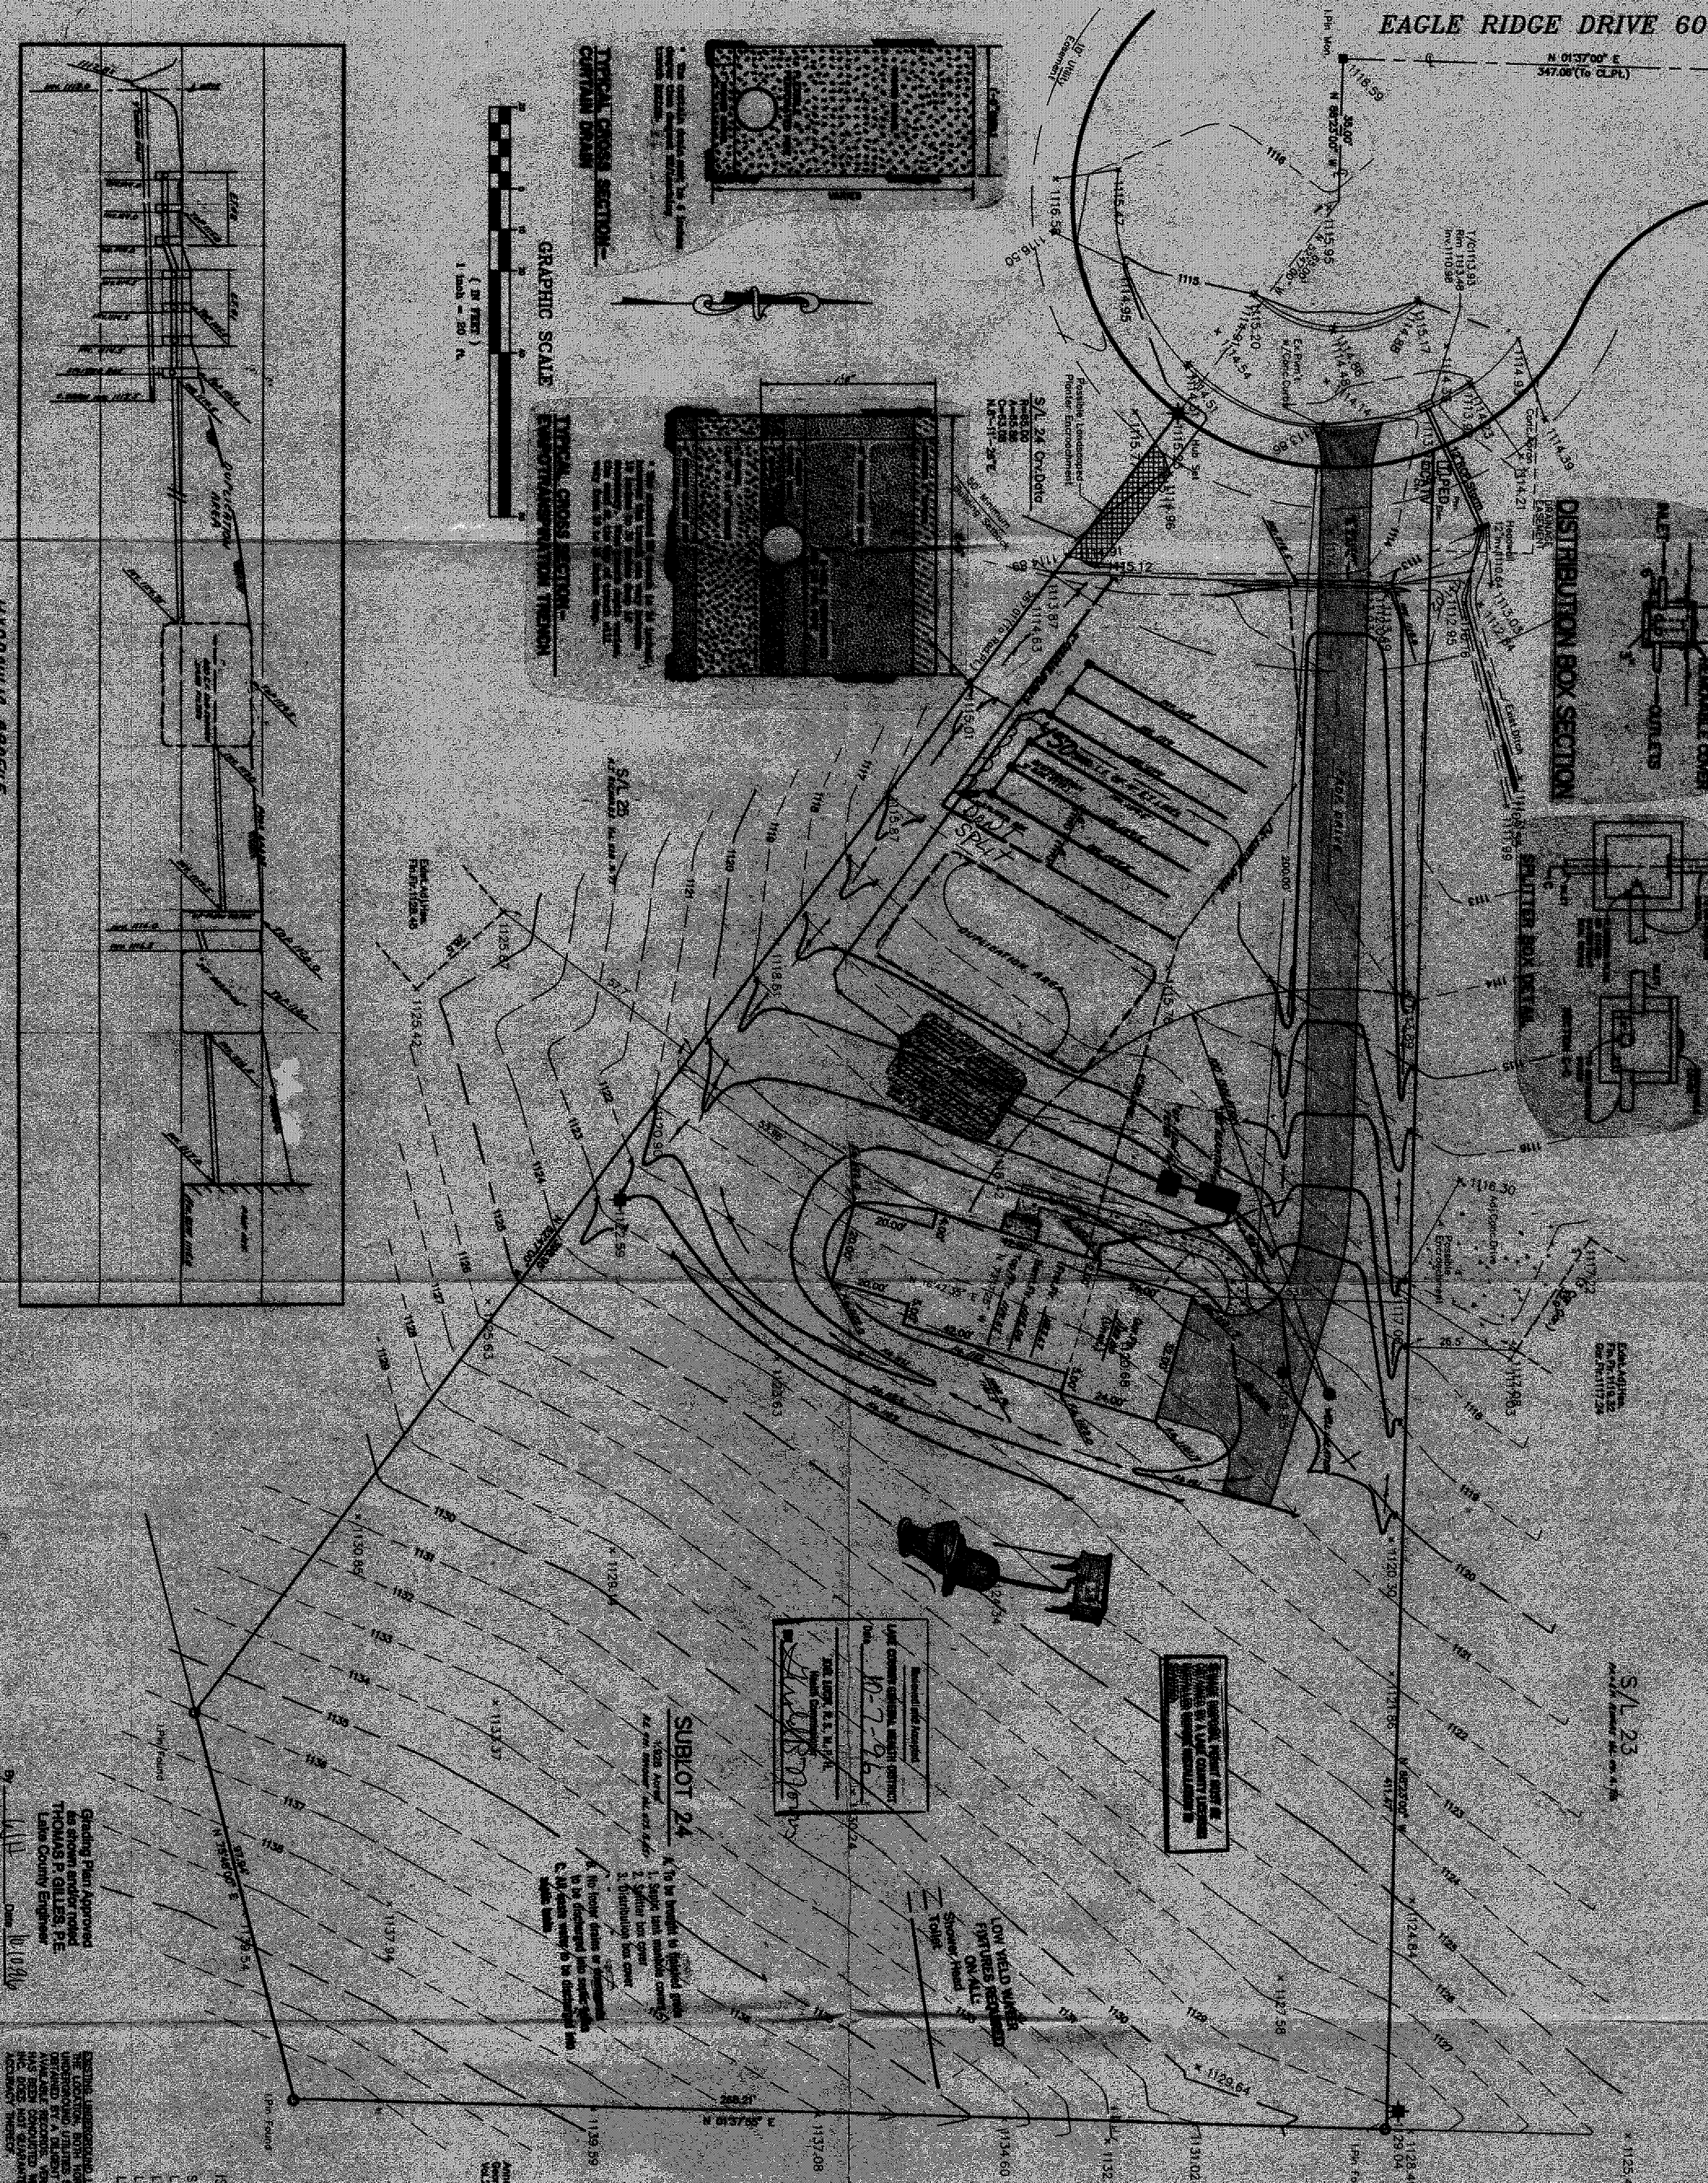

HYDRAULIC PROFILE

Grading Plan Approved  
as shown and noted  
THOMAS P. GILLES, P.E.  
Lake County Engineer

Date 10/1/84