

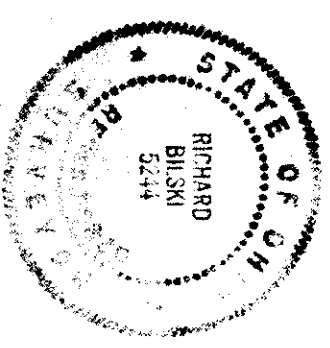


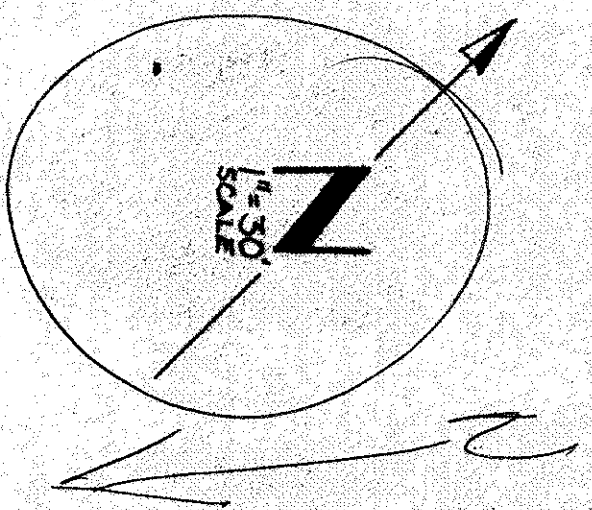

S/L 18

ZONING PERMIT #5948
ISSUED 9-30-88
SUBJECT TO APPROVAL BY:
Lake County Sanitar. Eng. ☐
Lake County Eng. Dept. ☐
Lake County Planning Comm. ☐
Lake County Bldg. Dept. ☐

Tom J. Williams

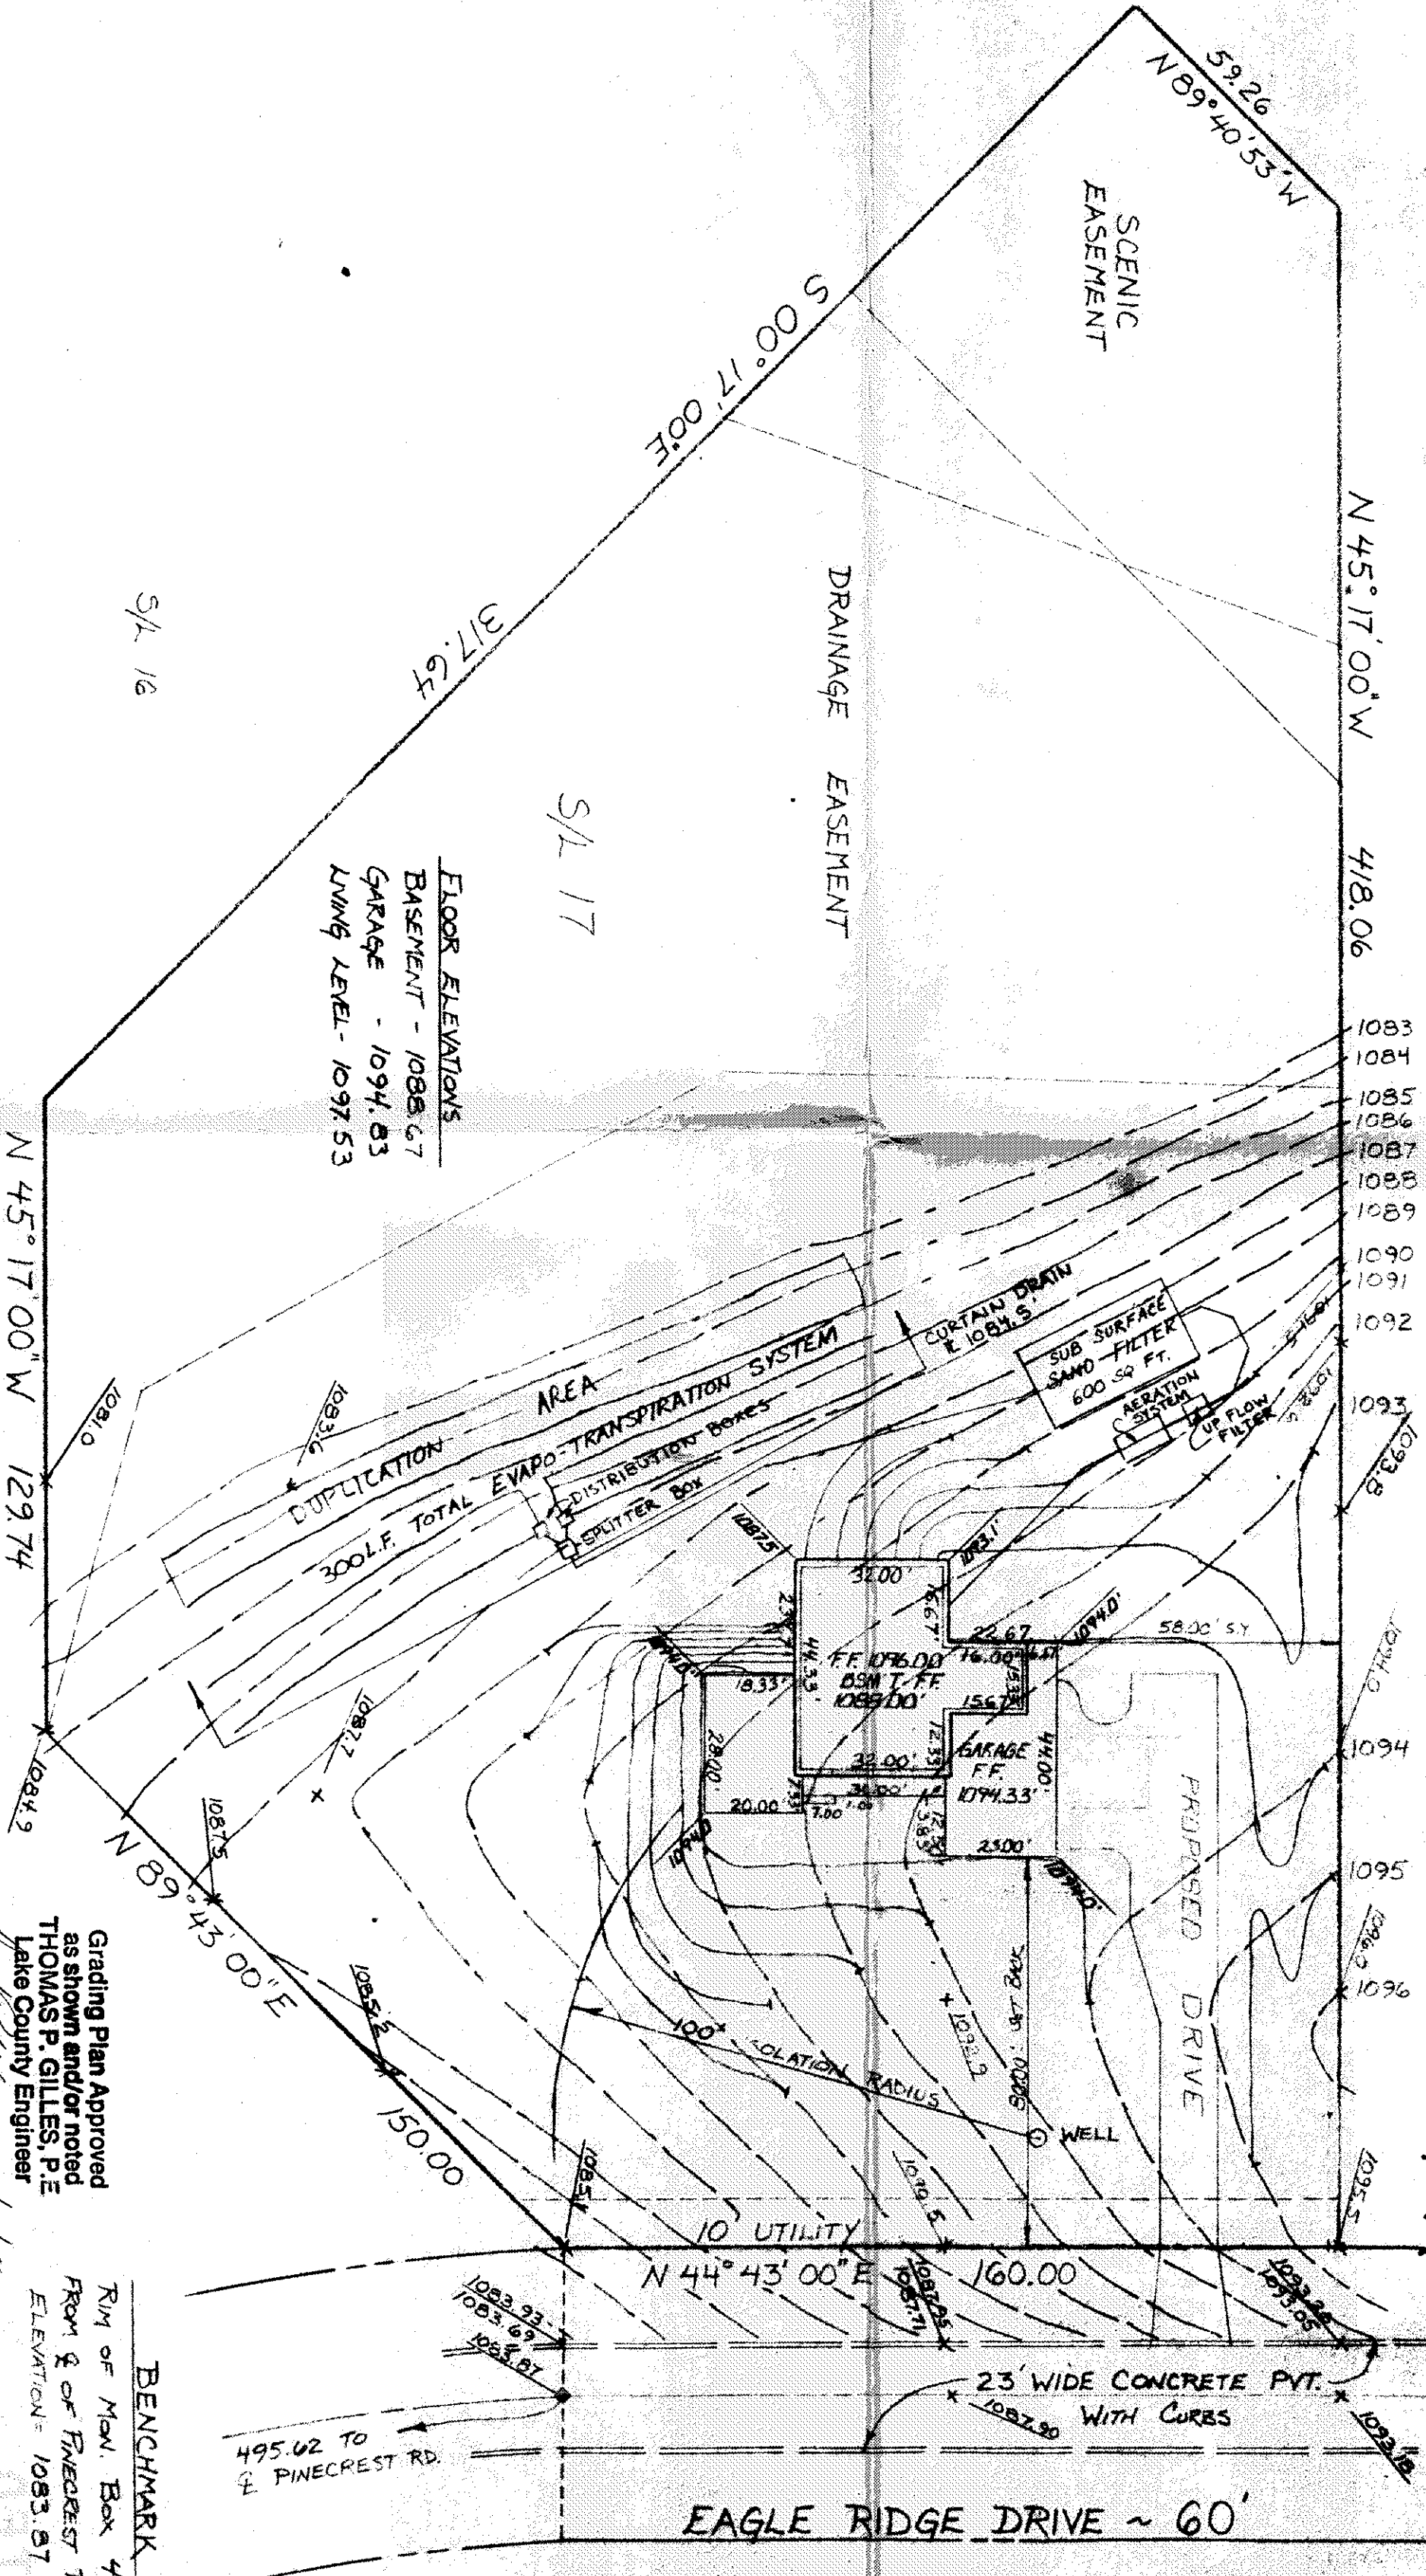

FLOOR ELEVATIONS
BASEMENT - 1088.67
GARAGE - 1094.03
LIVING LEVEL - 1097.53

BENCHMARK
RIM of MAN. BOX 495.62
FROM E of PINECREST RD.
ELEVATION = 1083.87

Grading Plan Approved
as shown and/or noted
THOMAS P. GILLES, P.E.
Lake County Engineer

By *[Signature]* Date 9/3/88

SITE PLAN FOR ANDREWS BUILDING Co.
Being Sublot No. 17 of Eagle Ridge Subdivision
Concord Township, Lake County, Ohio

DESIGN CERTIFICATION

THIS PLAN WAS PREPARED BY ME, AND IS CORRECT TO THE BEST OF MY KNOWLEDGE AND BELIEF.

AS BUILT CERTIFICATION

I HEREBY CERTIFY THAT THE CIRCLED GRADES ARE EXISTING FINISH GRADES CHECKED IN THE FIELD ON SURVEY IS CORRECT TO THE BEST OF MY KNOWLEDGE AND BELIEF.

DATE: 9/88
SCALE: 1" = 30'
DRAWN BY: J.O.

CT Consultants, Inc.
Engineers • Architects • Planners
Village • Mentor • North Canton • Steubenville • Lima

SHEET NO.
1 OF 2
CONTRACT NO.
88-464

REG. SURVEYOR NO. 5244

REG. SURVEYOR NO.

REVISED 8-25-88 CHANGED House & Seams System locations D.A.G.