

1. ~~PROPOSED~~ ~~EXISTING~~ GROUND GRADES
2. ~~OVERLAND~~ DRAINAGE FLOW
3. ~~---~~ ~~---~~ EXISTING GROUND GRADES
4. ~~---~~ ~~---~~ PROPOSED GROUND GRADES
5. BENCH MARK TOP OF HOU & LVE
OF ROAD AT PC. ELEV 1113.51


NOTES

6. IRON PINS SET = ●
7. ALL WORK TO BE DONE PER
LAKE COUNTY HEALTH DEPT. STANDARDS
8. ALL FINISH FLOOR ELEVATIONS AND
DEPTH, SIZE AND LOCATIONS OF ALL
UTILITY CONNECTIONS TO BE VERIFIED
BY CONTRACTOR.

PHONE
946-2829

FINISH FLOOR GRADES
GARAGE 1110.67
1ST FLR. 1112.50
BASMT 1102.83

Reviewed and Accepted	
LAKE COUNTY GENERAL HEALTH DISTRICT	
Date	6-12-89
J. L. LUCK, R. S., M. P. H. Health Commissioner	
<i>[Signature]</i>	

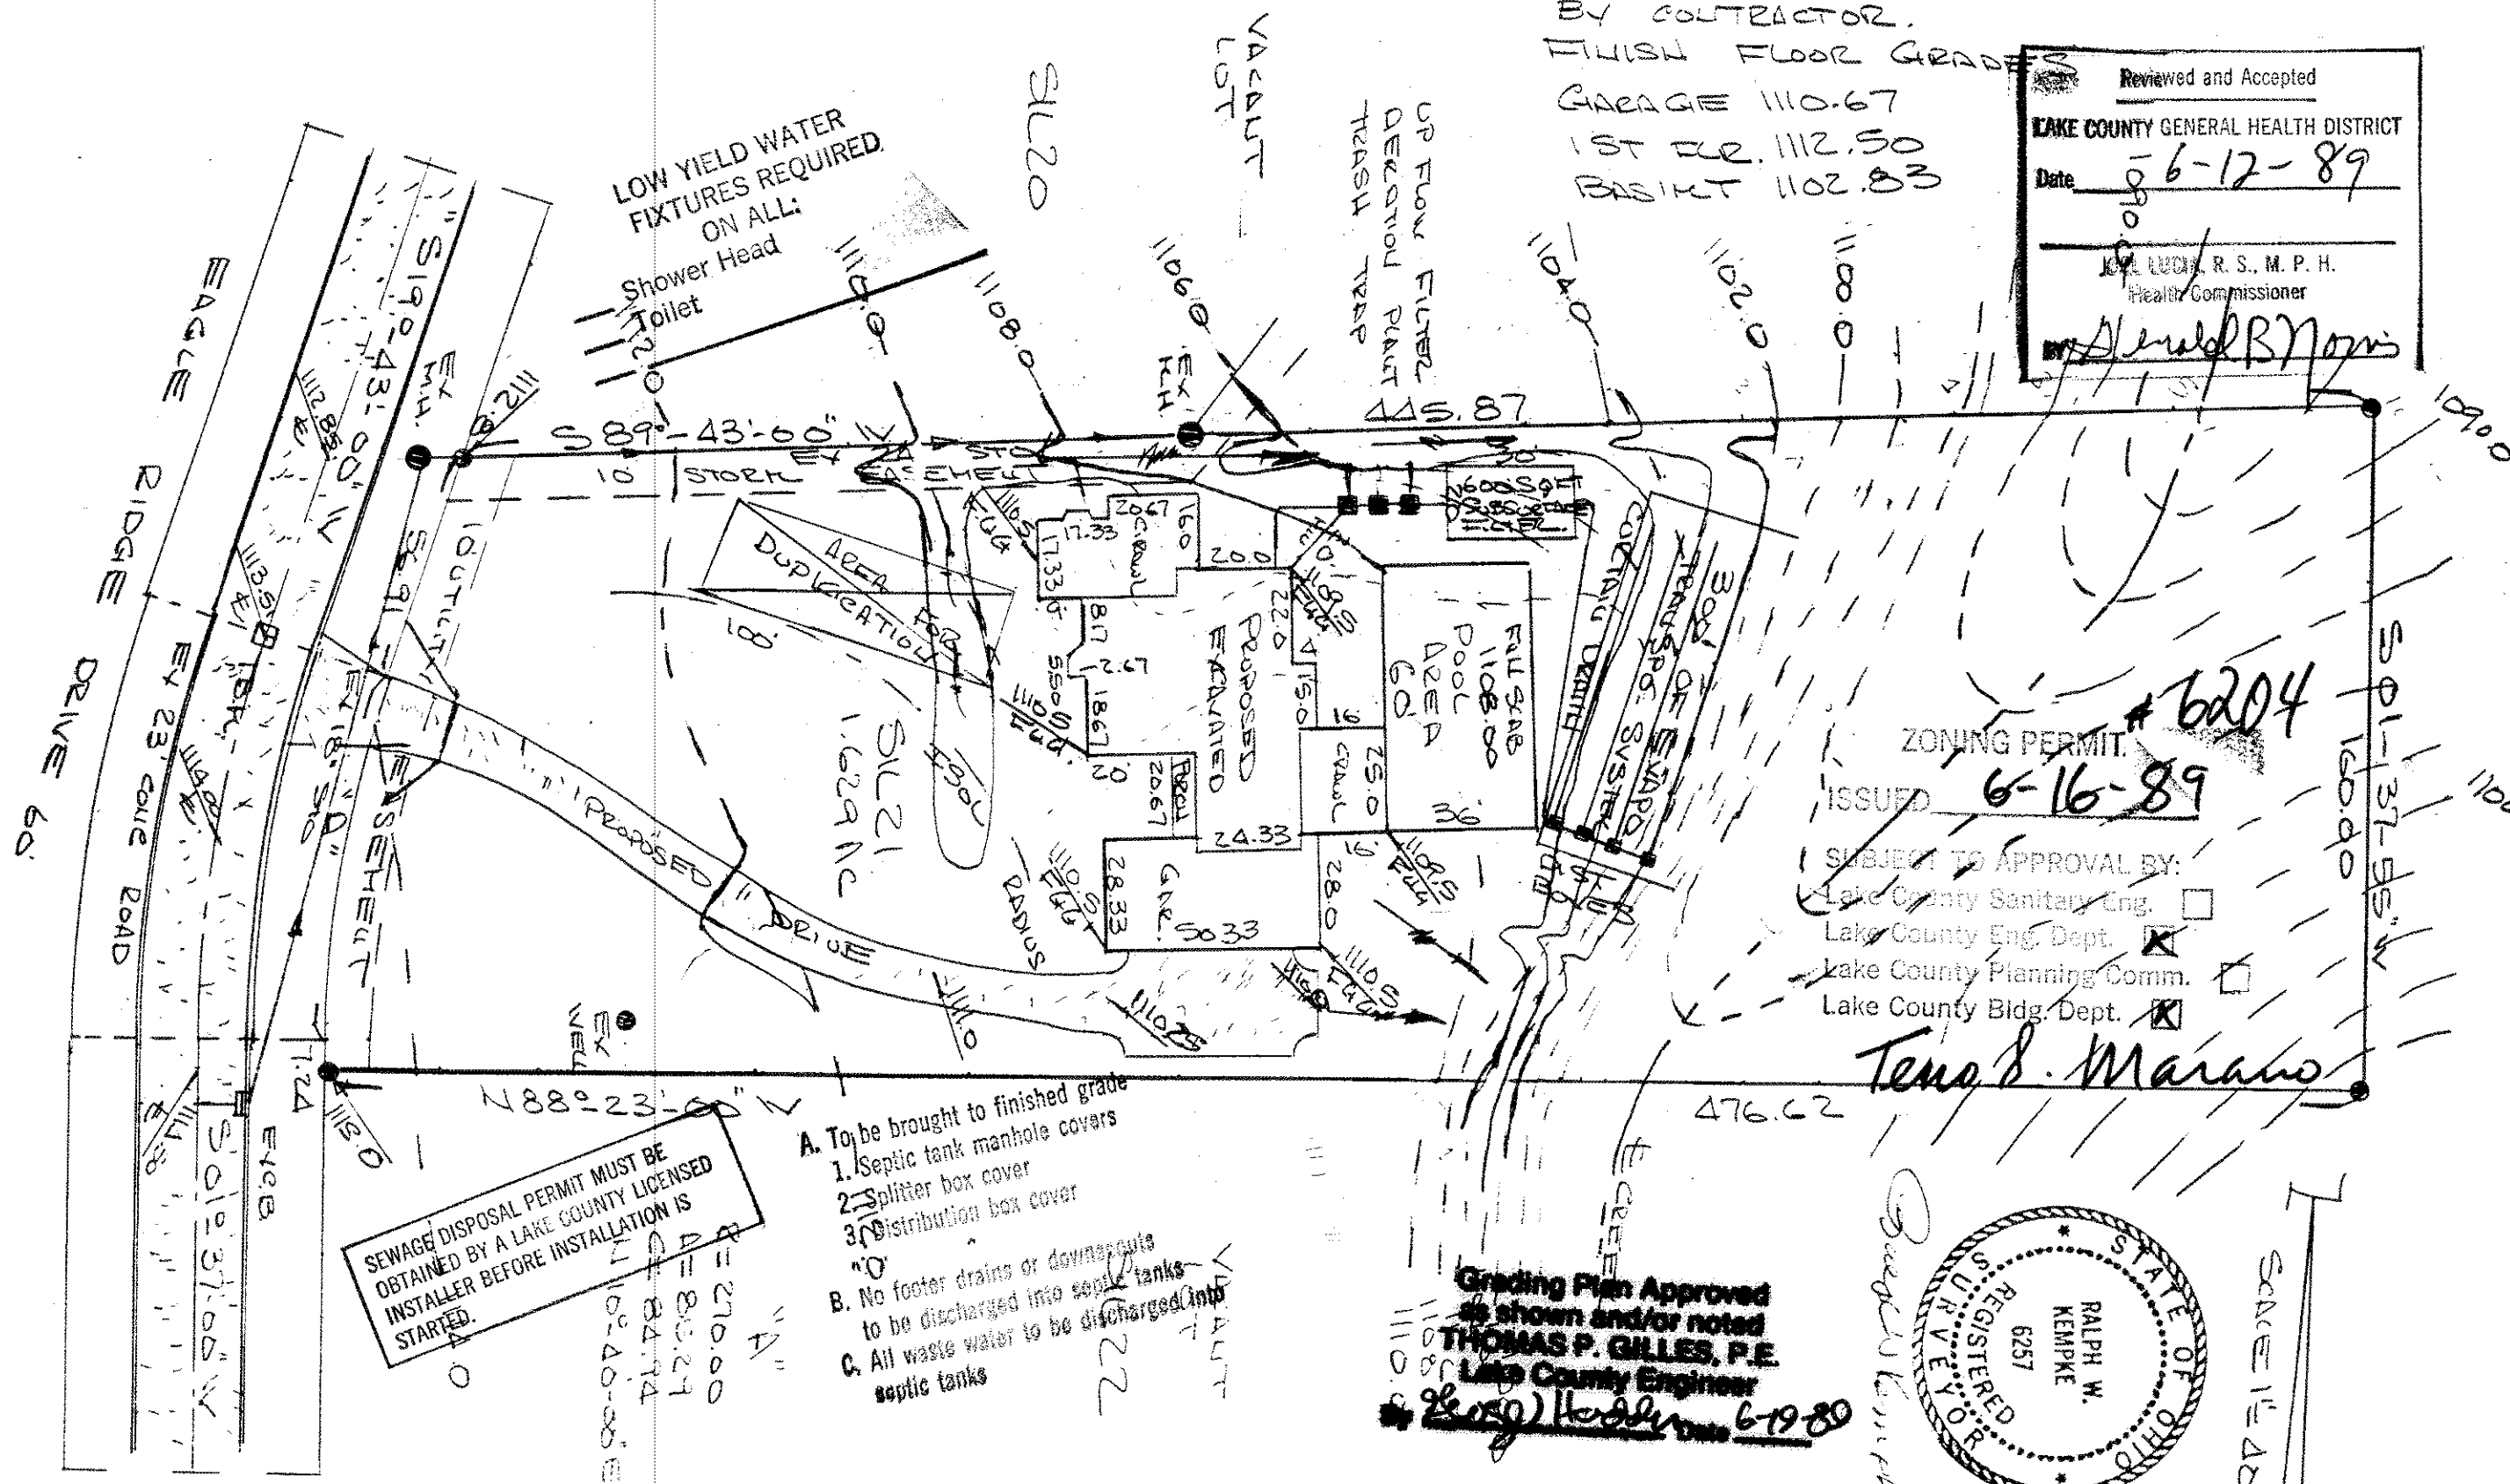

ZONING PERMIT

ISSUED 6-16-89

SUBJECT TO APPROVAL BY:


- ☐ Lake County Sanitary Eng.
- ☒ Lake County Eng. Dept.
- ☐ Lake County Planning Comm.
- ☒ Lake County Bldg. Dept.

Thomas P. Marano

SEWAGE DISPOSAL PERMIT MUST BE
OBTAINED BY A LAKE COUNTY LICENSED
INSTALLER BEFORE INSTALLATION IS
STARTED.

- A. To be brought to finished grade
 1. Septic tank manhole covers
 2. Splitter box cover
 3. Distribution box cover
- B. No footer drains or downspouts
to be discharged into septic tanks
- C. All waste water to be discharged into
septic tanks

Grading Plan Approved
as shown and/or noted
THOMAS P. GILLES, P.E.
Lake County Engineer
[Signature] 6-19-89

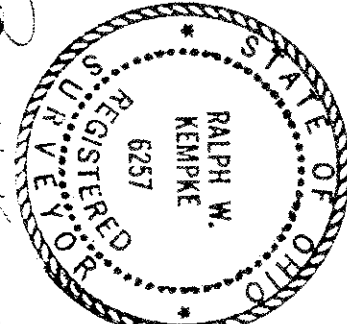

SITE PLAN
 FOR PETER AND KATHY LOUGO
 OF SUBLOT NO. 21 IN THE EAGLE RIDGE SUBD. AS SHOWN BY THE PLAT
 RECORDED IN VOL 9 PAGE 48 OF C.C.R. LOCATED IN THE TOWNSHIP OF
 COUGHD AND TOWNE 1988 PREPARED BY RAIPH W. KEMPE, P.E. (2284-9388), 1709