


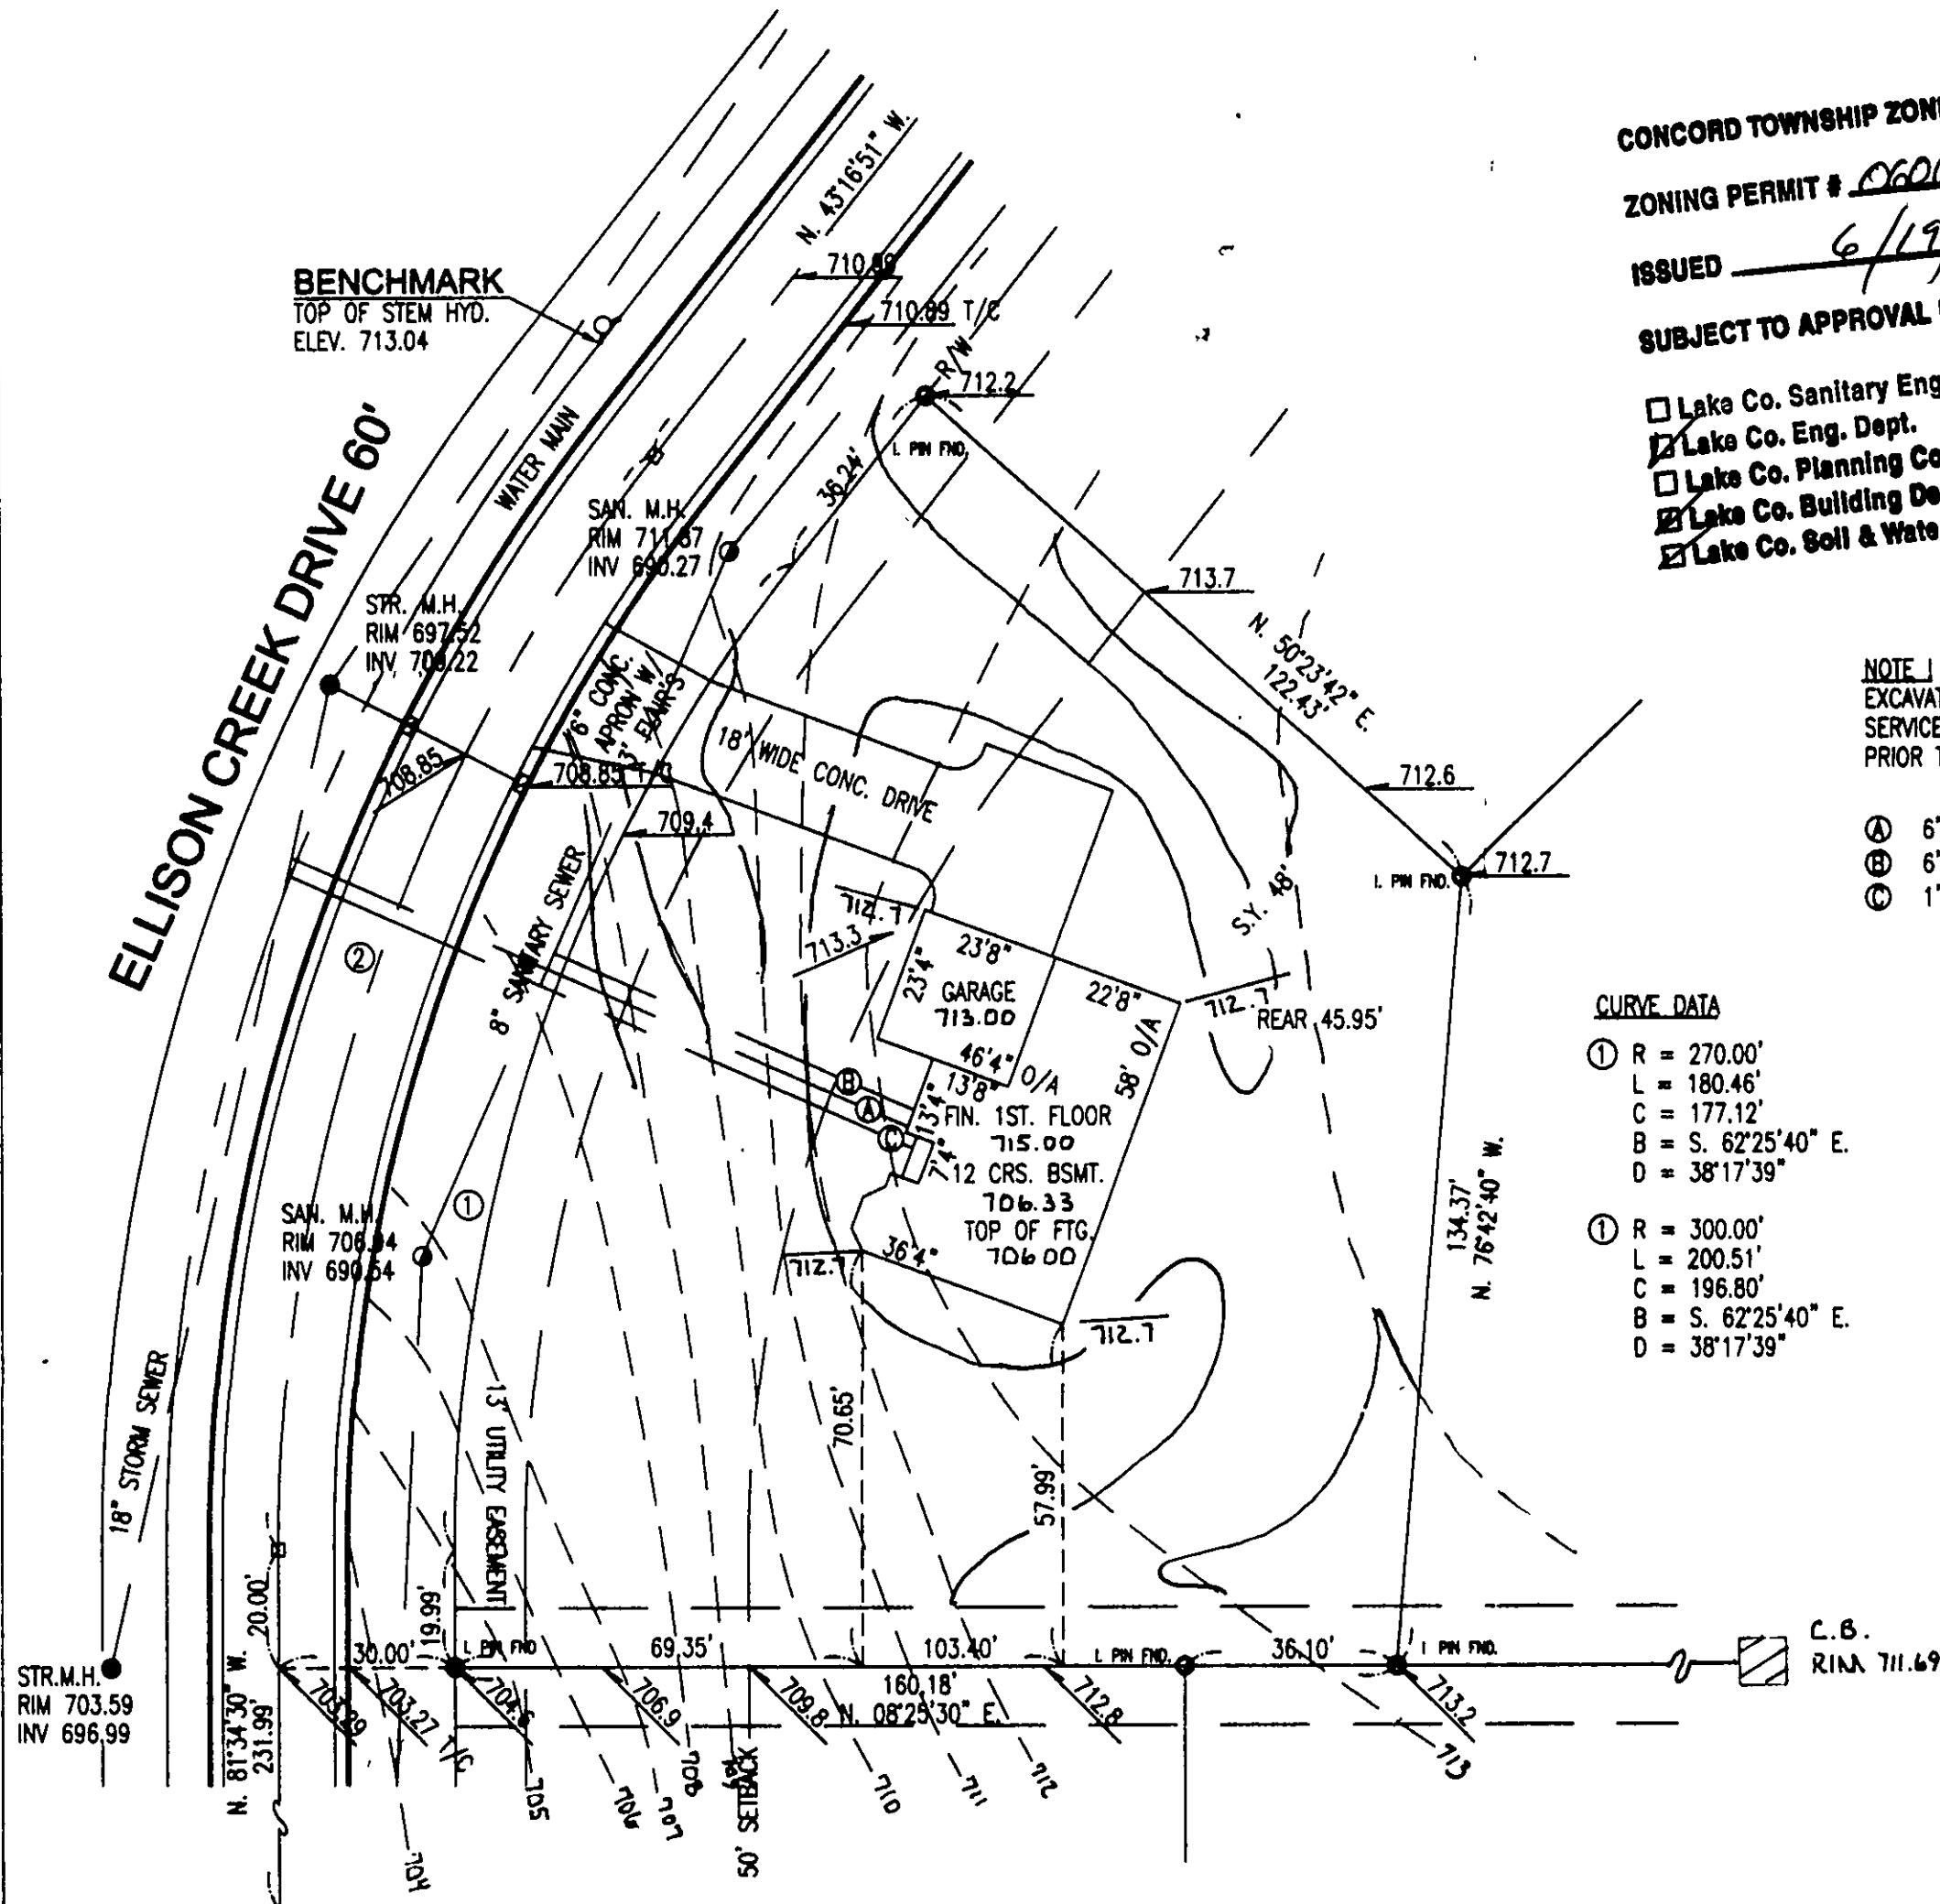


CONCORD TOWNSHIP ZONING OFFICE
ZONING PERMIT # 0601-10203
ISSUED 6/19/2001
SUBJECT TO APPROVAL BY:

Grading Plan Approved
as shown and/or noted
JAMES R. GILLS, P.E.
Lake County Engineer

By TAM Date 6/20/01

- ☐ Lake Co. Sanitary Engineer
- ☒ Lake Co. Eng. Dept.
- ☐ Lake Co. Planning Comm.
- ☒ Lake Co. Building Dept.
- ☒ Lake Co. Soil & Water Cons. Dist.

ROOF DRAINS
SHALL DISCHARGE
TO SPLASH BLOCKS.

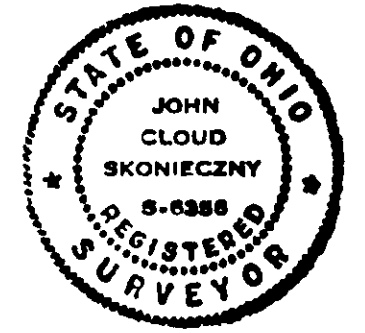

NOTE:
EXCAVATING CONTRACTOR TO FIELD VERIFY
SERVICE CONNECTION LOCATION AND ELEVATIONS
PRIOR TO BASEMENT EXCAVATION.

- Ⓐ 6" P.V.C., STR. SEWER @1.00% MIN
- Ⓑ 6" P.V.C., SAN SEWER @1.00% MIN.
- Ⓒ 1" WATER CONN. TYPE "K" COPPER

CURVE DATA

- ① R = 270.00'
L = 180.46'
C = 177.12'
B = S. 62°25'40" E.
D = 38°17'39"
- ② R = 300.00'
L = 200.51'
C = 196.80'
B = S. 62°25'40" E.
D = 38°17'39"

--- EXISTING GRADES
--- PROPOSED GRADES
--- SWALE


2 WORKING DAYS
BEFORE YOU DIG
CALL TOLL FREE 800-362-2764
OHIO UTILITIES PROTECTION SERVICE

I CERTIFY THAT THIS PLAN
WAS PREPARED BY ME AND
IS CORRECT TO THE BEST OF
MY KNOWLEDGE AND BELIEF

John C. Skonieczny
REG. SURVEYOR #6356

JOHN C. SKONIECZNY
7739 VIEWMOUNT DR.
PAINESVILLE, OHIO 44077
PH. 352-7742

GRAPHIC SCALE

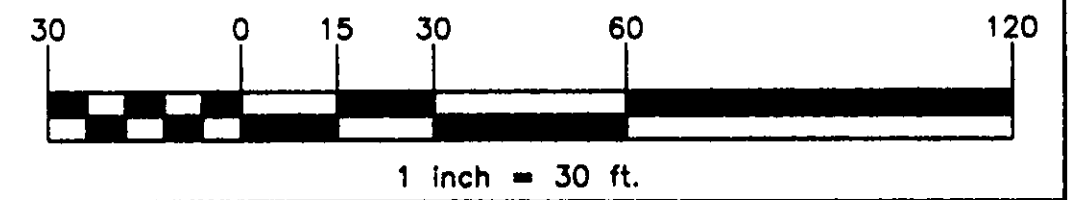

SITE PLAN FOR: CENDOL CONSTRUCTION			
SCALE: 1" = 30'	APPROVED:	DRAWN BY: SWC	
DATE: MAR. 01		REVISED:	
BEING SUBLOT 6 IN THE ELLISON CREEK SUBDIVISION RECORDED IN PLAT VOL. 39-17 PG. 1 LAKE COUNTY RECORD OF PLATS TOWNSHIP OF CONCORD - COUNTY OF LAKE - STATE OF OHIO			
JOB# 01-3159			01-2060