


CONCORD TOWNSHIP ZONING OFFICE
 ZONING PERMIT # 0102-10452
 ISSUED 1/31/2002
 SUBJECT TO APPROVAL BY:
☒ Lake Co. Soil & Water Cons. Dist.
☒ Lake Co. Building Dept.
☒ Lake Co. Planning Comm.
☒ Lake Co. Eng. Dept.
☒ Lake Co. Sanitary Engineer

1. Proposed Ground Grades
2. OVERLAND DRAINAGE FLOW
3. BUILD MARK TOP OF LND FRONT OF
4. EXISTING COUNTERS
5. PROPOSED COUNTERS
6. 100' ± 5% TYP. PVI SET ON
7. ROAD WITH 500'
8. 100' ± 5% TYP. PVI SET ON
9. 100' ± 5% TYP. PVI SET ON
10. 100' ± 5% TYP. PVI SET ON

FINISH FLOOR GRADES
 GARAGE FLOOR 712.40
 1ST FLOOR 715.13
 BASEMENT FLOOR 709.46
 BOTTOM OF FOOTER 705.46
 100 YEAR FLOOD ZONE ELEV
 IS 670.6 HIGHER IS IN
 FLOOD ZONE "C"

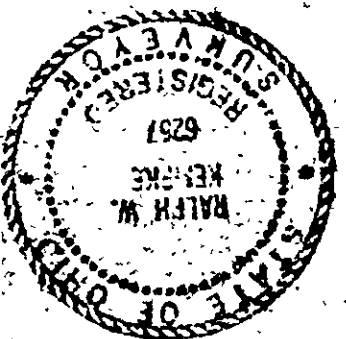

Grading Plan Approved
 as shown and/or noted
 JAMES R. GILLS, P.E.
 Lake County Engineer
 Date 1/31/02
 By L.H.
 ROOF DRAINS
 SHALL DISCHARGE
 TO SPLASH BLOCKS

IF CERTIFY THAT THE BOUNDARY SURVEY IS IN
 ACCORDANCE WITH CURRENT MINIMUM STANDARDS FOR
 BOUNDARY SURVEYS IN THE STATE OF OHIO
 I HEREBY CERTIFY THAT ACTUAL FIELD
 OBSERVATION OF ELEVATIONS HAVE BEEN
 MADE BY ME ON JULY 22, 2002
 Drafted by K. K. P. 05/25/07

