


NOTE: TEMPORARY SEEDING REQUIRED
IN DISTURBED AREAS.

S/L 6
S/L 5
S/L 38
(VACANT)

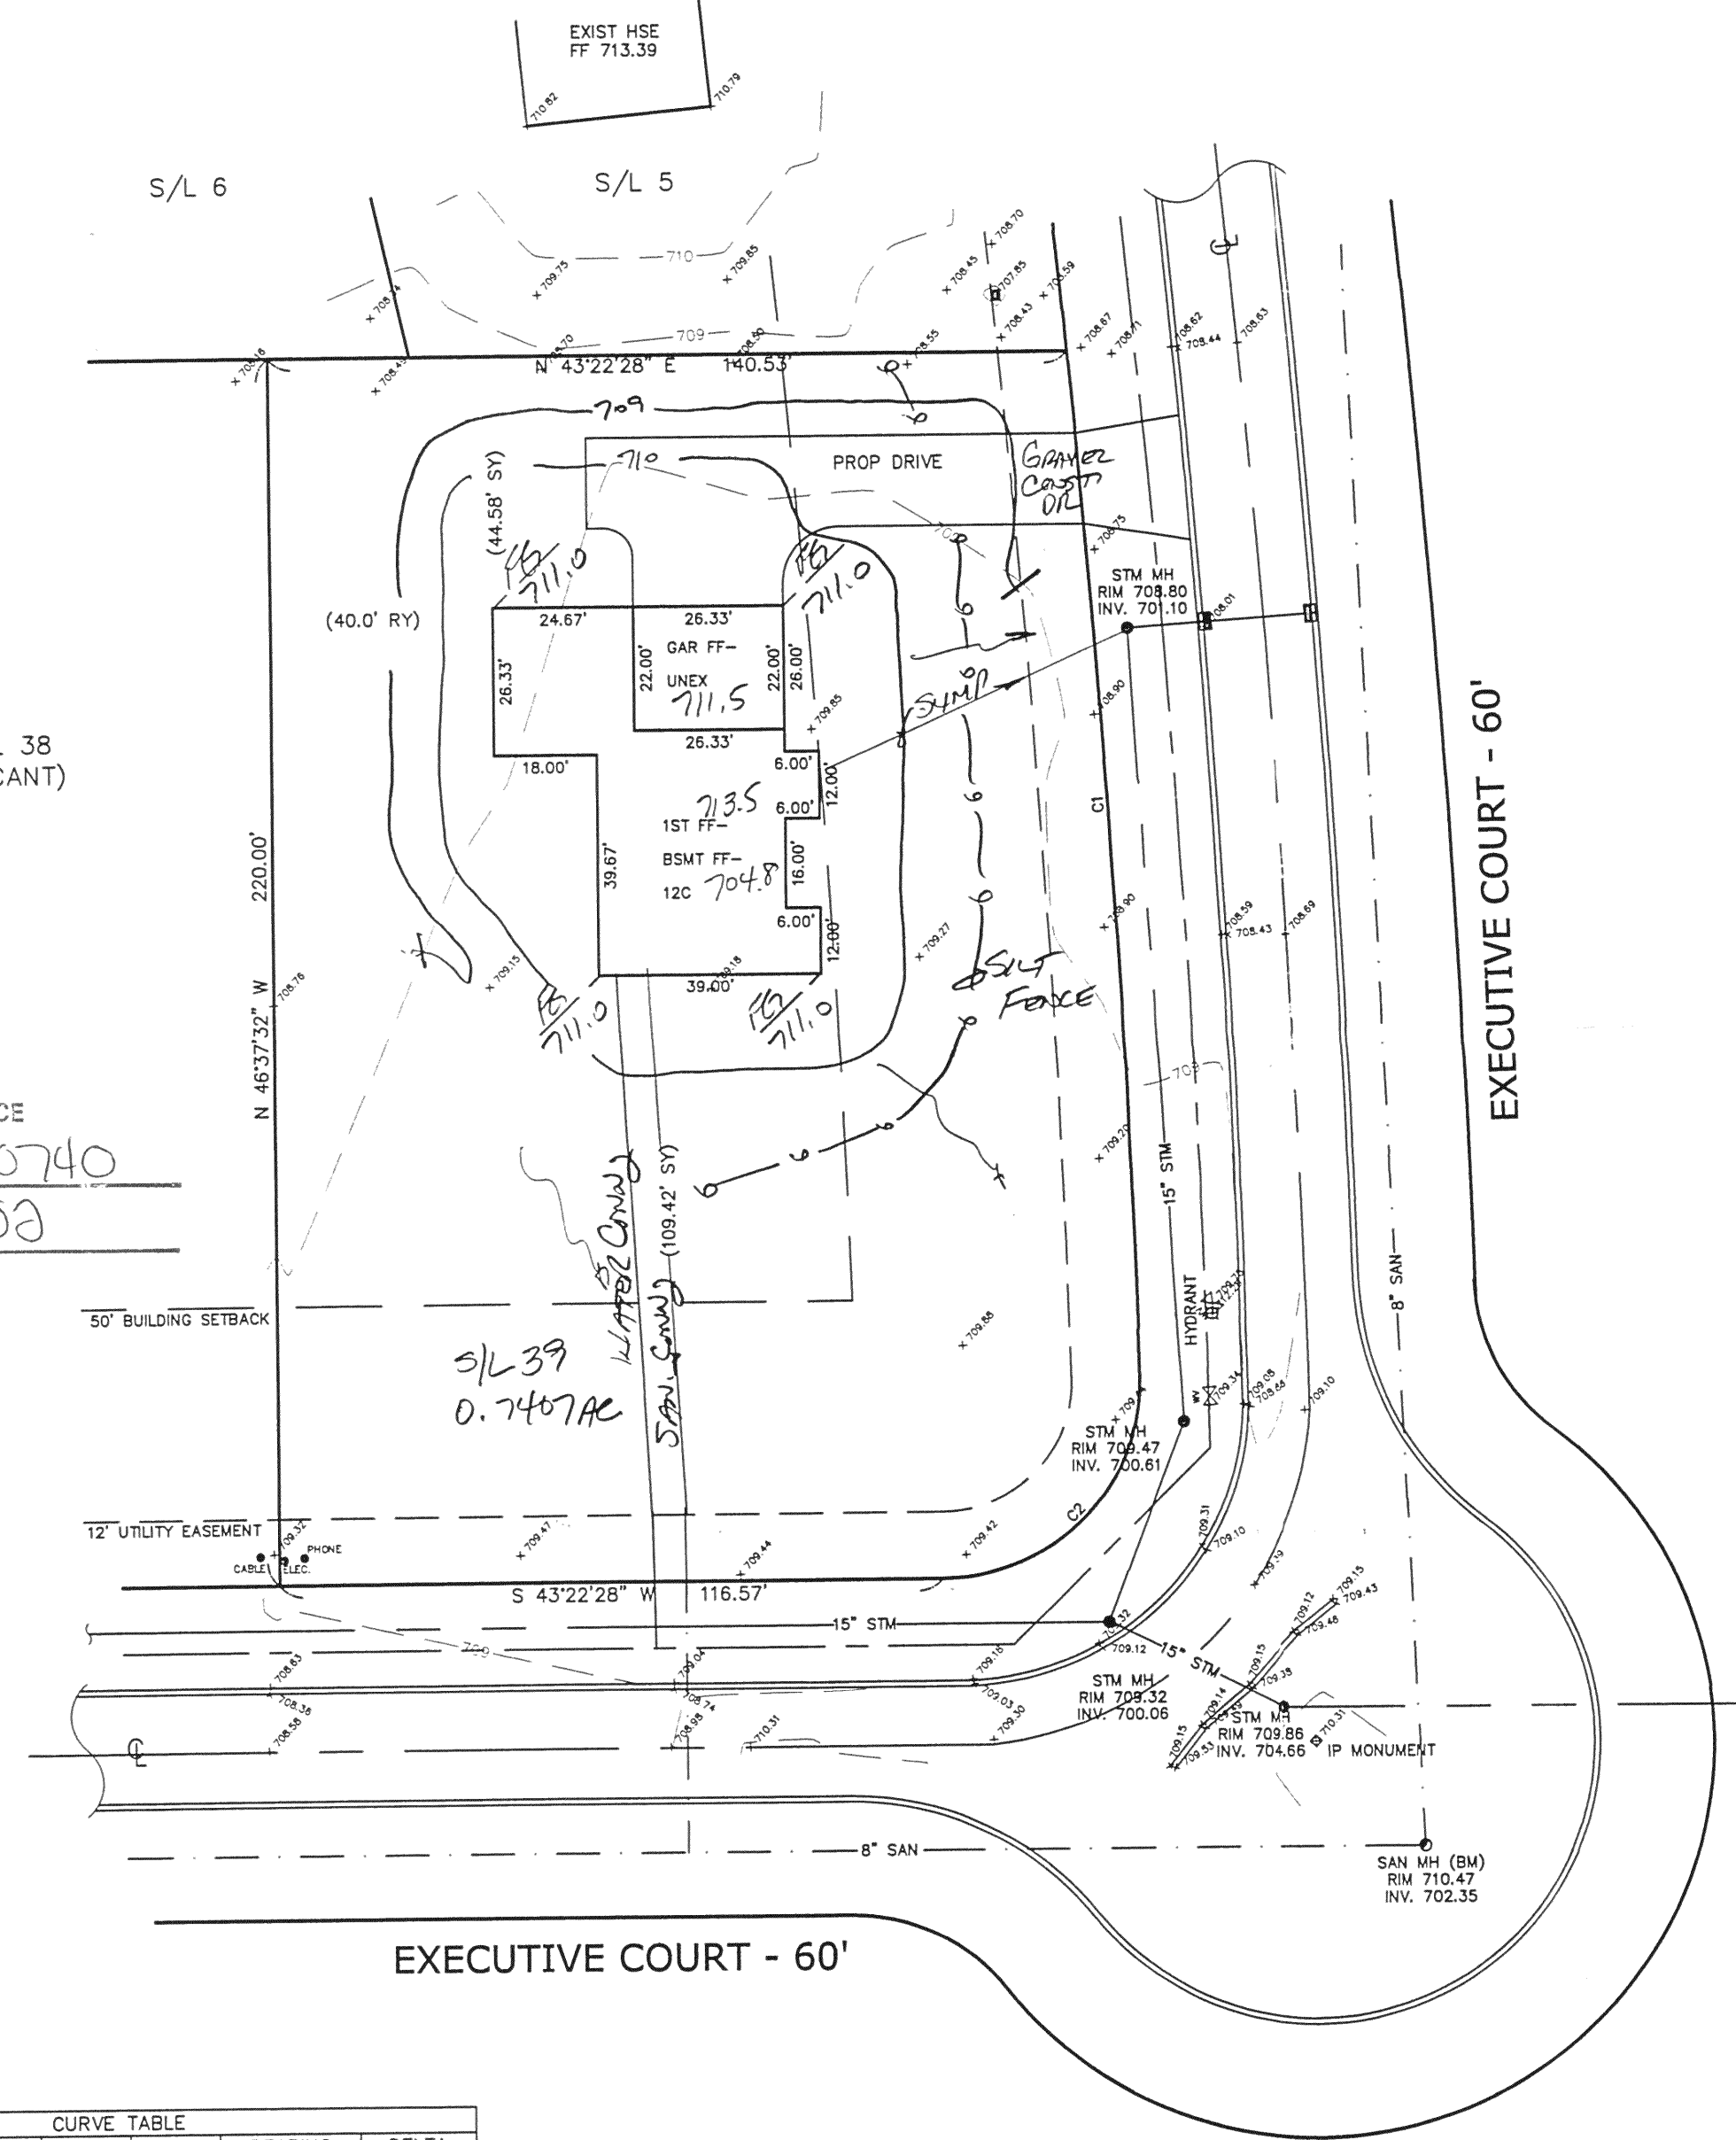

EXECUTIVE COURT - 60'

CURVE TABLE						
CURVE	LENGTH	RADIUS	TANGENT	CHORD	BEARING	DELTA
C1	184.50	2642.58	92.29	184.46	N50°03'14"W	04°00'01"
C2	55.85	35.00	35.88	50.11	N02°20'23"E	91°25'42"

CONCORD TOWNSHIP ZONING OFFICE
ZONING PERMIT # 0802-10740
ISSUED 8-22-02
SUBJECT TO APPROVAL BY:
☒ Lake Co. Engineer
☐ Lake Co. Planning Comm.
☐ Lake Co. Building Dept.
☐ Lake Co. Soil & Water Cons. Dist.

SITE PLAN

CONCORD TOWNSHIP, LAKE COUNTY, OHIO

for: PAPPALARDO

CLIENT

OWNER

ADDRESS

STREET

CITY

ZIP

CHAIRMAN'S COVE

SUBDIVISION

33-28

NAME

TRACT

STREET

39

VOL-PG

EXECUTIVE COURT

LOT

STREET

VOL-PG

PERM. PARCEL NO.

LEGEND

SANITARY MANHOLE

STORM MANHOLE

INLET OR CATCH BASIN

HYDRANT

EXISTING CONTOURS

PROPOSED CONTOURS

EXIST. ELEV.

100.0

100.0

PROP. ELEV.

100.0

AS BUILT ELEVATION

INDICATES

DIRECTION OF

SURFACE DRAINAGE

REMARKS

ALL BOUNDARY DATA SHOWN WAS OBTAINED FROM (DEEDS, RECORDED SUBDIVISION PLAT OR OTHER PUBLIC RECORDS)

LOCATIONS AS SHOWN OF ADJACENT WELLS AND SEPTIC TANKS OBTAINED FROM LAKE COUNTY HEALTH DEPARTMENT

DESIGN CERTIFICATION

THIS PLAT WAS PREPARED BY ME, AND IS CORRECT TO THE BEST OF MY KNOWLEDGE AND BELIEF

NAME

REGISTRATION NO.

CHECK LIST

NO. OF BEDROOMS

DIMENSIONS

BEARINGS

TIE TO NEAREST STREET

SUBLOT NO. PARCEL NO.

SURROUNDING OWNERS

BLDG. DIMENSIONS FIN GR.

BLDG. TIES FL'R. GRADES

APRON TYPE WIDTH THICKNESS

SIDEWALK TYPE WIDTH THICKNESS

CULVERT TYPE DIA., LENGTH

ROCK OUTCROPPINGS

WATER MAIN SIZE, LOCATION

SAN. SEWER SIZE % OR. LOC.

SAN. MH. CAST. ELEV. INV. ELEV.

SAN. CONN. SIZE, LOC. DEPTH

STORM SEWER SIZE % OR. LOC.

STORM MH. CAST ELEV. INV. ELEV.

PAV'T TYPE GRADE CURBS

GAS LINE LOC. SIZE PRESSURE

SEPTIC TANK LOCATION & DUPLICATION AREA

WELL LOCATION

ISOLATION RADIUS FROM WELL

REVISIONS

NO.	DATE	BY
1		
2		
3		
4		
5		

PLAN PREPARED BY:

BABCOCK JONES & ASSOCIATES, INC.

PAINESVILLE, OHIO

DRAWN BY

B.P.

SCALE

1"=30'

PHONE NO.

440-357-1811

CHK'D.

H.J.

DATE

8/9/02

DRAWING NO.

99-185-39

CREW CHIEF

R.B.

APP'D

H.J.

"AS BUILT" CERTIFICATION

I, HEREBY CERTIFY THAT THE CIRCLED GRADES ARE EXISTING FINISH GRADES CHECKED IN THE FIELD ON 8-30-02, 2002, AND ARE CORRECT TO THE BEST OF MY KNOWLEDGE AND BELIEF.

REGISTERED SURVEYOR

REG. NO.

BM - SANITARY MANHOLE #5

ELEV - 710.47

Grading Plan Approved

as shown and/or noted

JAMES R. GILLS, P.E.

Lake County Engineer

By GJH Date 8-30-02

EXISTING UTILITIES NOTE:

THE SIZE AND LOCATION, BOTH HORIZONTAL AND VERTICAL OF THE UNDERGROUND UTILITIES SHOWN HEREON, HAVE BEEN OBTAINED BY A SEARCH OF AVAILABLE RECORDS. VERIFICATION BY FIELD OBSERVATION HAS BEEN CONDUCTED WHERE PRACTICAL, HOWEVER, BABCOCK, JONES AND ASSOCIATES INC. DOES NOT GUARANTEE THE COMPLETENESS NOR ACCURACY THEREOF.

STATE OF OHIO

HARRY S. JONES, JR.

S-6343

PROFESSIONAL SURVEYOR