


VACANT
S/L 5
1.1817 ACRES

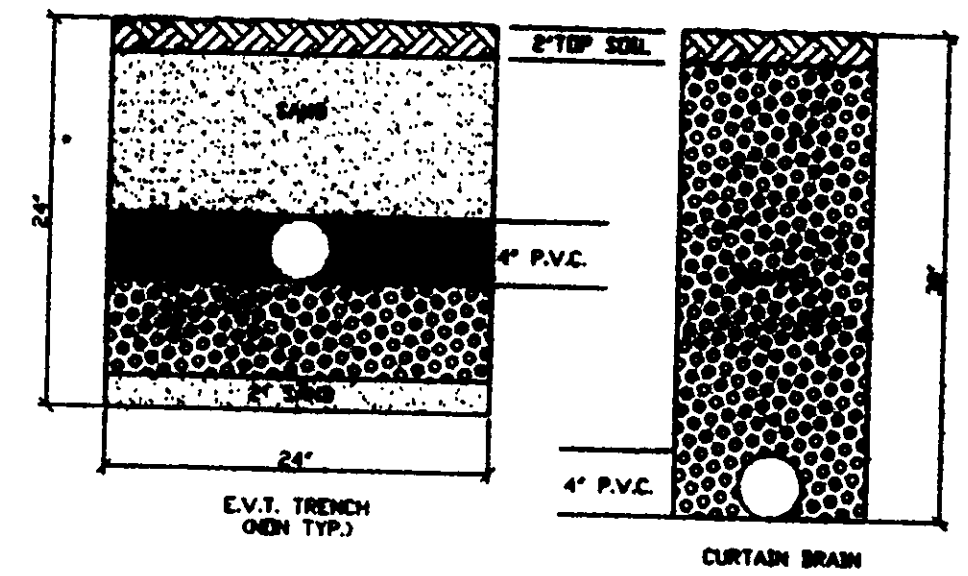

① R = 525.71'
L = 47.86'
C = 47.84'
B = S. 79°00'52" W.
D = 05°12'56"

② R = 525.71'
L = 125.00'
C = 124.70'
B = S. 69°35'42" W.
D = 13°37'24"

ZONING PERMIT #0999-9569
ISSUED 6/1/20

SUBJECT TO APPROVAL BY:
 Lake County Sanitary Eng. ☐
 Lake County Eng. Dept. ☒
 Lake County Planning Comm. ☒
 Lake County Bldg. Dept. ☒

**Grading Plan Approved
as shown and/or noted
THOMAS P. GILLES, P.E.
Lake County Engineer**


By John Date 9/16/95
Sworn as shown

ROOF DRAINS
SHALL DISCHARGE
TO SPLASH BLOCK

DESIGN CERTIFICATION
I, THE UNDERSIGNED, HEREBY CERTIFY THAT THIS
ELEVATION IS INDICATED BY CONTIGUOUS AND EXISTING
ELEVATIONS SURVEY HEREIN REPRESENTS AN ACTUAL
SURVEY MADE BY ME ON 12-1-1980
AND THAT THE ELEVATIONS WERE TAKEN AT THE APPROPRIATE
INTERVALS AND AS OF THAT DAY THEY EXISTED AS
INDICATED HEREIN.

I FURTHER CERTIFY THAT THIS PLAN WAS PREPARED BY ME FROM AN ACTUAL SURVEY AND HIGH PRIS WERE FOUND OR SET AT THE PROPERTY CORNERS AND ALL OF WHICH IS CORRECT TO THE BEST OF MY KNOWLEDGE AND BELIEF.

BY: John C. Thompson
REG. NO. RS 6786

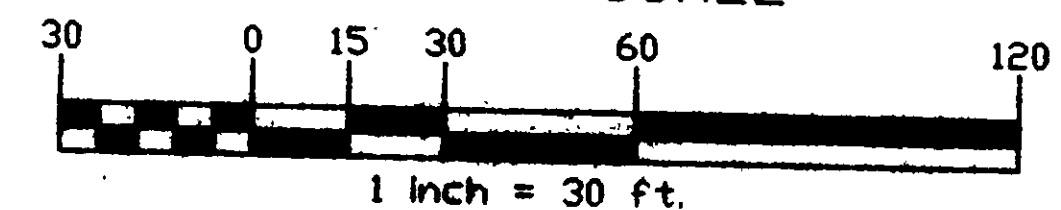

REVISED 1' = 30'		APPROVED	DESIGN BY SWC
DATE JUNE 99			REVISED
BEING SUBLOT 4 IN TH DEVONSHIRE SUB-DIVISION			
CITY OF CONCORD, COUNTY OF LAKE, STATE OF OHIO			
JOB# 99-2792			99-1790

Date 9-8-99 BY Daniel Lark

SEWAGE DISPOSAL PERMIT MUST BE
OBTAINED BY A LAKE COUNTY LICENSE
INSTALLER BEFORE INSTALLATION IS
STARTED

**2 WORKING DAYS
BEFORE YOU DIG**

CALL TOLL FREE 800-362-2764

CALL US FOR YOUR FREE INFORMATION

----- EXISTING
 ----- PROPOSED GRADES
 ~~~~~ SWALE