

SITE PLAN
for: ANDREWS BLDGS.


35475 VINE ST. EASTLAKE
ADDRESS STREET CITY

3 DEVONSHIRE VOL. PAGE
SUBLOT NO. SUBDIVISION NAME
4-5-2 CONCORD TWP. OHIO
LOT TRACT CITY

CUTSKY & ASSOCIATES, INC.
Civil Engineers and Surveyors

3911 Parkside Ave.
Cleveland, Ohio 44114
Tel (216) 881-5700
Fax (216) 881-3111

CHECK LIST
1. LOT DIMENSIONS SHOWN
2. SUBLOT NO. (PARCEL NO.)
3. BUILDING DIMENSIONS
4. SANITARY SEWER, REAR YARD
5. DRIVE & APRON TYPE, WIDTH, THICKNESS
6. DRAINAGE TYPE, DRAIN LENGTH
7. WATER MAIN SIZE, LOCATION, LOCATION
8. SAN. W. CAST. ELEV. (INVERT ELEV.)
9. SAN. CONN. SIZE & GRADE, LOCATION
10. STORM W. CAST. ELEV. (INVERT ELEV.)
11. STORM W. CONN. SIZE & GRADE, LOCATION
12. SEPTIC SYSTEM & ISOLATION RADII

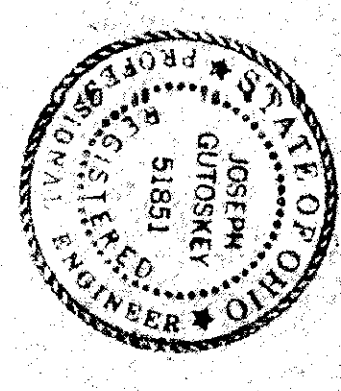

DESIGN CERTIFICATION
THIS PLAN WAS PREPARED BY ME, AND IS CORRECT
TO THE BEST OF MY KNOWLEDGE AND BELIEF.

NAME: Joseph Gutoskey
DATE: 12/17/93

"AS-BUILT" CERTIFICATION
I HEREBY CERTIFY THAT THE CIRCLED INFORMATION IS EXISTING
AS OBTAINED ON THE SITE
CORRECT TO THE BEST OF MY KNOWLEDGE AND BELIEF.


LEGEND	NAME	SCALE
STORM MANHOLE	○	1" = 20'
SANITARY MANHOLE	○	1" = 20'
EXISTING CONTOURS	---	1" = 20'
PROPOSED CONTOURS	---	1" = 20'
EXIST. ELEV.	---	1" = 20'
PROPOSED ELEV.	---	1" = 20'
DIRECTION OF SURFACE DRAINAGE	---	1" = 20'

BENCHMARK: S. INV. OF EXIST. 15" CULVERT @ R. S. 1.344
ELEVATION: 789.72

APPROVED AS NOTED
SUBJECT TO LANE COUNTY HEALTH DEPARTMENT REVIEW
APPROVED: [Signature]
DATE: 12/17/93

I, THE UNDERSIGNED HEREBY DECLARES THAT THE TOPOGRAPHY SHOWN
HEREON, INDICATED BY ONE FOOT CONTOURS AND ELEVATIONS
REPRESENTS AN ACTUAL FIELD TOPOGRAPHY SURVEY MADE UNDER MY
SUPERVISION ON THE 3rd DAY OF DECEMBER, 1993, AND THAT THE
ELEVATIONS WERE TAKEN AT APPROPRIATE INTERVALS AND THAT THE
DATE THEY EXISTED AS INDICATED HEREON.

EDWARD L. DEBEVEC, JR.
NO. 4314

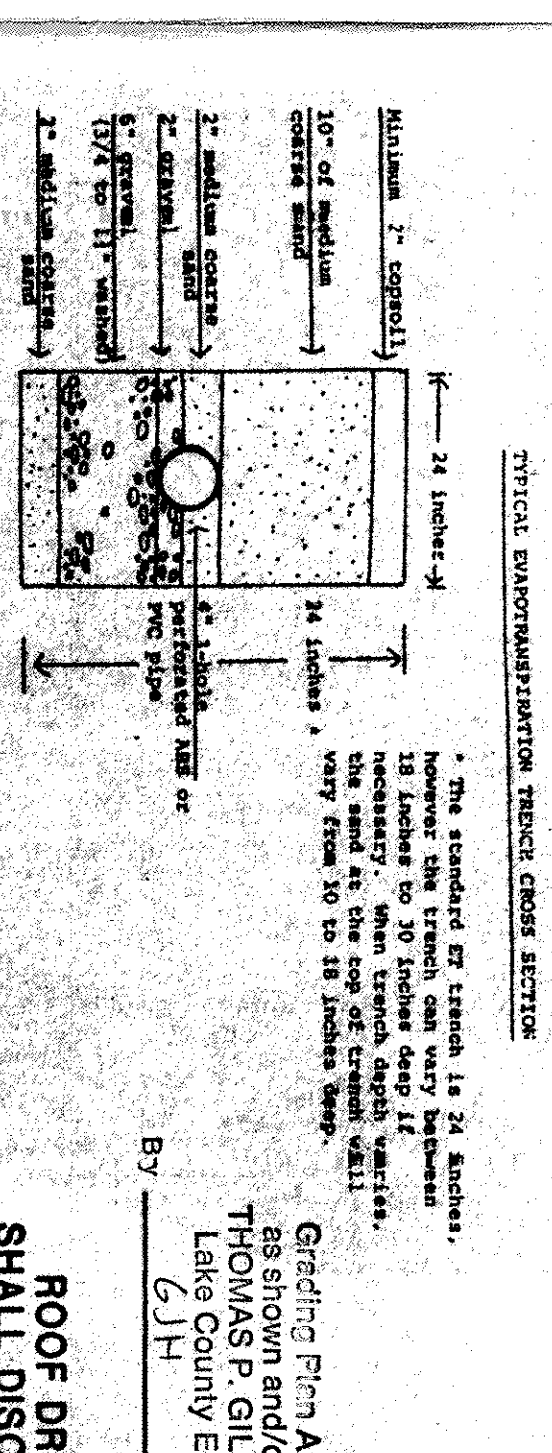

ROOF DRAINS
SHALL DISCHARGE
TO SPLASH BLOCKS.

ISSUED: 3-14-94
ZONING PERMIT #0394-7708
SUBJECT TO APPROVAL BY:
Lake County Sanitary Eng. Dept. []
Lake County Planning Comm. []
Lake County Bldg. Dept. []

LANE COUNTY GENERAL HEALTH DISTRICT
9-11-94
JAMES L. LUKA, R.S., M.E., R.L.
Health Commissioner

SEWAGE DISPOSAL PERMIT MUST BE
OBTAINED BY A LANE COUNTY LICENSED
INSTALLER BEFORE INSTALLATION IS
STARTED.

LOW YIELD WATER
FIXTURES REQUIRED
ON ALL
Shower Head
Toilet

