
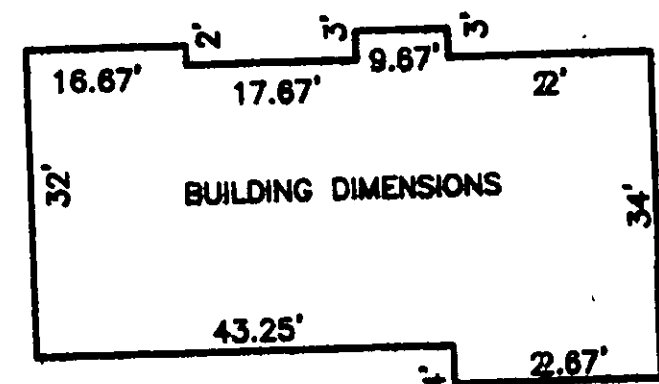
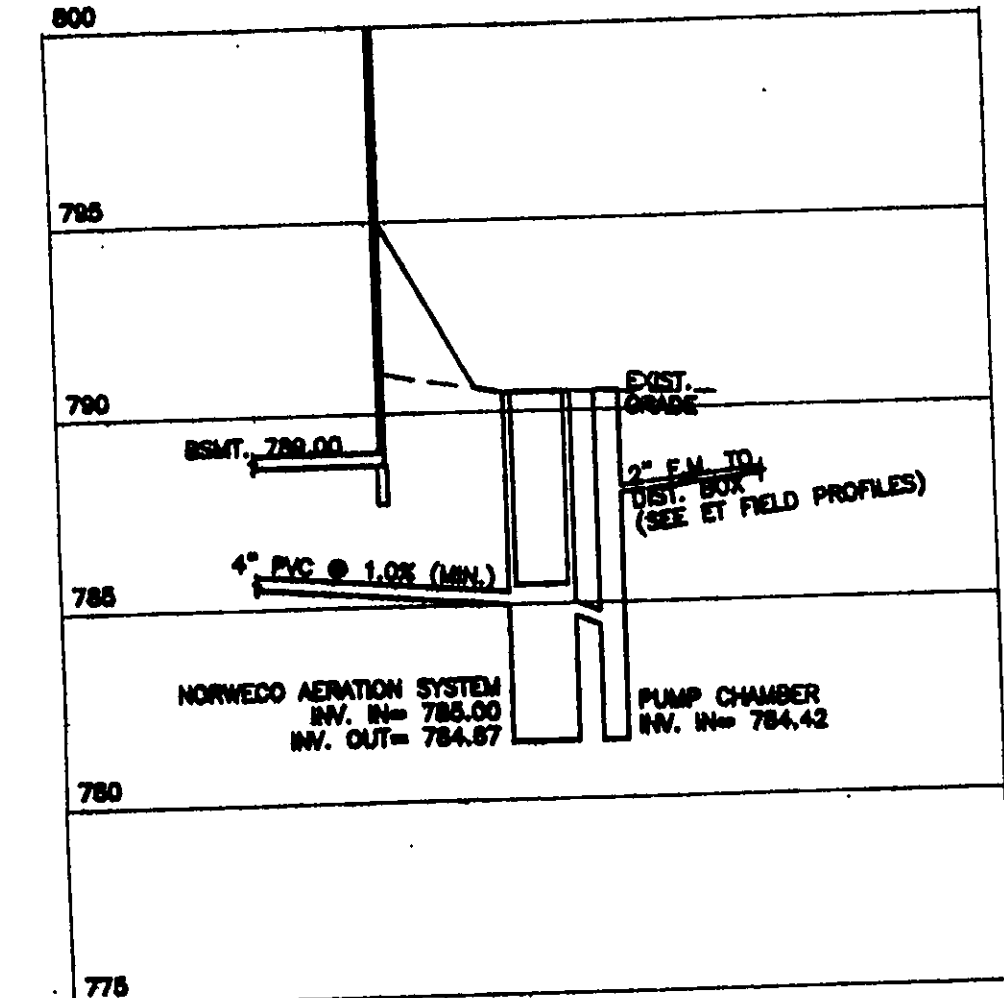
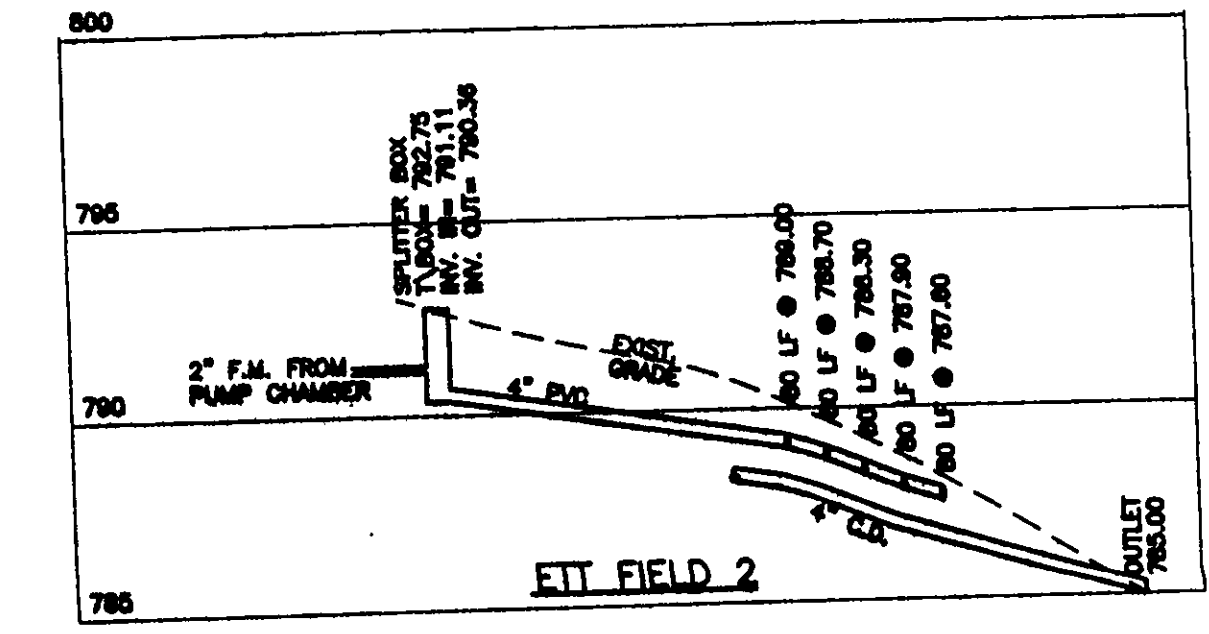
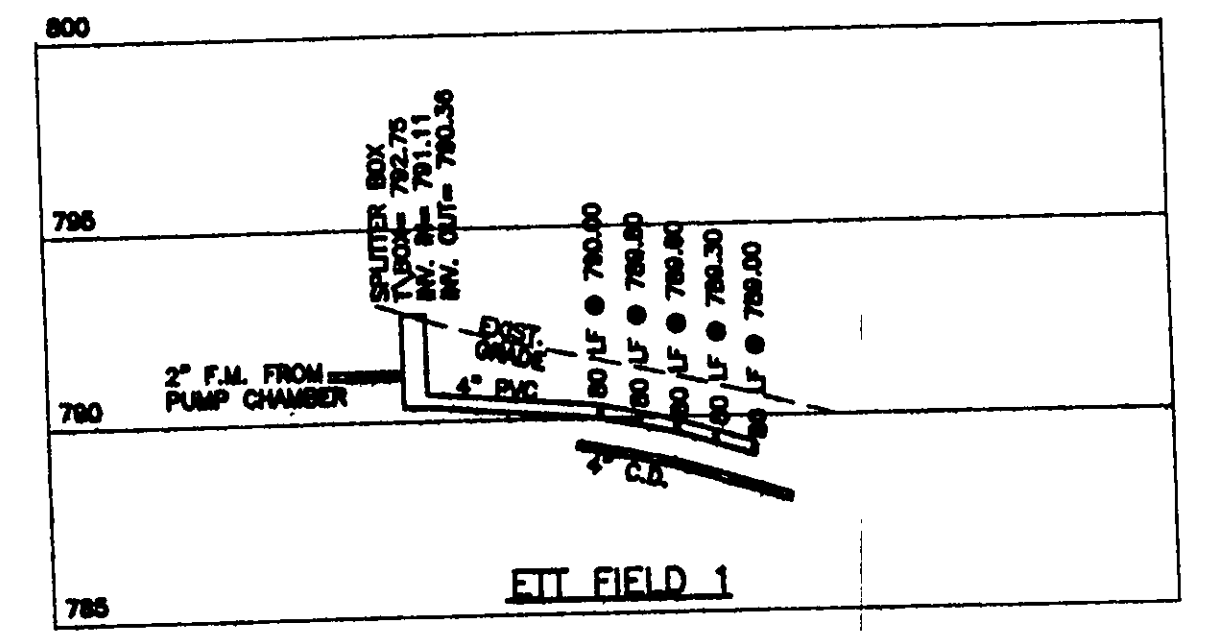
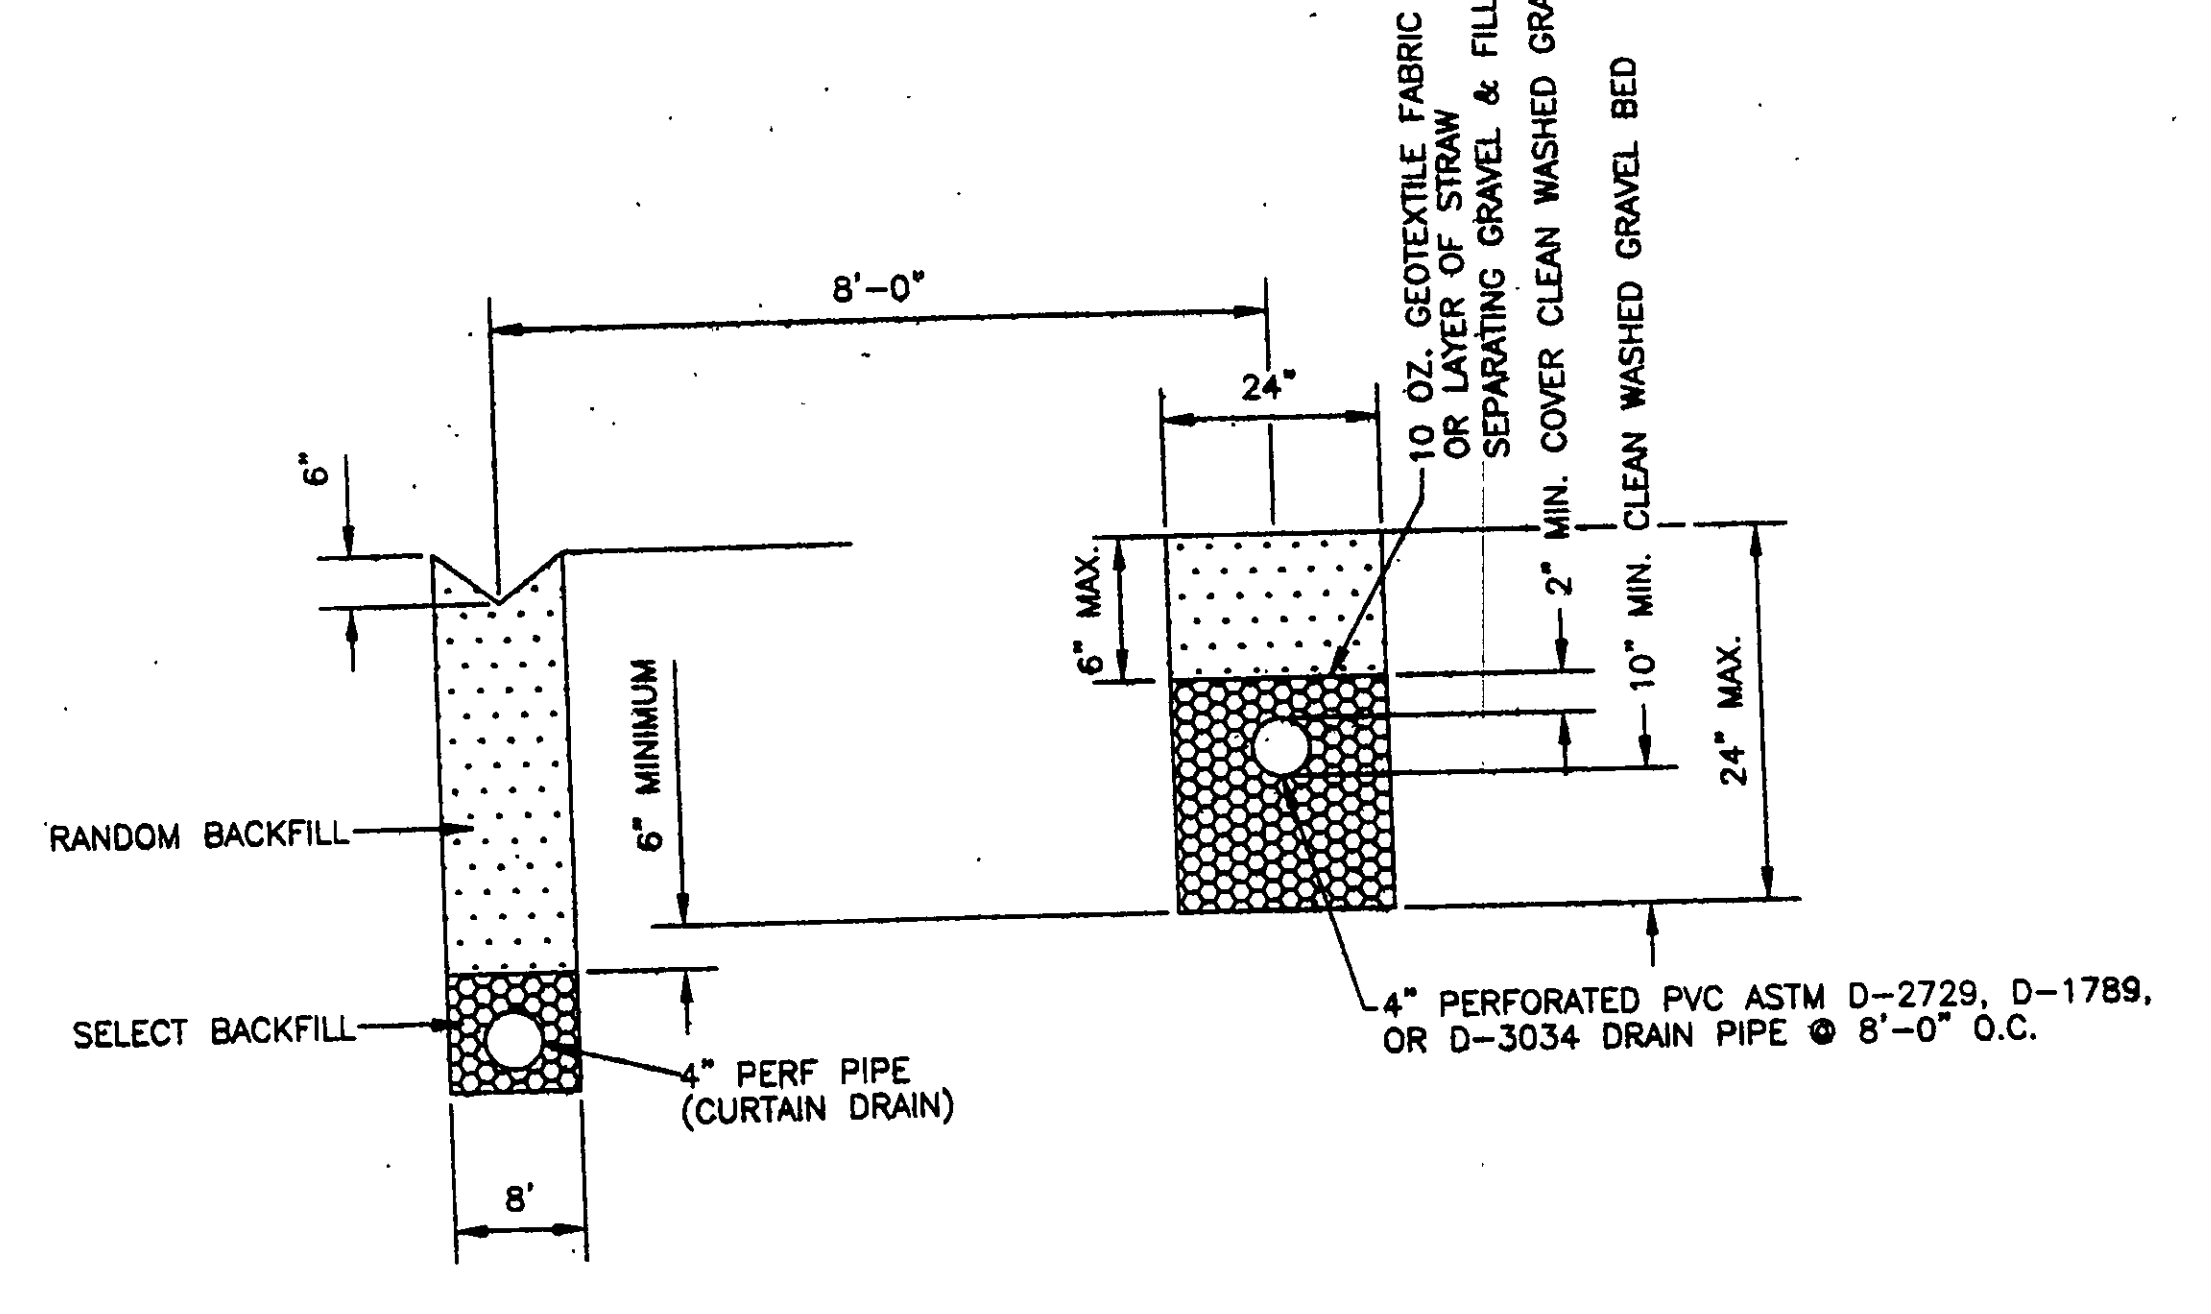
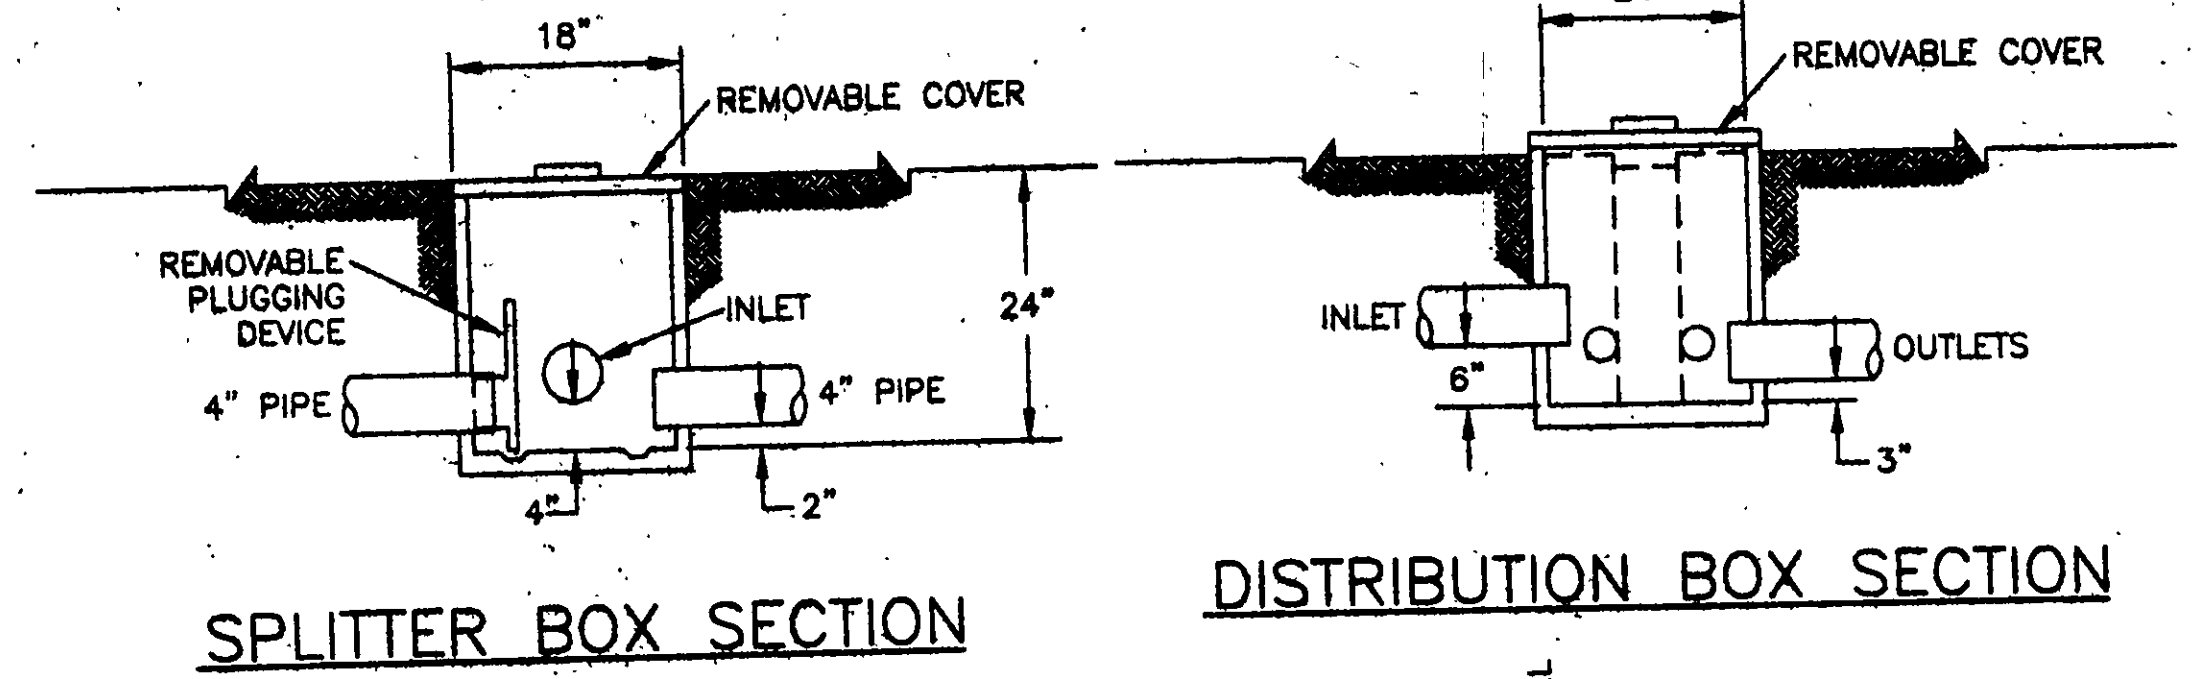


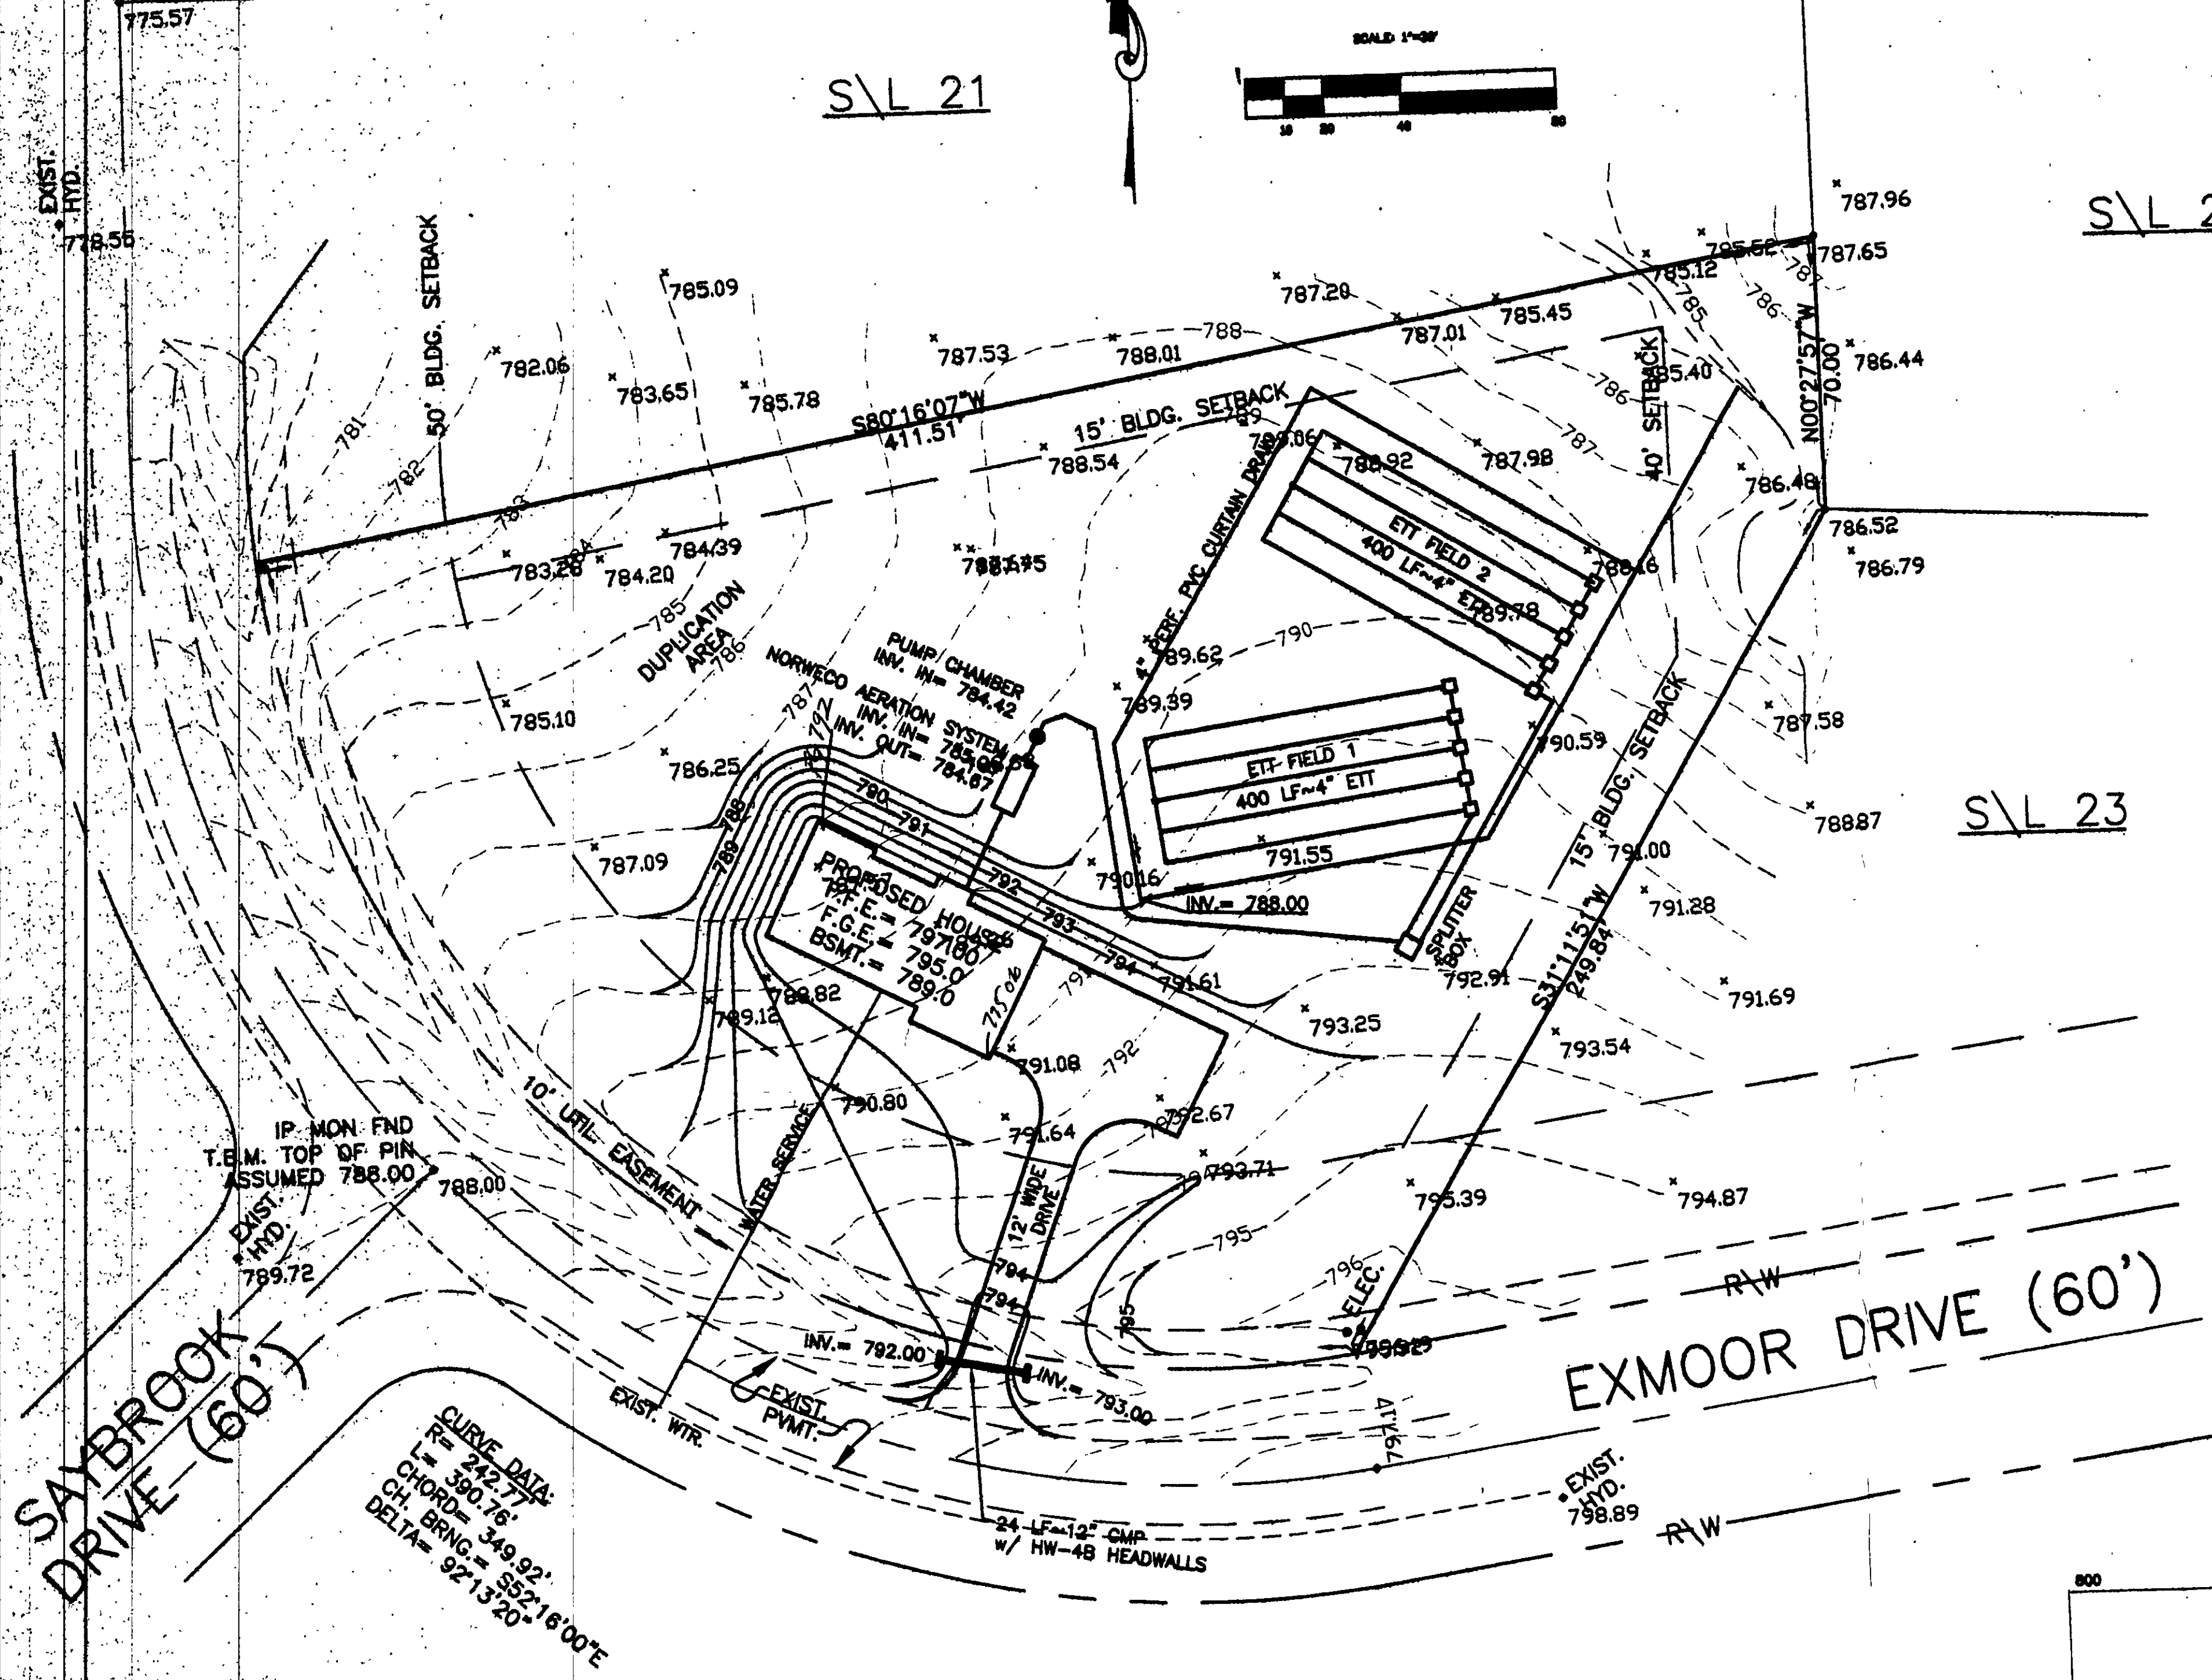

Grading Plan Approved
as shown and/or noted
JAMES R. GILLS, P.E.
Lake County Engineer
By: *TAM* Date: 4/23/01
Low Fg as noted
ROOF DRAINS
SHALL DISCHARGE
TO SPLASH BLOCKS.


PLAN VIEW

CONCORD TOWNSHIP ZONING OFFICE
ZONING PERMIT # 0401-10094
ISSUED 4-16-2001
SUBJECT TO APPROVAL BY:
☐ Lake Co. Sanitary Engineer
☐ Lake Co. Eng. Dept.
☐ Lake Co. Planning Comm.
☐ Lake Co. Building Dept.
☐ Lake Co. Soil & Water Cons. Dist.

NOTE:
CONTRACTOR TO VERIFY
LOCATION AND DEPTH
OF EXISTING UTILITIES
PRIOR TO COMMENCEMENT
OF EXCAVATION

REVIEWED AND ACCEPTED
LAKE COUNTY GENERAL
HEALTH DISTRICT
Date: 4-10-01 *David*
4/10/01 *David*
SEWAGE DISPOSAL PERMIT MUST BE
OBTAINED BY A LAKE COUNTY LICENSED
INSTALLER BEFORE INSTALLATION IS
STARTED.

THE UNDERSIGNED HEREBY CERTIFY THAT THIS TOPOGRAPHY, INDICATED BY 1' CONTOURS, AND THE ELEVATIONS SHOWN HEREON REPRESENT AN ACTUAL FIELD SURVEY MADE BY WILLIAM R. GRAY ASSOC. INC. ON THE 2 DAY OF MARCH 2001 AND THAT THE ELEVATIONS WERE TAKEN AT APPROPRIATE INTERVALS AND THAT AS OF THAT DATE THEY EXISTED AS INDICATED HEREON.

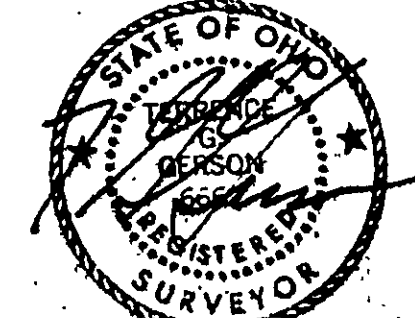

WILLIAM R. GRAY ASSOCIATES, INC.
7519 MENTOR AVE. MENTOR, OHIO 44060
(440) 946-1616

DATE: 3-21-01
DRAWN BY: J.H.
CHECKED BY: TCG
SCALE: 1" = 30'

SITE PLAN S/L 22
DEVONSHIRE SUBDIVISION
CONCORD, TWP., COUNTY OF LAKE, STATE OF OHIO

S.M.A. COMMERCIAL, LTD.
35110 EUGLID AVE.
WILLOUGHBY, OHIO 44094

SHEET NO. 1/1

DATE: 3-21-01