

SITE PLAN FOR:

RYAN HOMES
8141 TYLER BLVD
MENTOR, OHIO
BEING SUBLT NO 3 IN THE
FAR HILLS ESTATES SUBDIVISION
NO 2 IN CONCORD, OHIO


PREPARED BY:

WM GRAY ASSOC INC
7547 MENTOR AVE
MENTOR, OHIO
SCALE: 1" = 30'
DATE: AUG 10, 1977

CERTIFICATION:

I HEREBY CERTIFY THAT
THIS PLAT IS CORRECT TO THE
BEST OF MY KNOWLEDGE

BY: Terrence Gerson
WM R. GRAY REG SURV #2752
TERRENCE G GERSON PL #038598

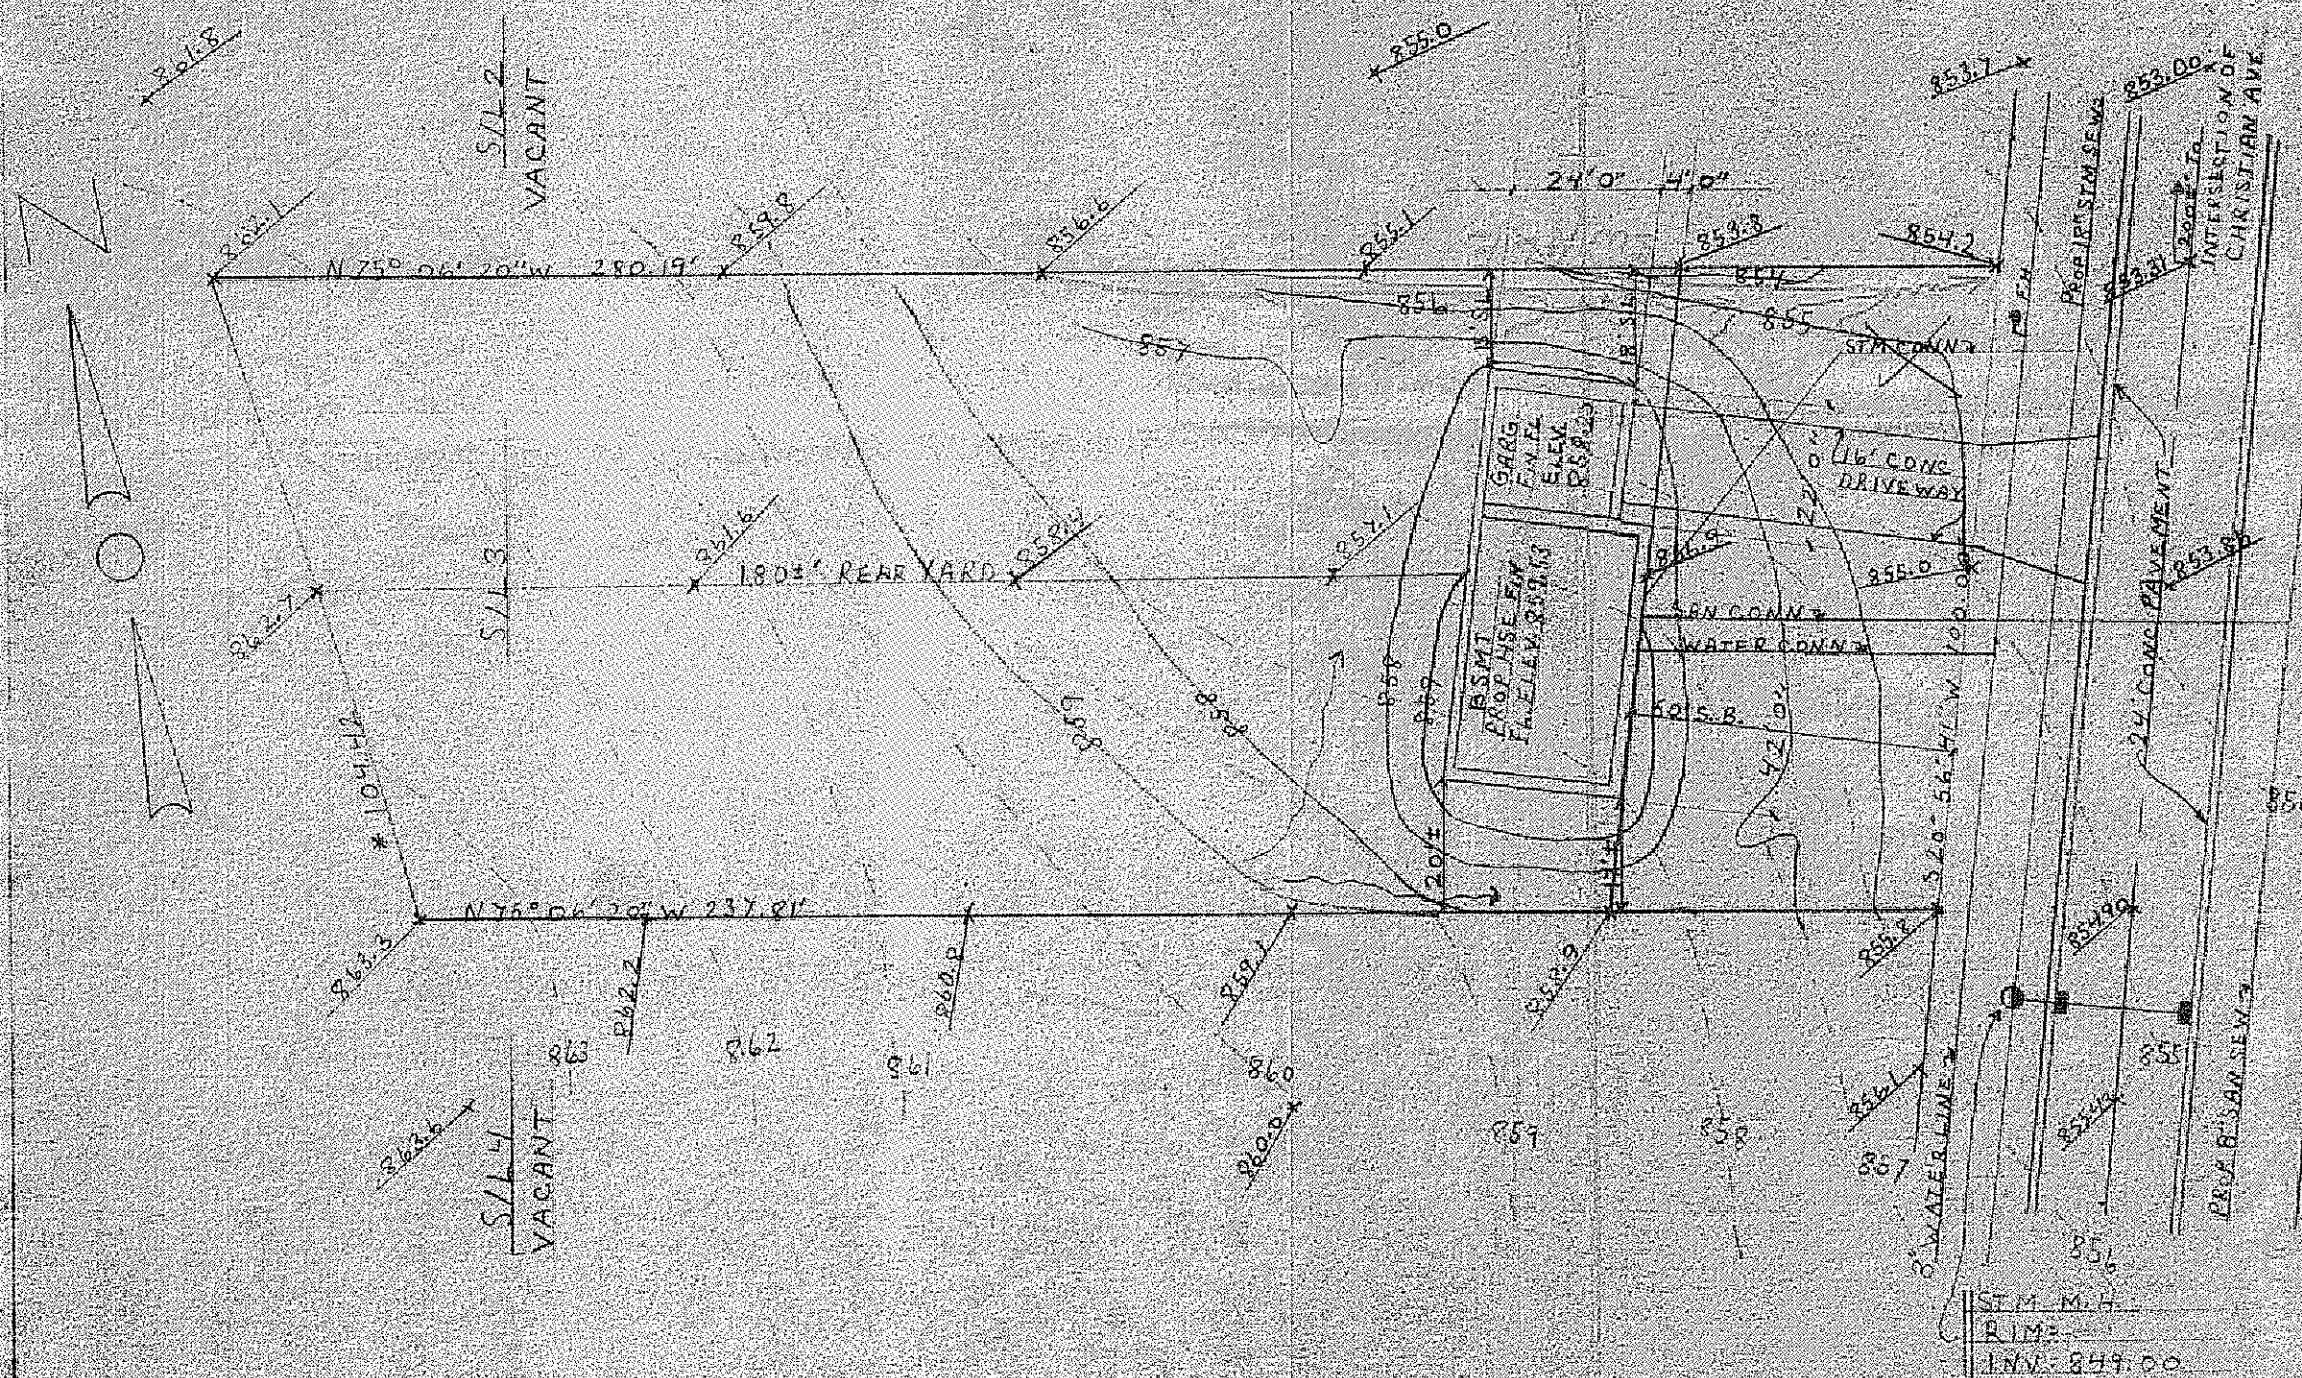

SAN M.H.
R.I.M.
INV = 844.53
USED AS B.M.

Grading Plan Approved
as shown and/or noted
THOMAS P. GILLES,
Lake County Eng.

By T.G. 29 Aug 77
no Stm. Conn.

*CURVE DATA
R = 290.93'
Δ = 2° 03' 34"
A = 104.42'
T = 52.22'
C = 104.42'
S 2° 51' 31" E

ST M.M.H.
R.I.M.
INV = 849.00

FAR HILL DRIVE

POTOMAC

Approved
#3402
8-22-77
W.E. M... ..