

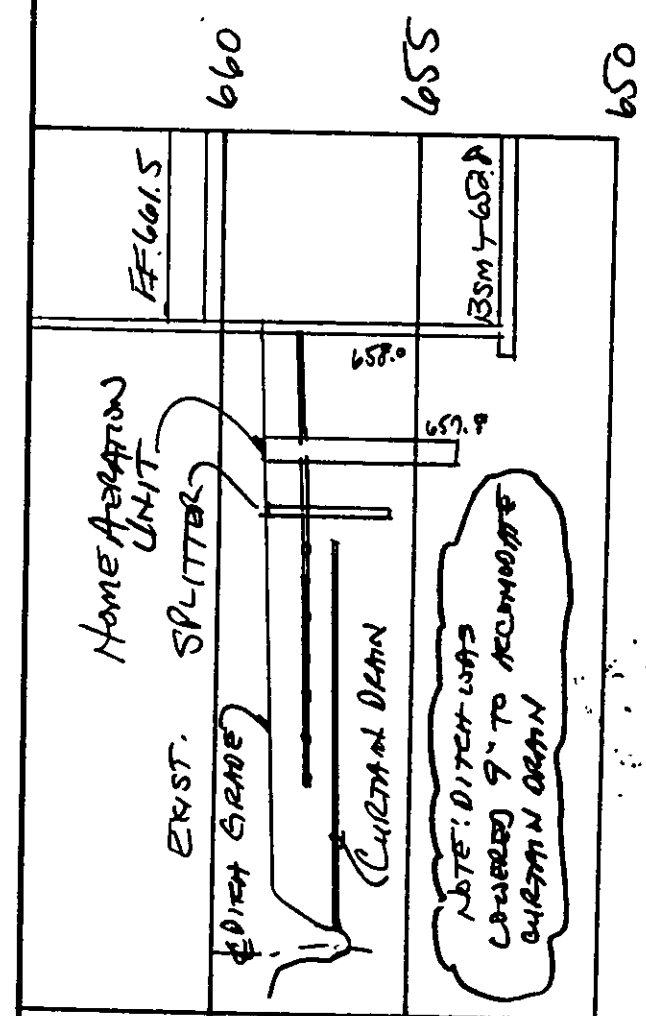
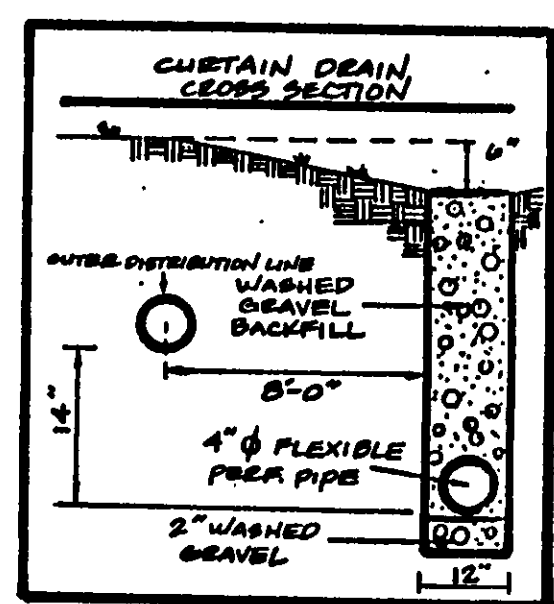


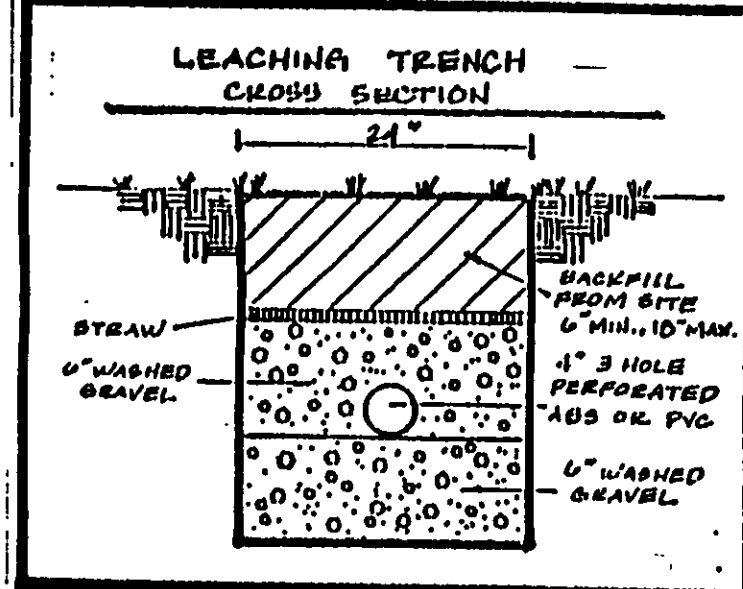

"I, the undersigned hereby certify that this topography indicated by 6", 1", or 2" contours, and elevations shown hereon represent an actual field survey made by me on the 26th day of APRIL, 1977 and that the elevations were taken at appropriate intervals and that as of that date they existed as indicated hereon."

Name Harry Jones #6343
Reg. No.

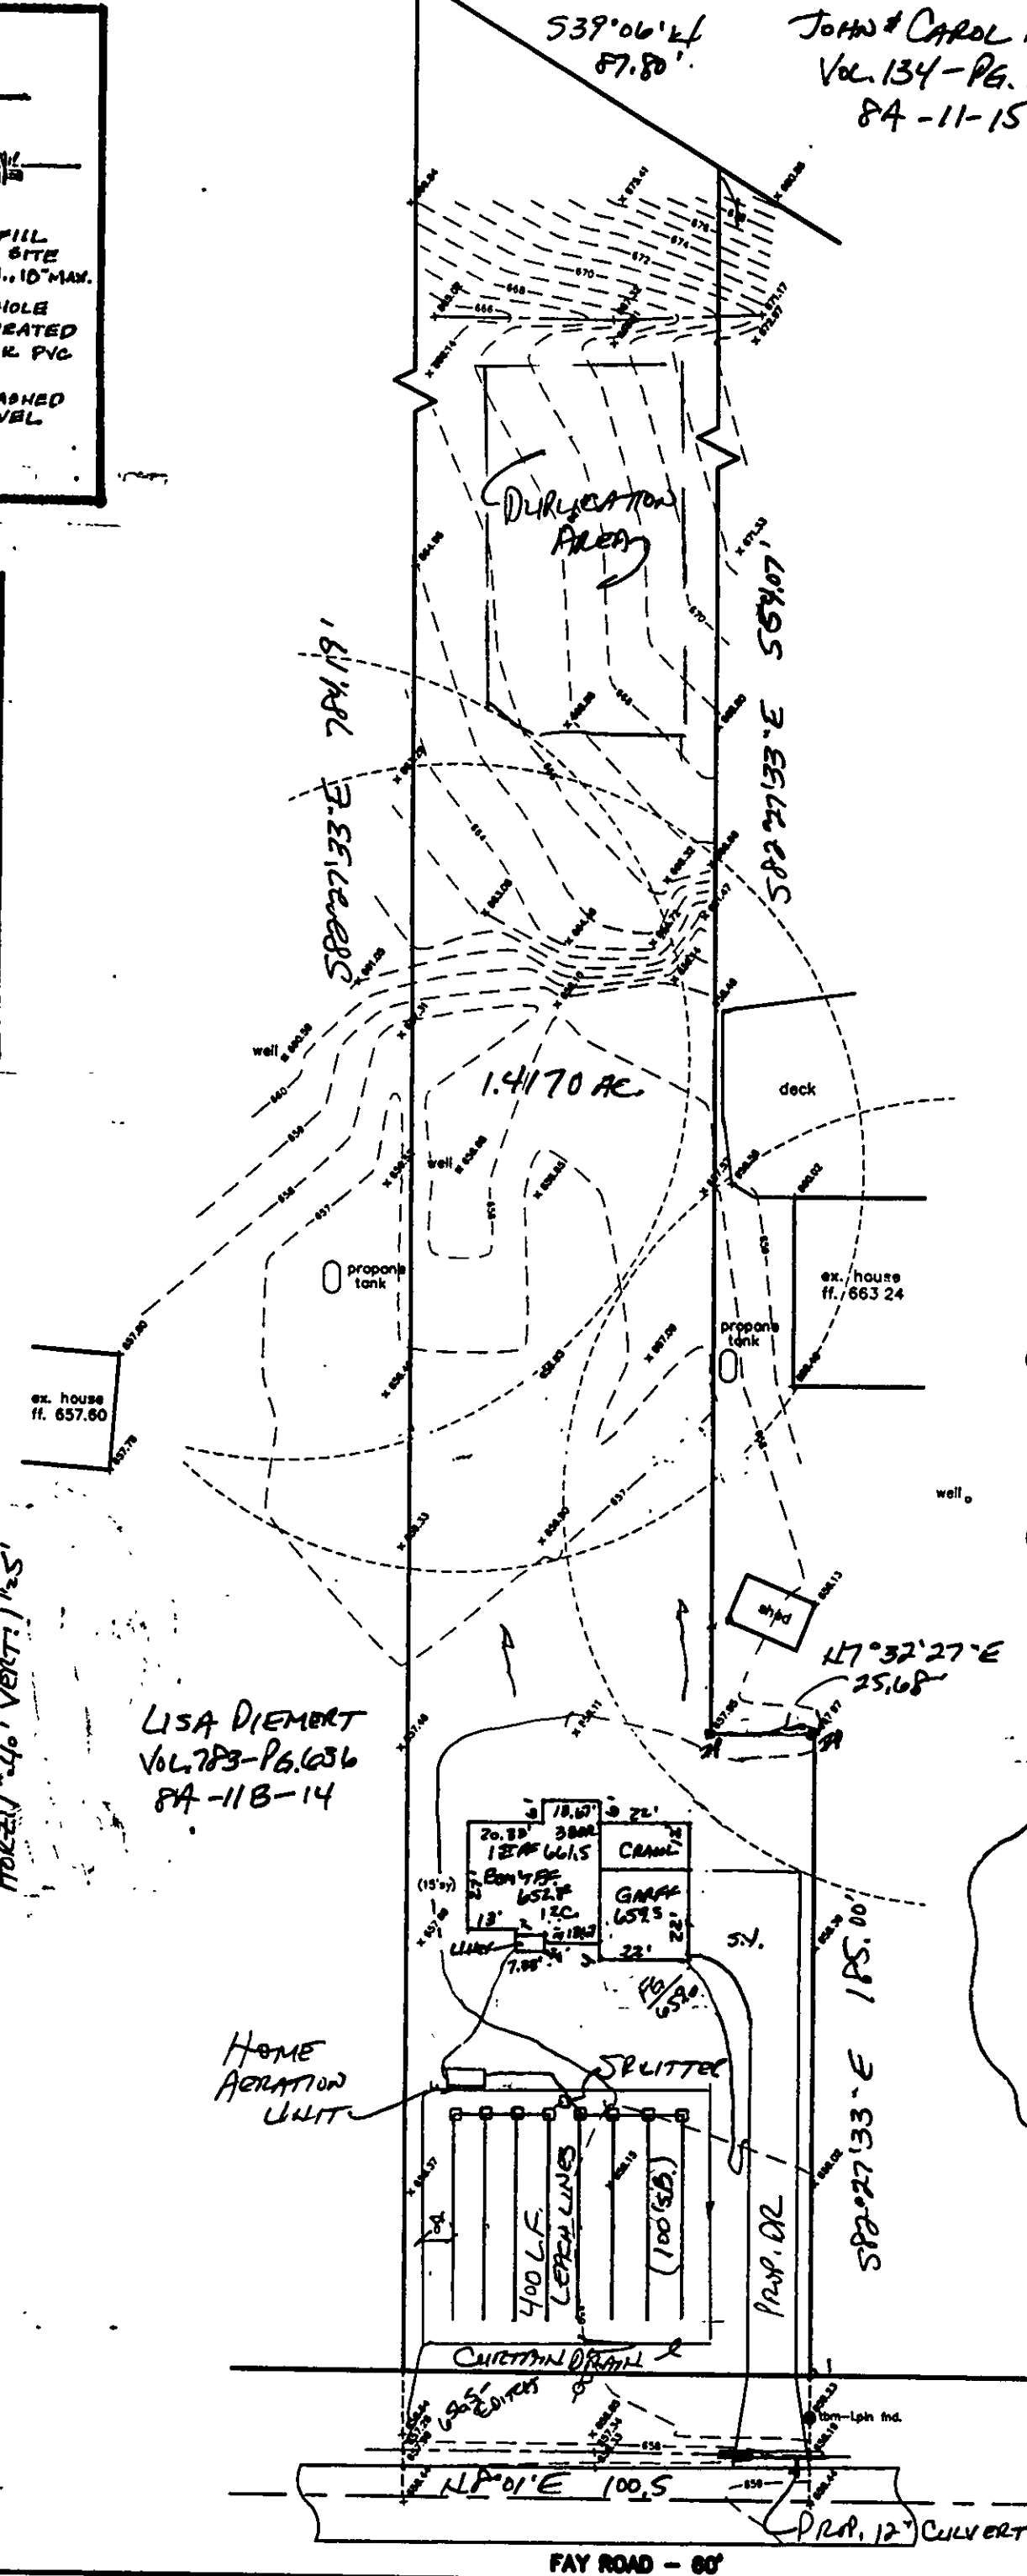

GEORGE LEHTINEN
VOL. 578, PG. 613
PA-11B-10

SOILS - TIOGA LOAM

NOTE: 100 YEAR FLOOD ELEVATION IS 651.8 PER FEMA MAP 39071 0051 C, DATED 1/2/81. ENTIRE LOT IS NOT IN 100 YEAR FLOOD ZONE.

REVIEWED AND ACCEPTED
LAKE COUNTY GENERAL HEALTH DISTRICT

Date 8-4-99 BY Dee
Trenches 8" deep

SEWAGE DISPOSAL PERMIT MUST BE OBTAINED BY A LAKE COUNTY LICENSED INSTALLER BEFORE INSTALLATION IS STARTED

SITE PLAN

CONCORD TOWNSHIP, LAKE COUNTY, OHIO

for: REV. HANNU VEPSALAINEN

508 EAGLE ST. FAIRPORT
ADDRESS STREET CITY ZIP

SUBDIVISION NAME TRACT EAY RD.
6635 VOL. PG. 578-515 STREET
SUBLOT NO. FAIRPORT VOL. PG. 8A-11B-11 PERM. PARCEL NO.

LEGEND

SANITARY MANHOLE --- 1
STORM MANHOLE --- 2
INLET OR CATCH BASIN --- 3
HYDRANT --- 4
EXISTING CONTOURS --- 5
PROPOSED CONTOURS --- 6

EXIST. ELEV. 100.0
100.0 ± 2 PROP. ELEV.
AS BUILT ELEVATION
INDICATES DIRECTION OF SURFACE DRAINAGE

REMARKS

ALL BOUNDARY DATA SHOWN WAS OBTAINED FROM (DEEDS, RECORDED SUBDIVISION PLAT OR OTHER PUBLIC RECORDS)

LOCATIONS AS SHOWN OF ADJACENT WELLS AND SEPTIC TANKS OBTAINED FROM LAKE COUNTY HEALTH DEPARTMENT

DESIGN CERTIFICATION

THIS PLAT WAS PREPARED BY ME, AND IS CORRECT TO THE BEST OF MY KNOWLEDGE AND BELIEF.

NAME Harry Jones #6343
SURVEYOR REGISTRATION NO.

CHECK LIST

NO. OF BEDROOMS
DIMENSIONS
BEARINGS
TIE TO NEAREST STREET
SUBLOT NO. PARCEL NO.
SURROUNDING OWNERS
BLDG. DIMENSIONS FIN GR.
BLDG. TIES PL. R. GRADES
APRON TYPE WIDTH THICKNESS
SIDEWALK TYPE WIDTH THICKNESS
CULVERT TYPE DIA. LENGTH
ROCK OUTCROPPINGS

WATER MAIN SIZE, LOCATION
SAN. SEWER SIZE & GR. LOC.
SAN. MH. CAST. ELEV. INV. ELEV.
SAN. CONN. SIZE, LOC. DEPTH
STORM SEWER SIZE & GR. LOC.
STORM MH. CAST. ELEV. INV. ELEV.
PAV'T TYPE GRADE CURBS
GAS LINE LOC. SIZE PRESSURE
SEPTIC TANK LOCATION & DUPLICATION
WELL LOCATION
ISOLATION RADIUS FROM WELL

REVISIONS			PLAN PREPARED BY:		
NO.	DATE	BY	Bj BABCOCK JONES & ASSOCIATES, INC.		
1	4/20/77	HT	PAINESVILLE, OHIO		
2	6/18/77	HT	DRAWN BY T.R. SCALE 1"=40'		
3	7/1/77	HT	CHK'D. H.J. DATE 3/29/99		
4	8/1/77	HT	CREW CHIEF K.J. APP'D H.J.		
5			PHONE NO. 440-357-1811		
			DRAWING NO. 99-035		

"AS BUILT" CERTIFICATION
I, HEREBY CERTIFY THAT THE CIRCLED GRADES ARE EXISTING FINISH GRADES CHECKED IN THE FIELD ON 19____, 19____ AND ARE CORRECT TO THE BEST OF MY KNOWLEDGE AND BELIEF.

REGISTERED SURVEYOR REG. NO.

TBM-IRON PIN FOUND
ELEV.=659.23

ZONING PERMIT #0899-7520

ISSUED 8/11/99

SUBJECT TO APPROVAL BY:
Lake County Sanitary Eng. ☐
Lake County Eng. Dept. ☒
Lake County Planning Comm. ☐
Lake County Bldg. Dept. ☒

