



REVISIONS	BY

Barrington
CONSULTING GROUP, INC.
9114 TYLER BLVD., MENTOR, OHIO 44060
PHONE 440.285.1260 FAX 440.285.1262
www.BarringtonCGI.com



SITE PLAN
8096 FERNWAY CT., CONCORD TWP., OHIO 44077
SL 14 CROSSROADS AT SUMMERWOOD PH. 1 VOL. 53 PG. 23
NOSTALGIA HOMES

DRAWN VSD	1/2
CHECKED DWN	
DATE OCT. 08, 2008	
SCALE 1" = 40'	
JOB NO. 07008-014	SHEET
87008-014	

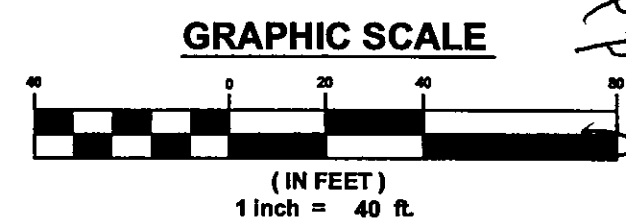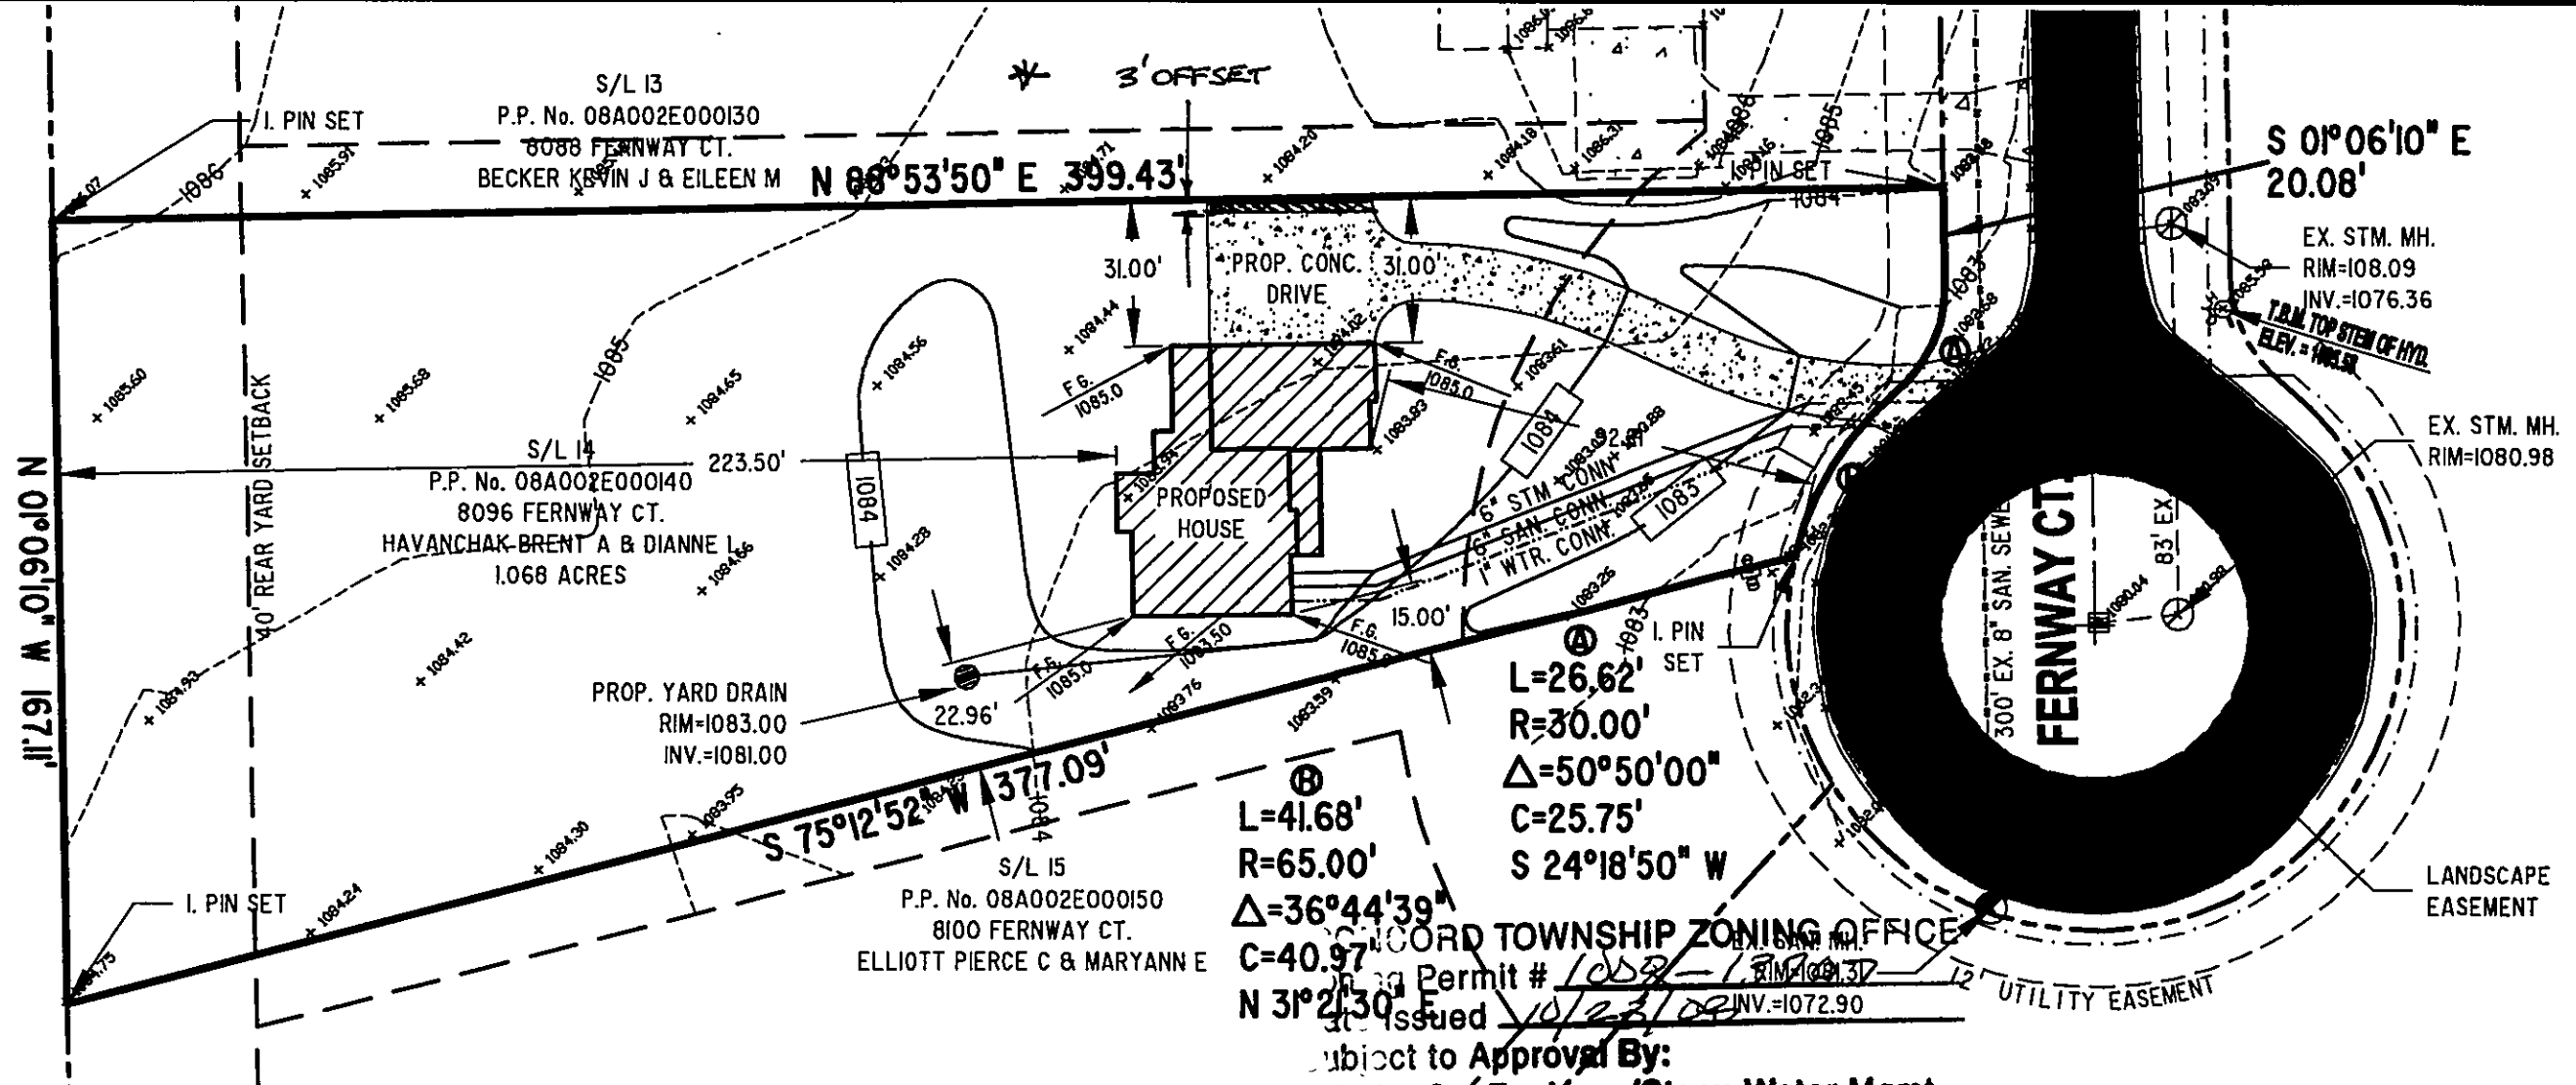

CERTIFICATION :


"I THE UNDERSIGNED HEREBY CERTIFIES THAT THIS TOPOGRAPHY INDICATED BY 1 FOOT CONTOURS AND ELEVATION SHOWN HEREON REPRESENTS AN ACTUAL SURVEY MADE BY ME ON THE 7th DAY OF OCTOBER, 2008 AND THE ELEVATIONS WERE TAKEN AT AN APPROPRIATE INTERVAL AND AS OF THAT DAY THEY EXISTED AS INDICATED HEREON.

"I HEREBY CERTIFY THAT THIS PLAN WAS PREPARED BY ME AND IS CORRECT TO THE BEST OF MY KNOWLEDGE AND BELIEF"

David W. Novak 10/20/2008
DAVID W. NOVAK, P.S. No. 7507
CERT-12000



Stormwater Management Plan HOUSE DETAIL:
Approved as shown and/or noted
JAMES R. GILLS, P.E.
County Drainage Engineer
By L.S. Date 10/24/08 **VOID**

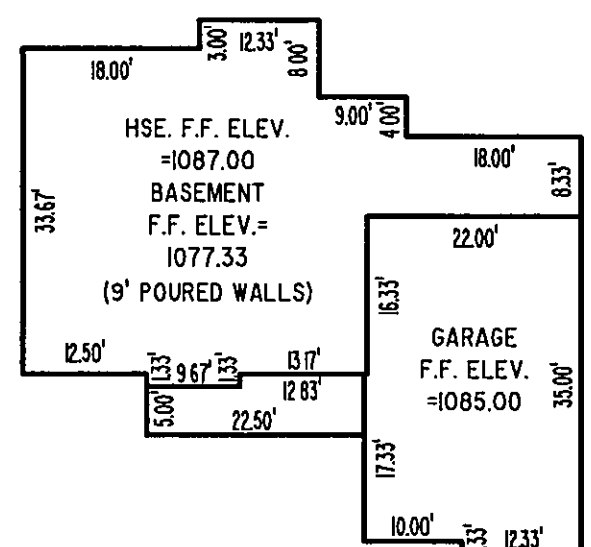

W:\2007\07008\SL 14\07008-014.dwg, 10/20/2008 4:32:16 PM, Copyright Barrington Consulting Group