


Grading Plan Approved
as shown and/or noted
THOMAS P. GILLES, P.E.
Lake County Engineer

By JWK Date 5-2

*Survey Point # 2808
marked 4-30-25
J.E. McBrist*

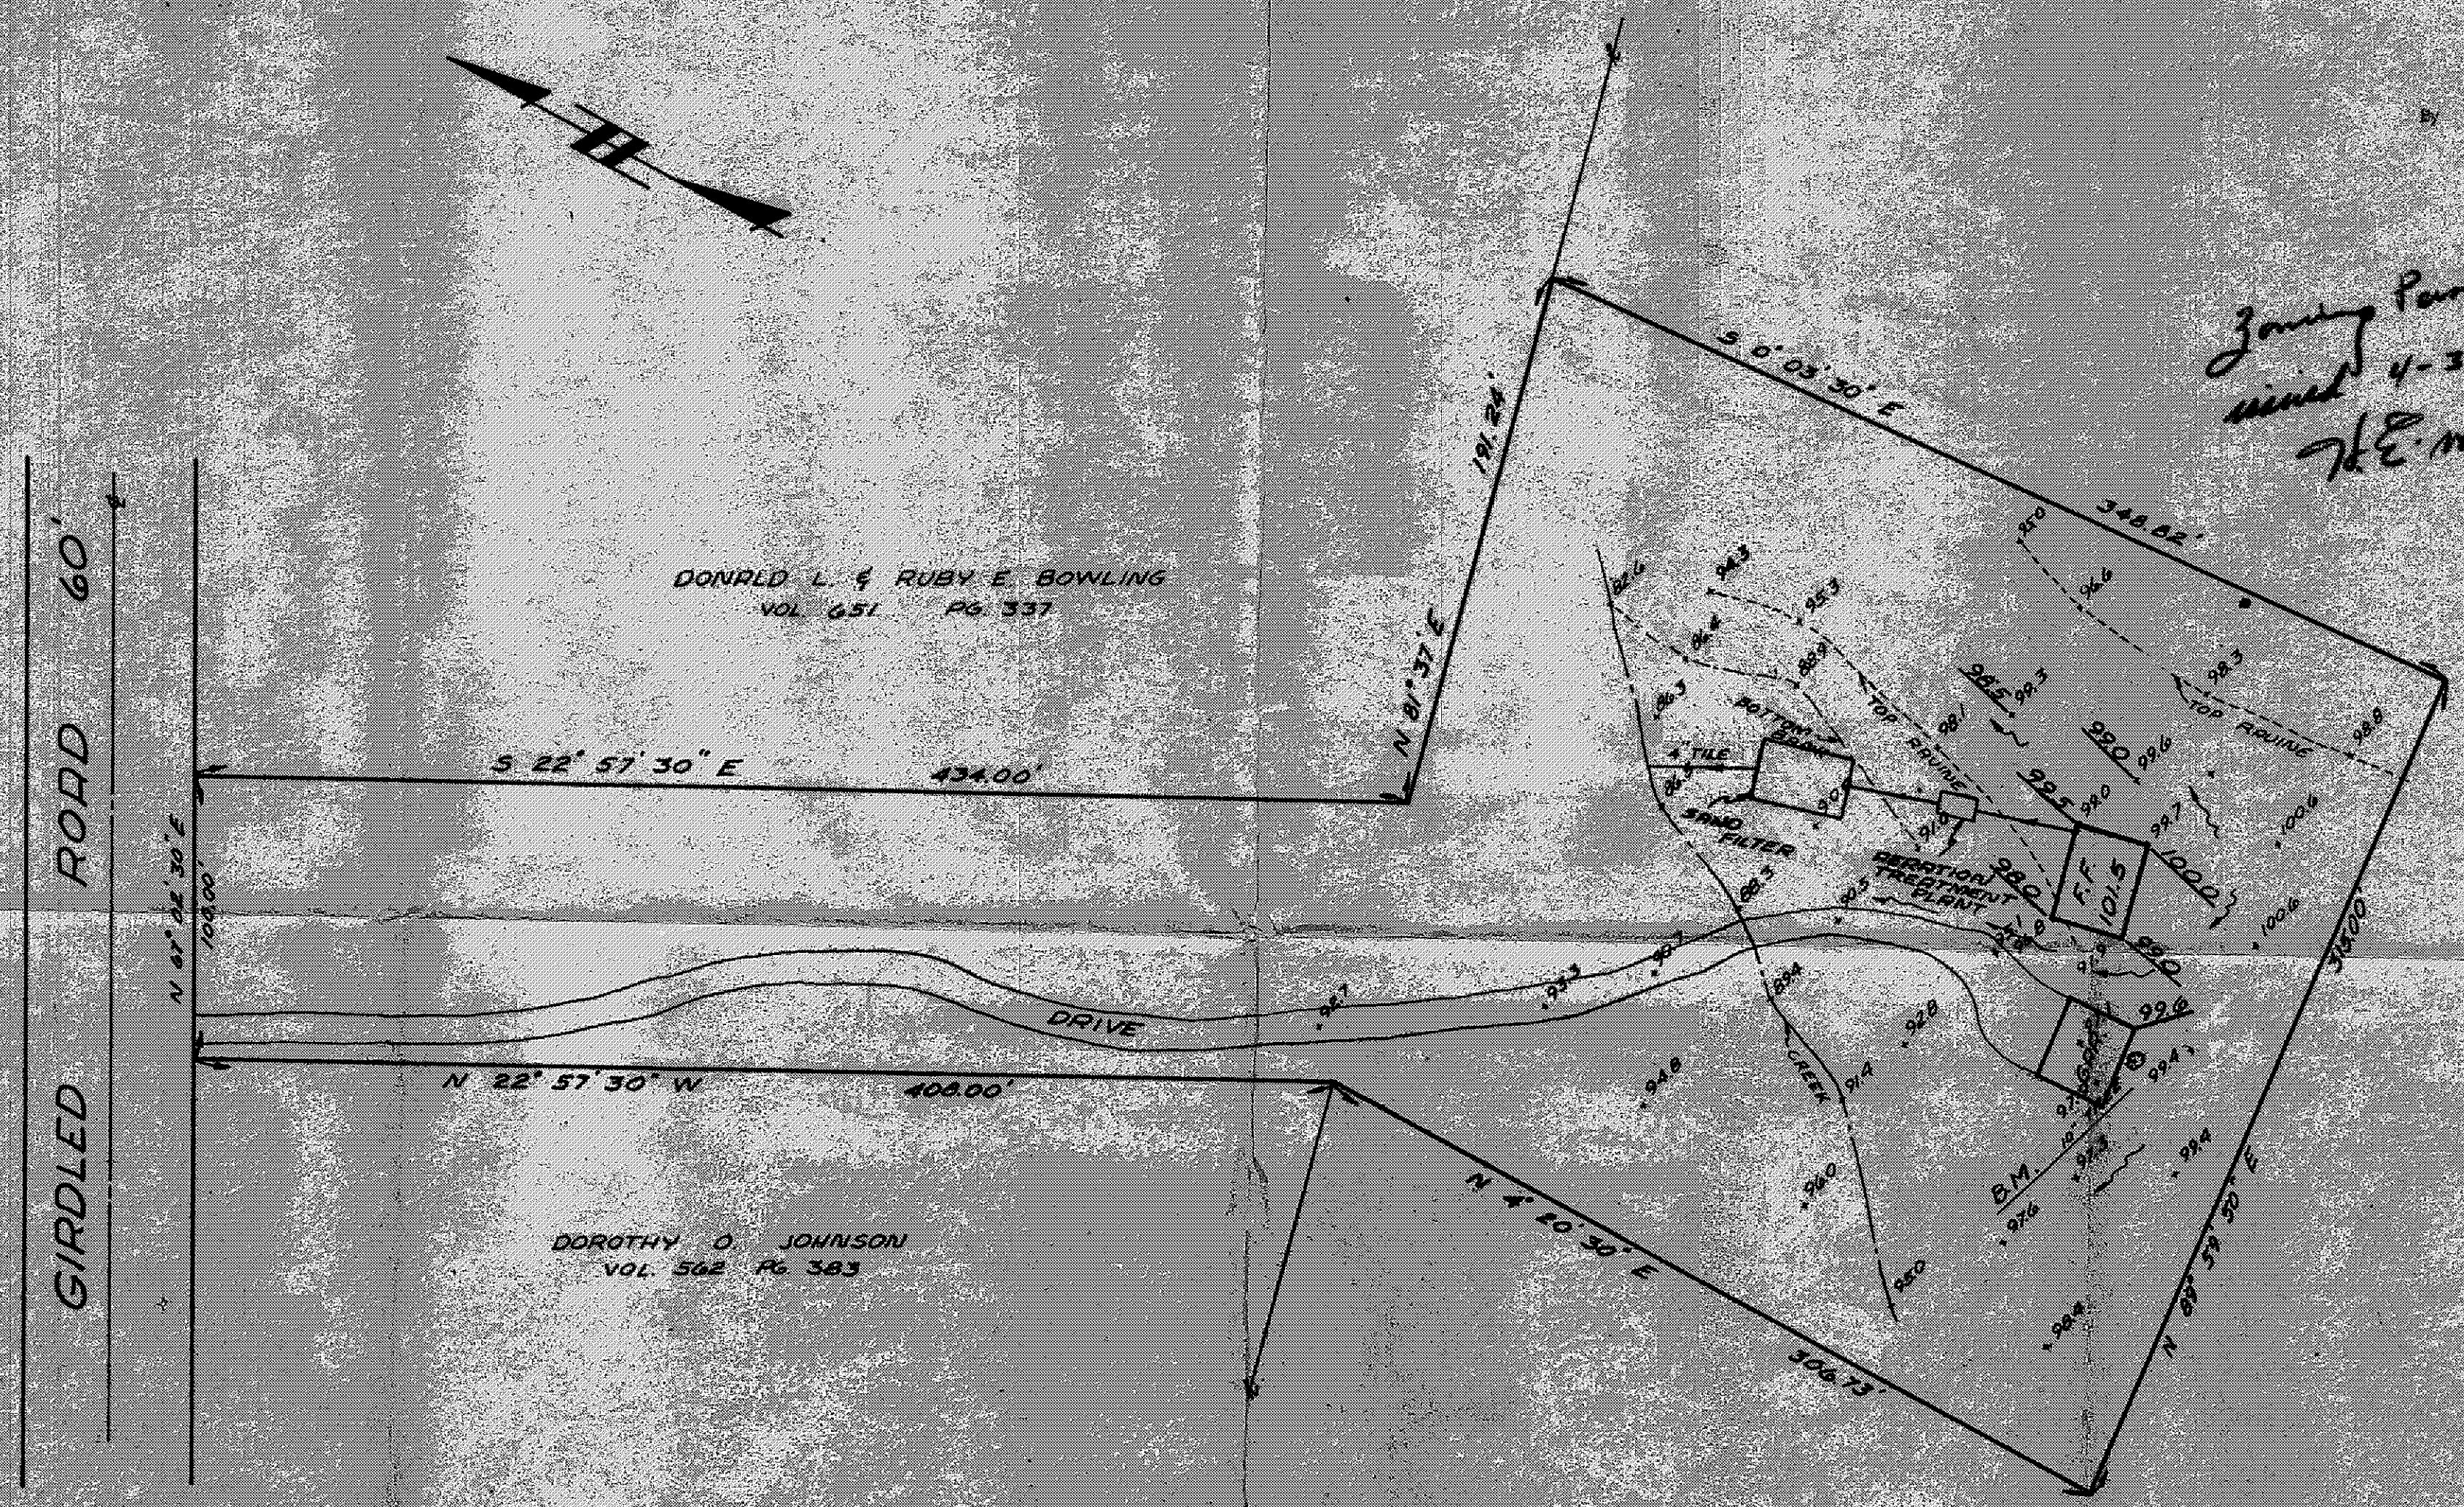

"AS BUILT" CERTIFICATION

I HEREBY CERTIFY THAT THE CIRCLED GRADES
ARE EXISTING FINISH GRADES CHECKED IN FIELD
ON 19
SURVEY IS CORRECT TO THE BEST OF MY KNOWLEDGE
AND BELIEF.

REGISTERED SURVEYOR No. 4785

DESIGN CERTIFICATION

THIS PLAN WAS PREPARED BY ME
AND IS CORRECT TO THE BEST OF MY
KNOWLEDGE AND BELIEF.

Ann D. Linn
REGISTERED SURVEYOR No. 4785

BENCH MARK - P.K. NAIL IN 10" TREE
ASSUMED ELEV. 100.00

SITE PLAN	
DONALD BOWLING	
SUBLOT 7 OF HILLCREST ACRES, TRACT 2 CONCORD TOWNSHIP, LAKE COUNTY, OHIO	
Colpetzer • Woods Consultants, Inc.	
CONSULTING ENGINEERS AND SURVEYORS PAINESVILLE, OHIO 44077	
DATE <u>APR 19</u> SCALE <u>1"</u> DRAWN BY CHECKED BY P.E. <u>253</u>	75005