

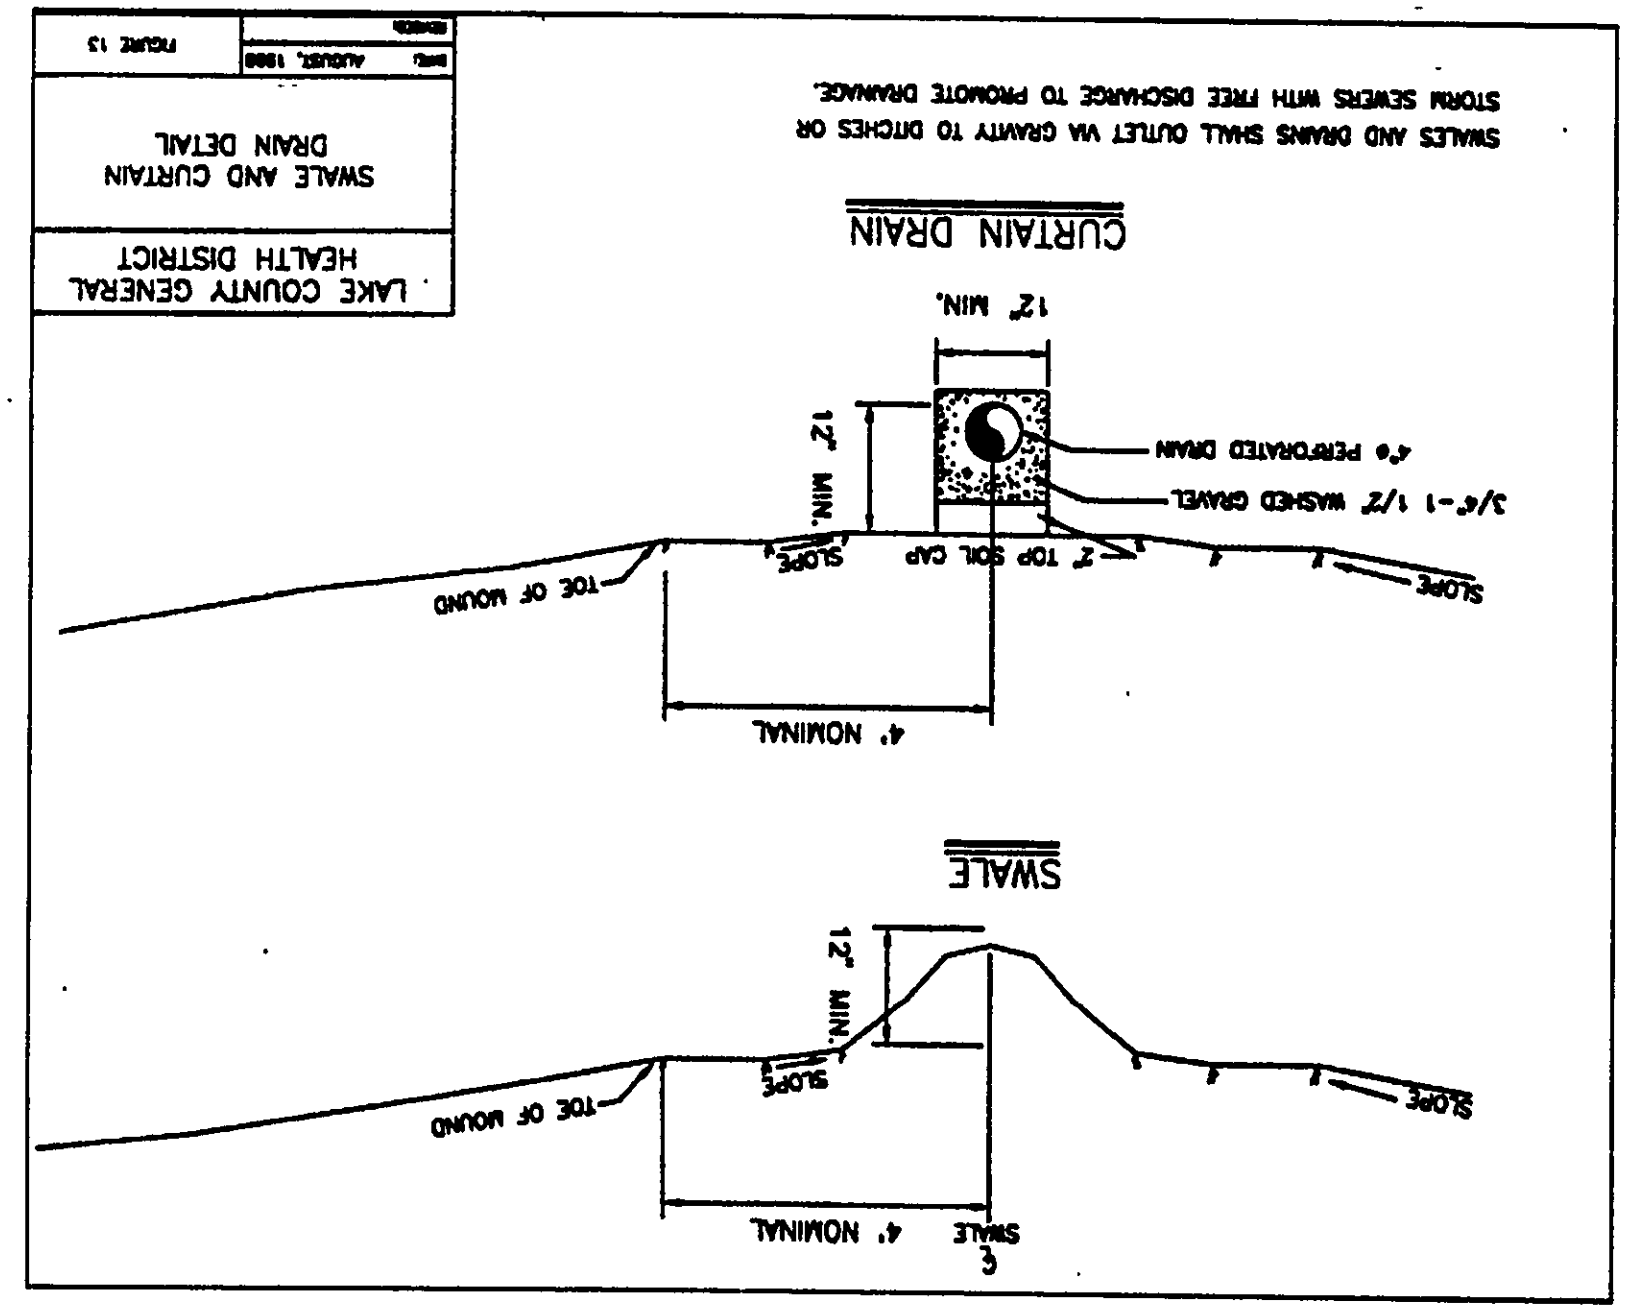
DATE	DESCRIPTION	BY	CHECKED
6-8-97	UNKNOWN RETURN TO LAKE COUNTY MINING	[Signature]	[Signature]

B BARCOCK, JONES AND ASSOCIATES, INC.
CIVIL ENGINEERS - SURVEYORS - LAND PLANNERS
PAINESVILLE OHIO 44077

DATE	1/3/99
DESIGN BY	H.J.
DRAWN BY	T.R.
APPROVED BY	H.J.

SITE PLAN
 FOR
 JOE MADACHY
 12231 Girardeau Rd
 CONCORD TOWNSHIP
 LAKE COUNTY

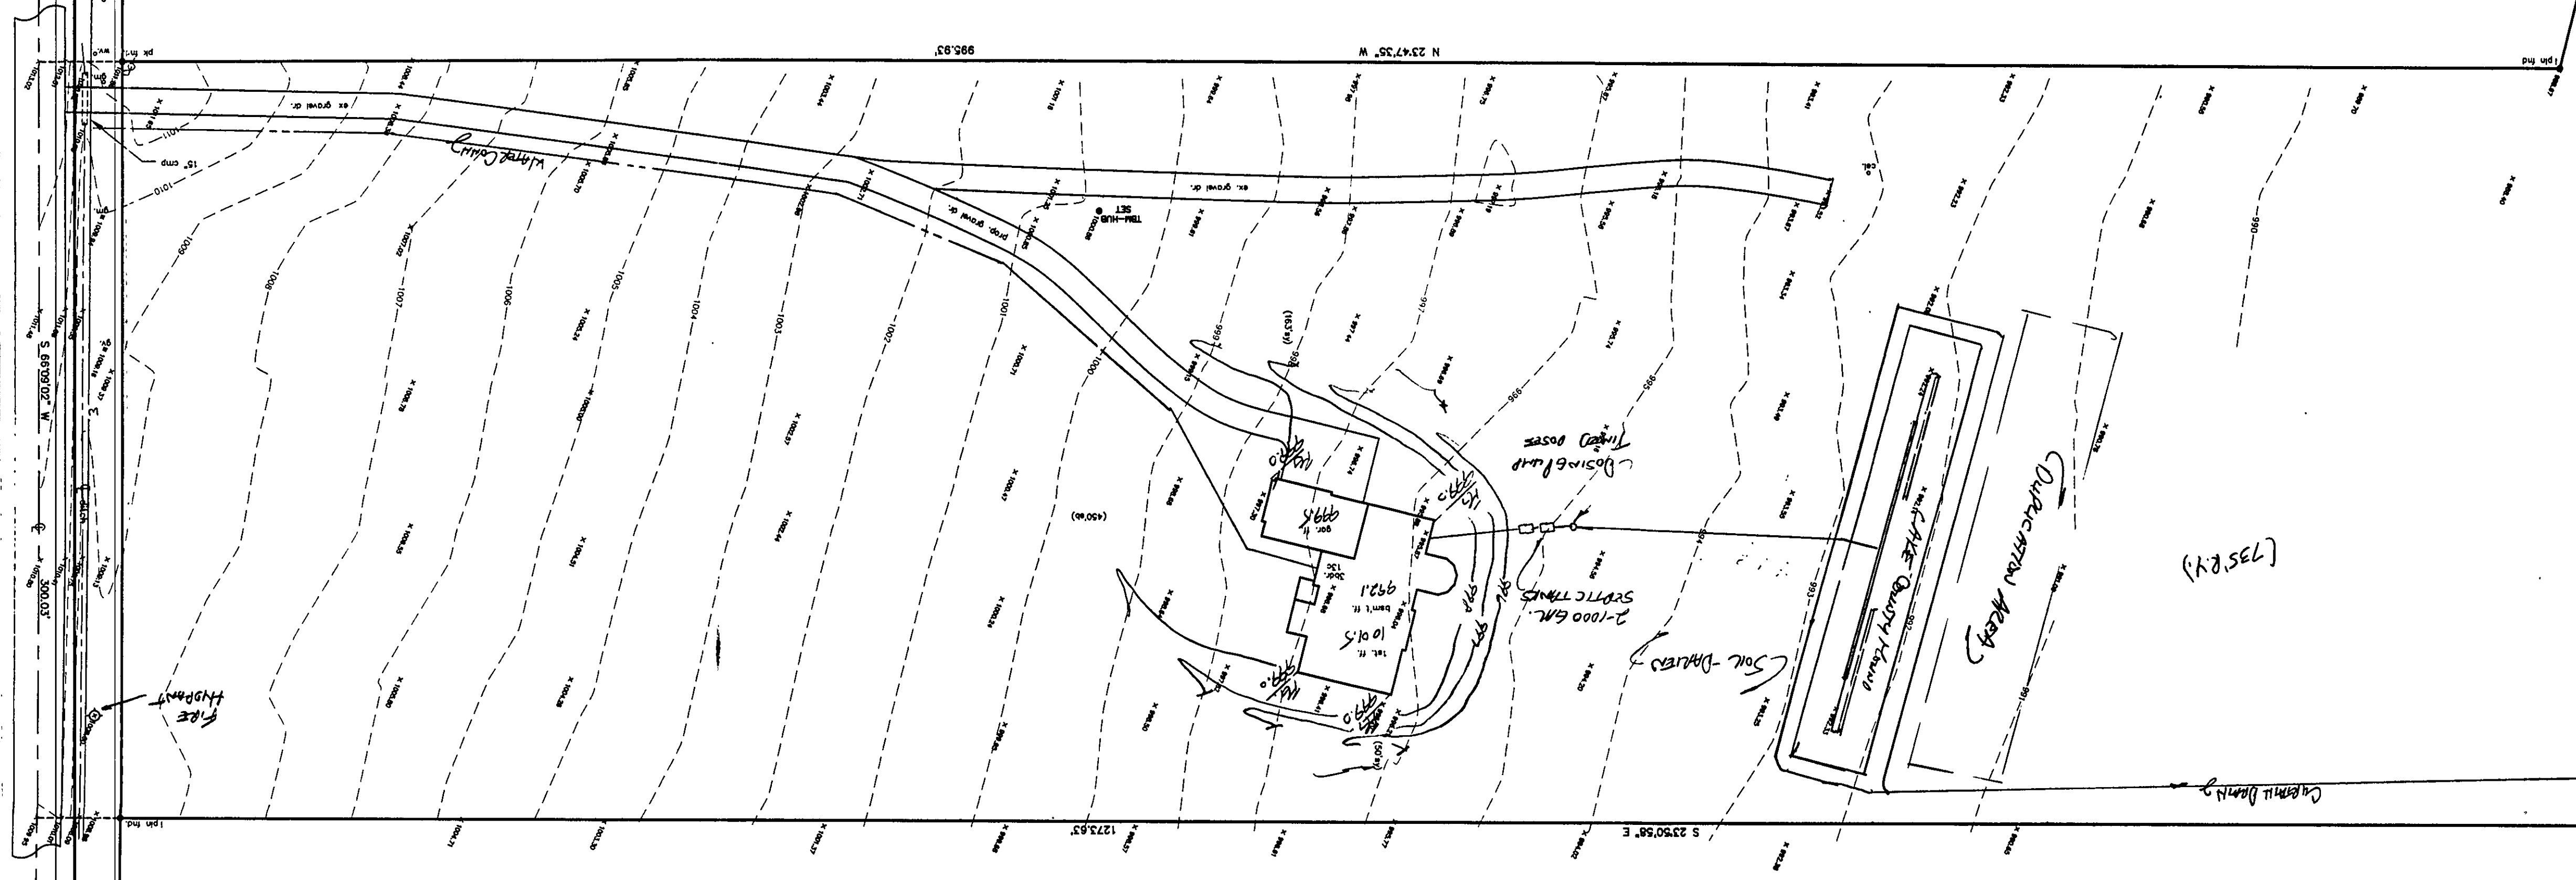
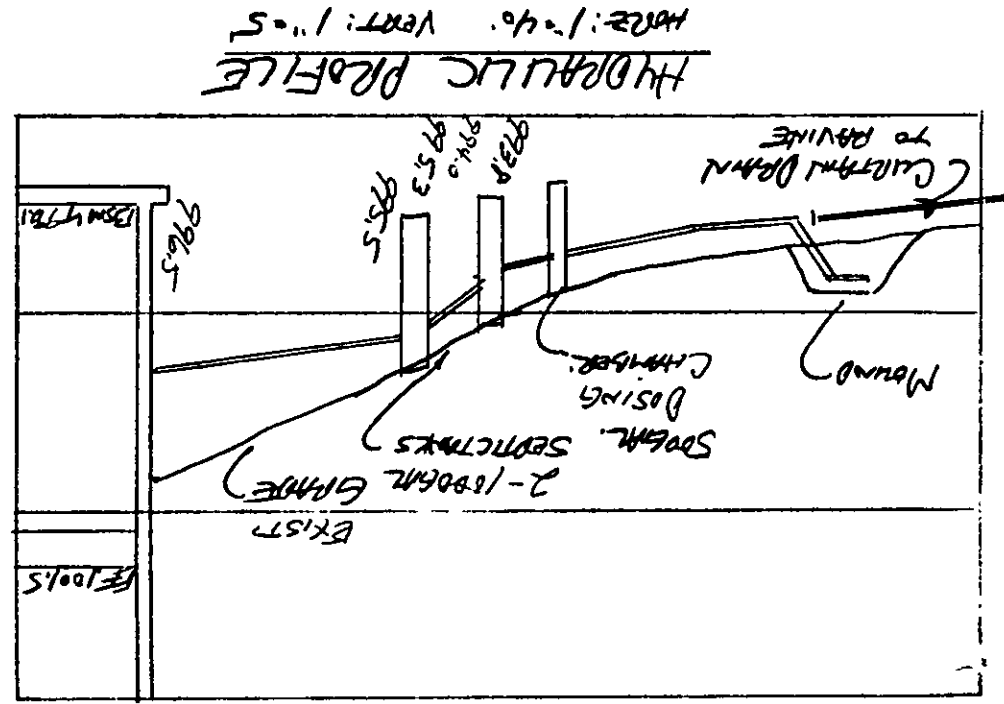
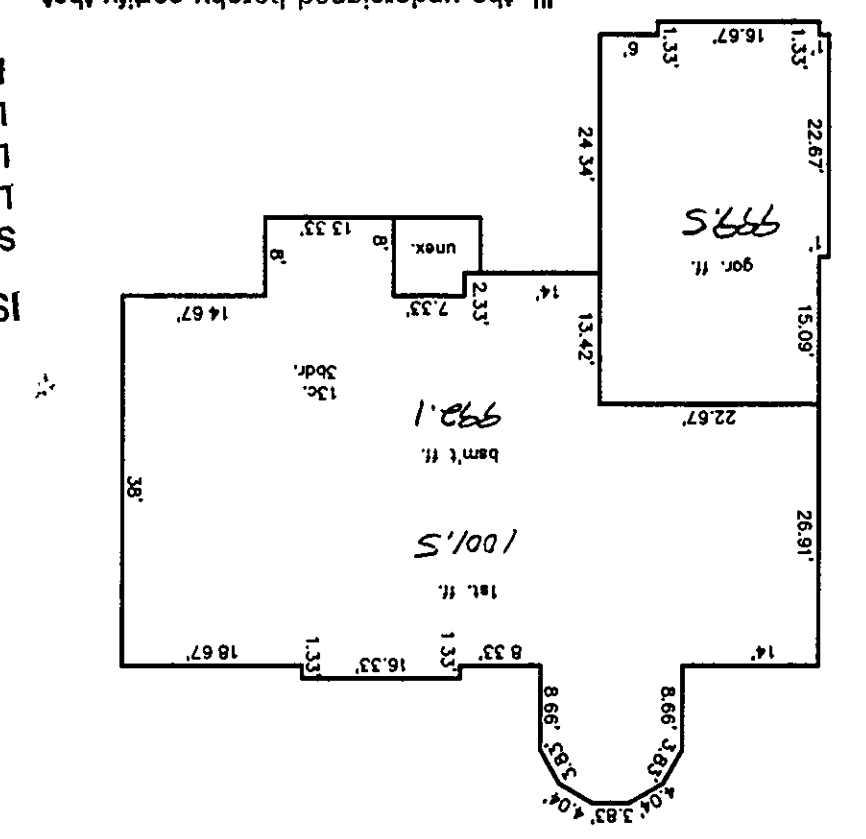
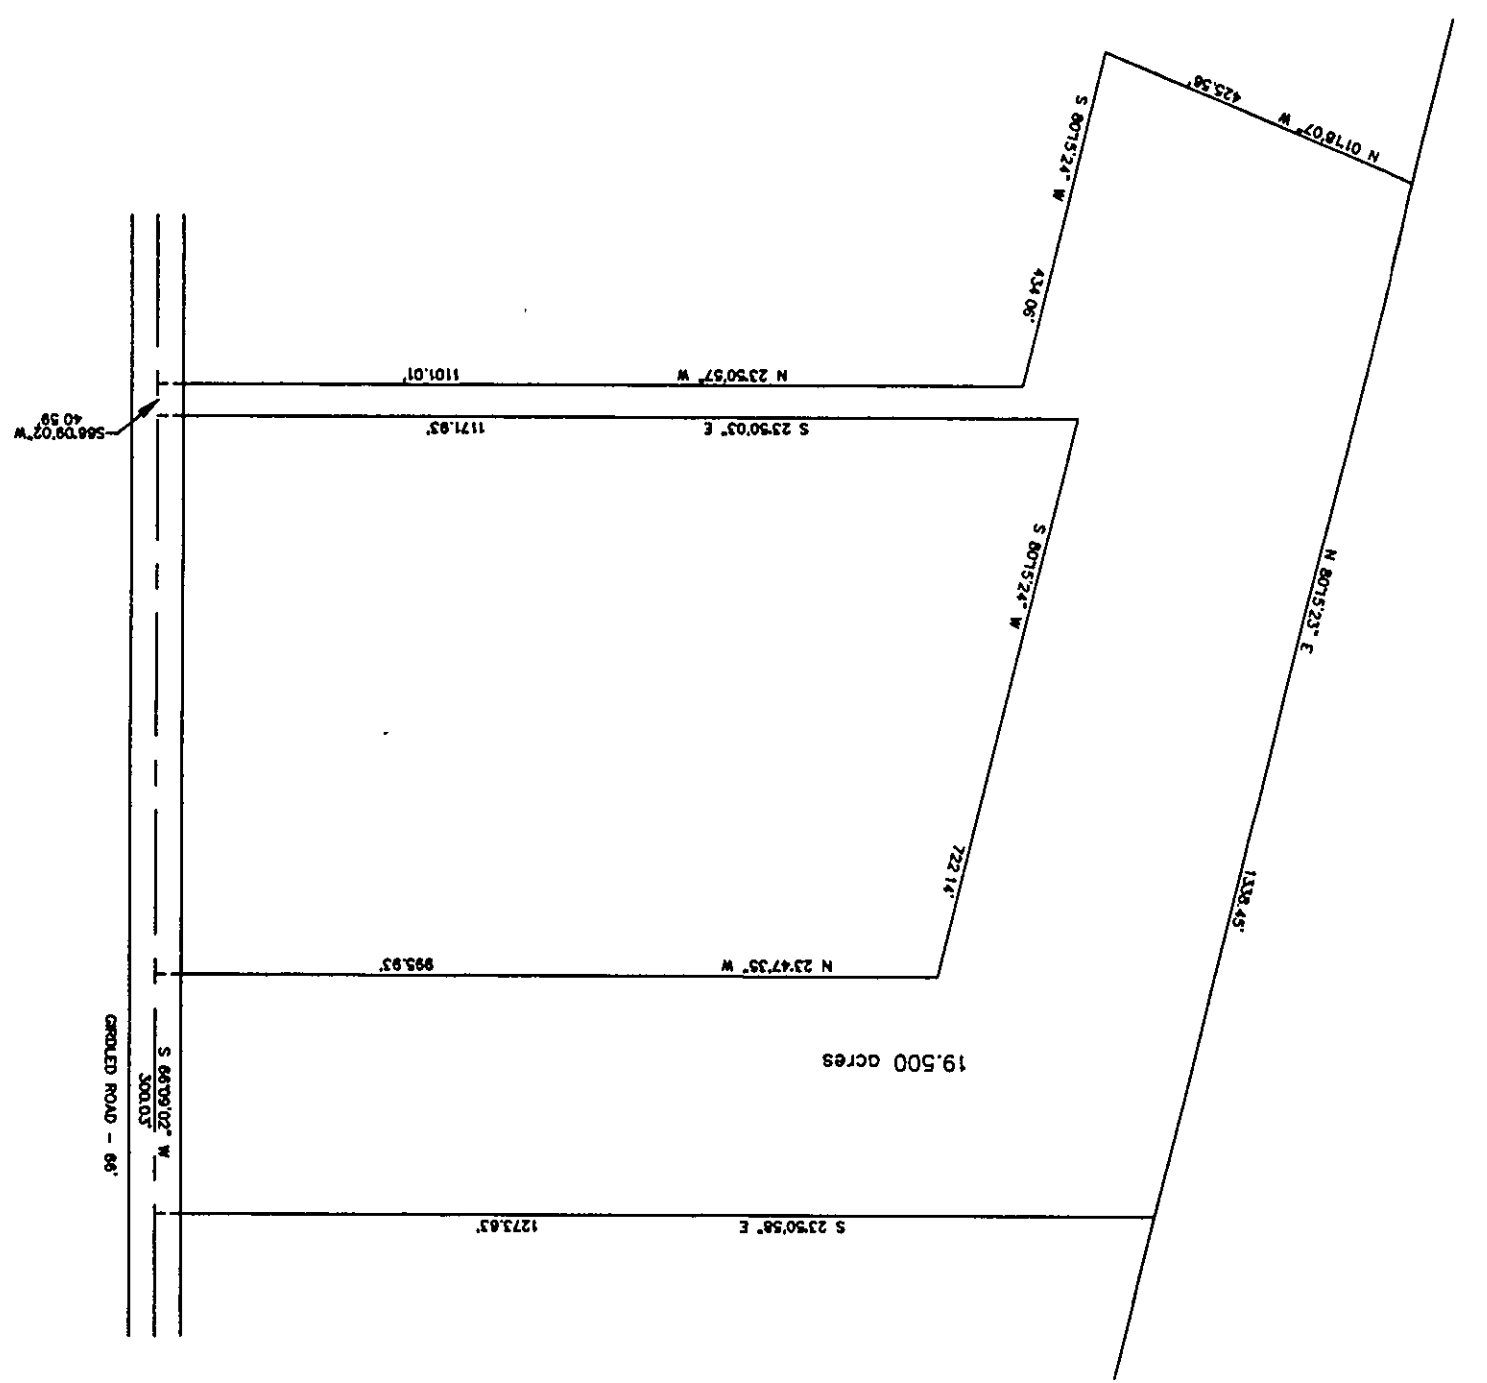
SCALE: 1"=40'	JOB NO. 99-017	SHEET 2 OF 2
---------------	----------------	--------------



I, the undersigned hereby certify that
this topographic indicated by 6 " 1, or 2
represent an actual field survey made by
me on the _____ day of _____, 19____
and that the elevations were taken at
appropriate intervals and that as of that
date they existed as indicated hereon.

Name _____

Reg. No. _____

[illegible]

GIRDLED ROAD - 66'