


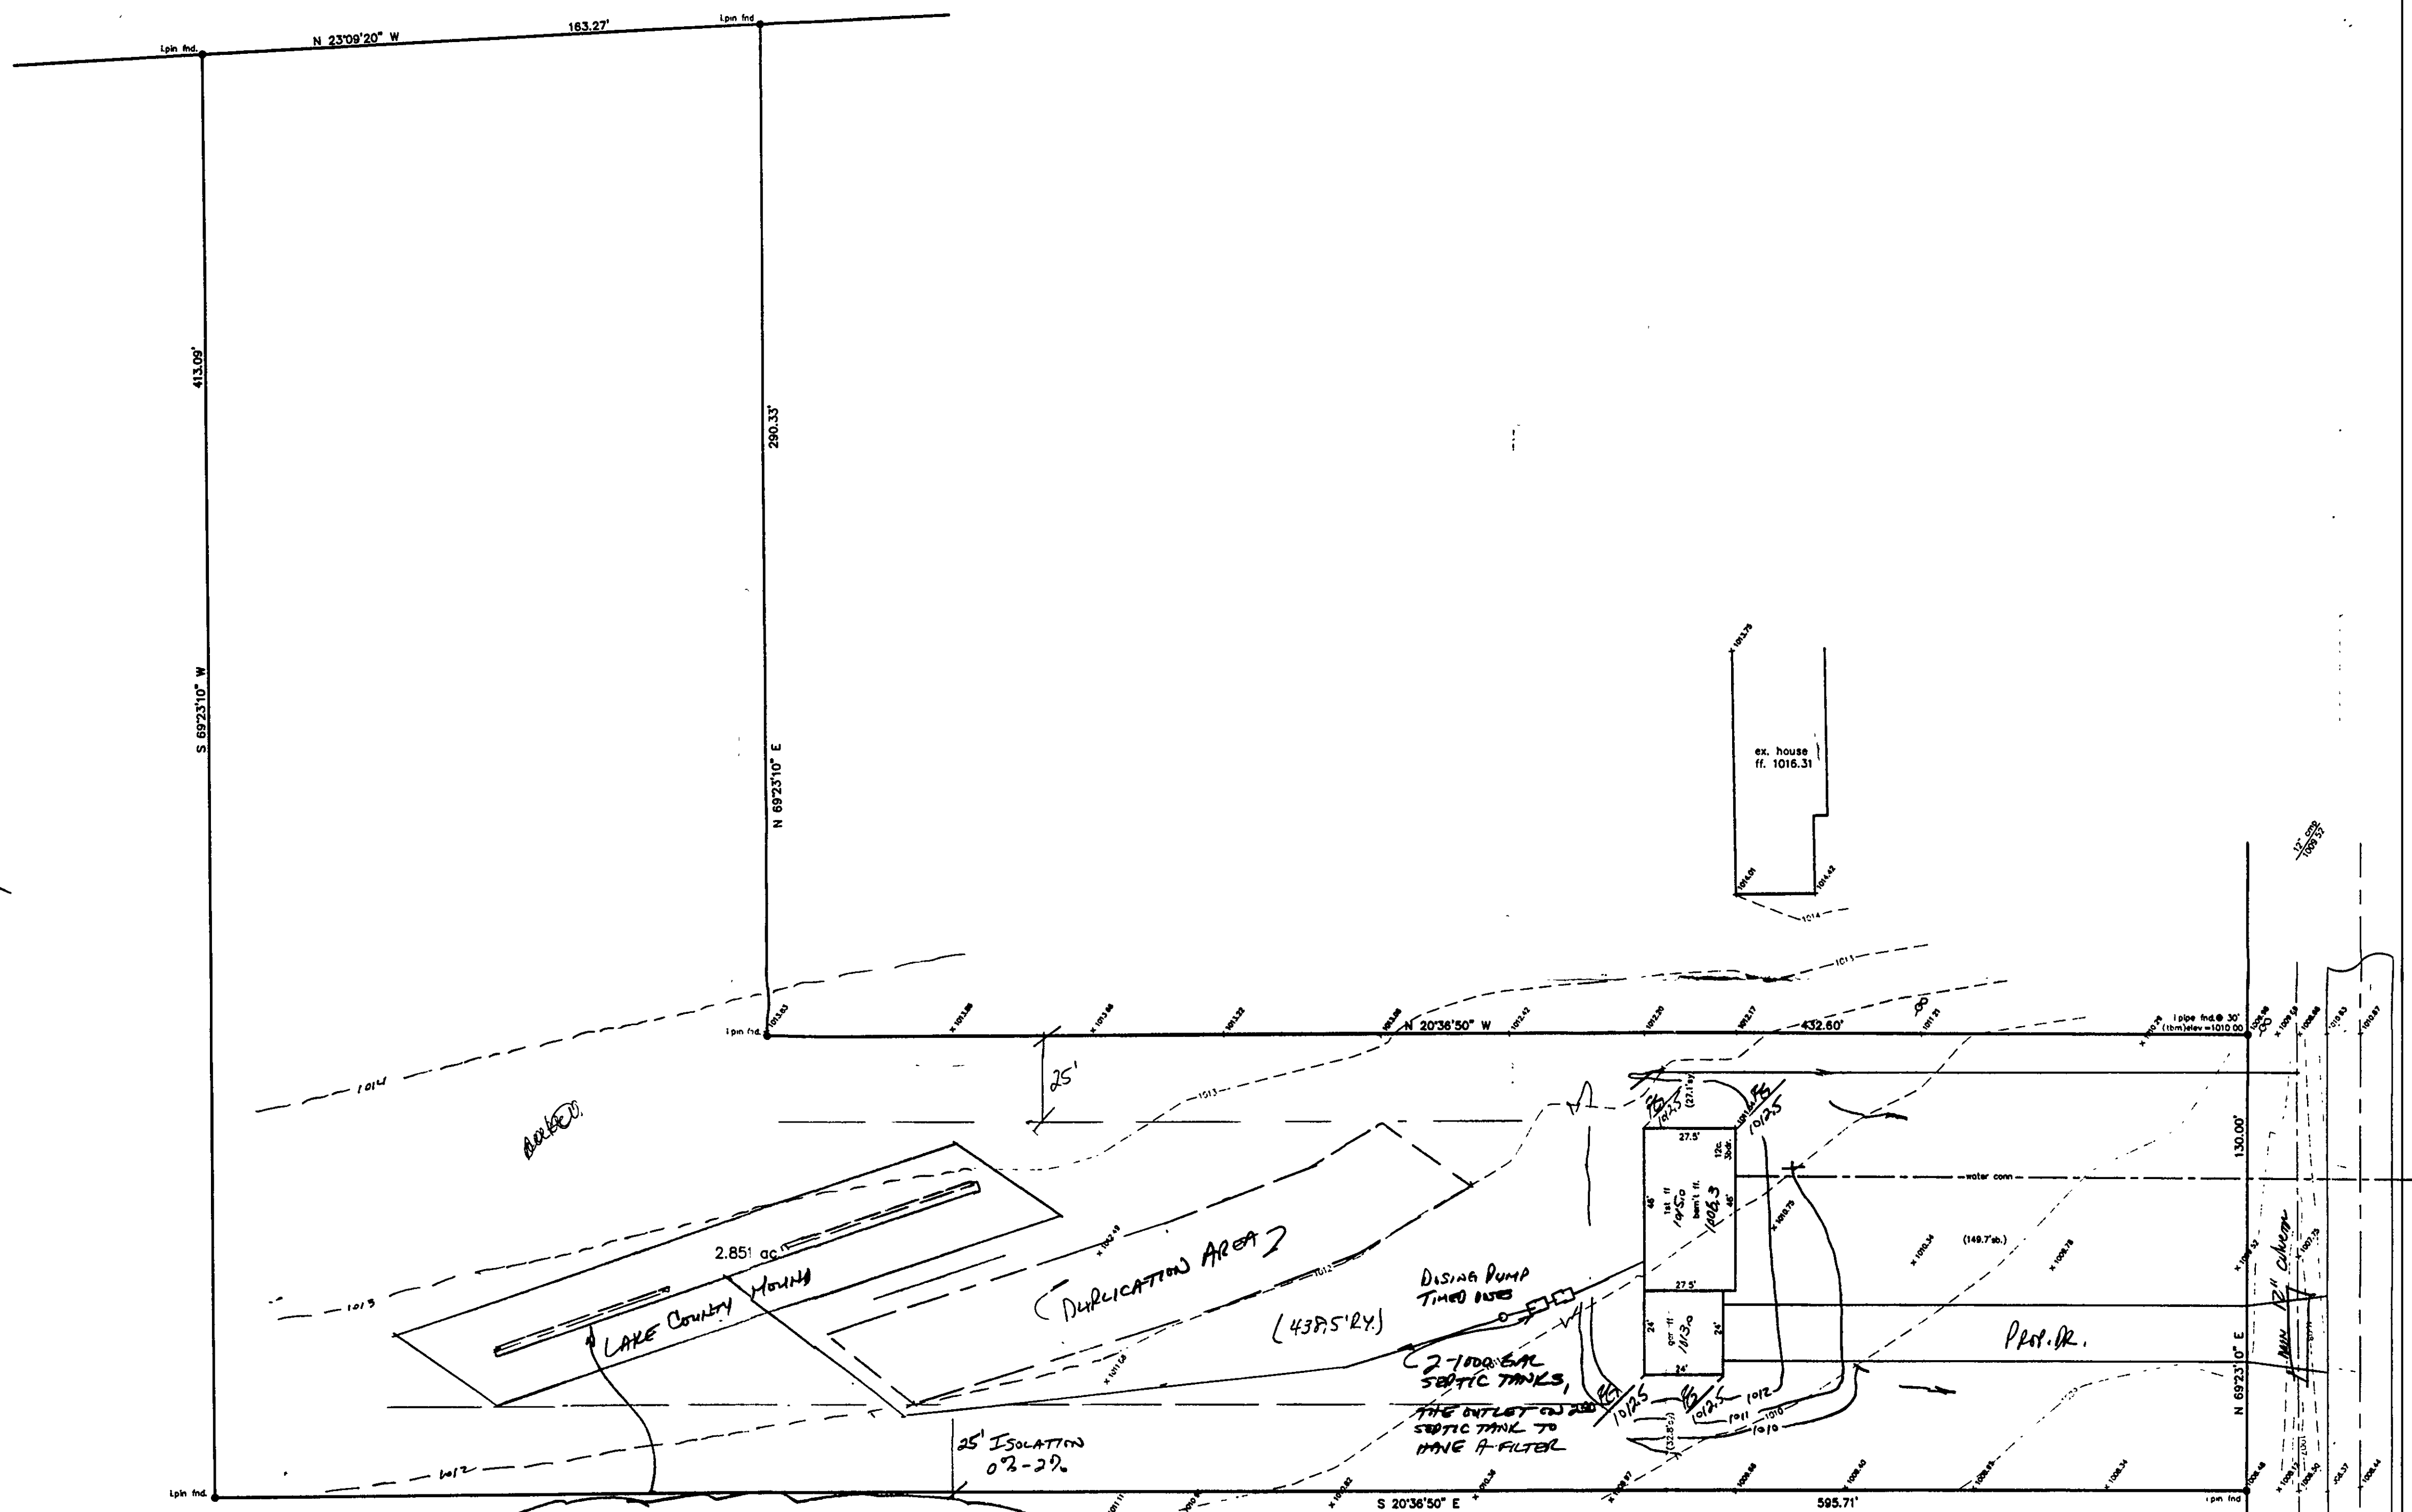

REVIEWED AND ACCEPTED
LAKE COUNTY GENERAL
HEALTH DISTRICT
Date 4-12-99 By *Donella*
SEWAGE DISPOSAL PERMIT MUST BE
OBTAINED BY A LAKE COUNTY LICENSED
INSTALLER BEFORE INSTALLATION IS
STARTED.

NOTE: MANHOLE TO BE 2' DIAMETER
(2) - 75' LONG WITH 1/4\"/>

"I, the undersigned hereby certify that
this topography indicated by 6\", 1\", or 2\"
contours, and elevations shown hereon
represent an actual field survey made by
me on the 19th day of March, 1999
and that the elevations were taken at
appropriate intervals and that as of that
date they existed as indicated hereon."

Harry Jones #16343
Name Reg. No.


Grading Plan Approved
as shown and/or noted by
THOMAS P. GILLES, P.E.
Lake County Engineer

By *Tom Jones* Date 4/14/99
Drive chert Regd

ZONING PERMIT #0394-5309
ISSUED 3/11/99

SUBJECT TO APPROVAL BY:
Lake County Sanitary Eng. ☐
Lake County Eng. Dept. ☒
Lake County Planning Comm. ☐
Lake County Bldg. Dept. ☒

TBM-TOP OF IRON PIPE
ELEV.=1010.00

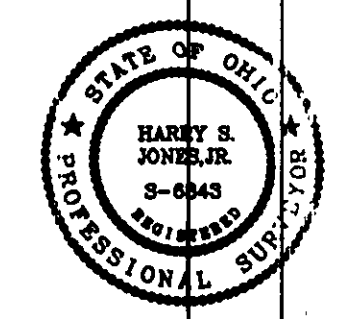

REV. NO.	DESCRIPTION	DATE	BY	CHK'D
1	REVISED MANHOLE	3-31-99	HJ	HJ
2	REVISED MANHOLE	4-12-99	HJ	HJ

bj BABCOCK, JONES AND ASSOCIATES, INC
CIVIL ENGINEERS - SURVEYORS - LAND PLANNERS
PAINESVILLE OHIO 44077

DATE 3/9/99
DESIGN BY H.J.
DRAWN BY T.R.
APPROVED BY H.J.

SITE PLAN
FOR
HOLLY ZORICH
12248 Girdled
CONCORD TOWNSHIP LAKE COUNTY

SCALE: 1"=30'
JOB NO. 98-052
SHEET 1 OF 2