


RESIDENCE FOR
PATRICIA LINES
GIRDLED ROAD
TOWNSHIP OF CONCORD
COUNTY OF LAKE
STATE OF OHIO

Reviewed and Accepted
LAKE COUNTY GENERAL HEALTH DISTRICT
Date: 6-10-93
JOEL LUCKA, R.S., M.P.H.
Health Commissioner
By: David B. Morris

- A. To be brought to finished grade
1. Septic tank, including covers
2. Splitter box, cover
3. Distribution box, cover
B. No footing drains or connections
to be distributed into septic tanks
C. All water, waste to be discharged into
septic tanks

SEWAGE DISPOSAL TREATMENT MUST BE
OBTAINED BY A LAKE COUNTY LICENSED
ENGINEER BEFORE INSTALLATION IS
INITIATED.

LOW YIELD WATER
EXPOSURES REQUIRED
ON ALL
Summer head
Tide

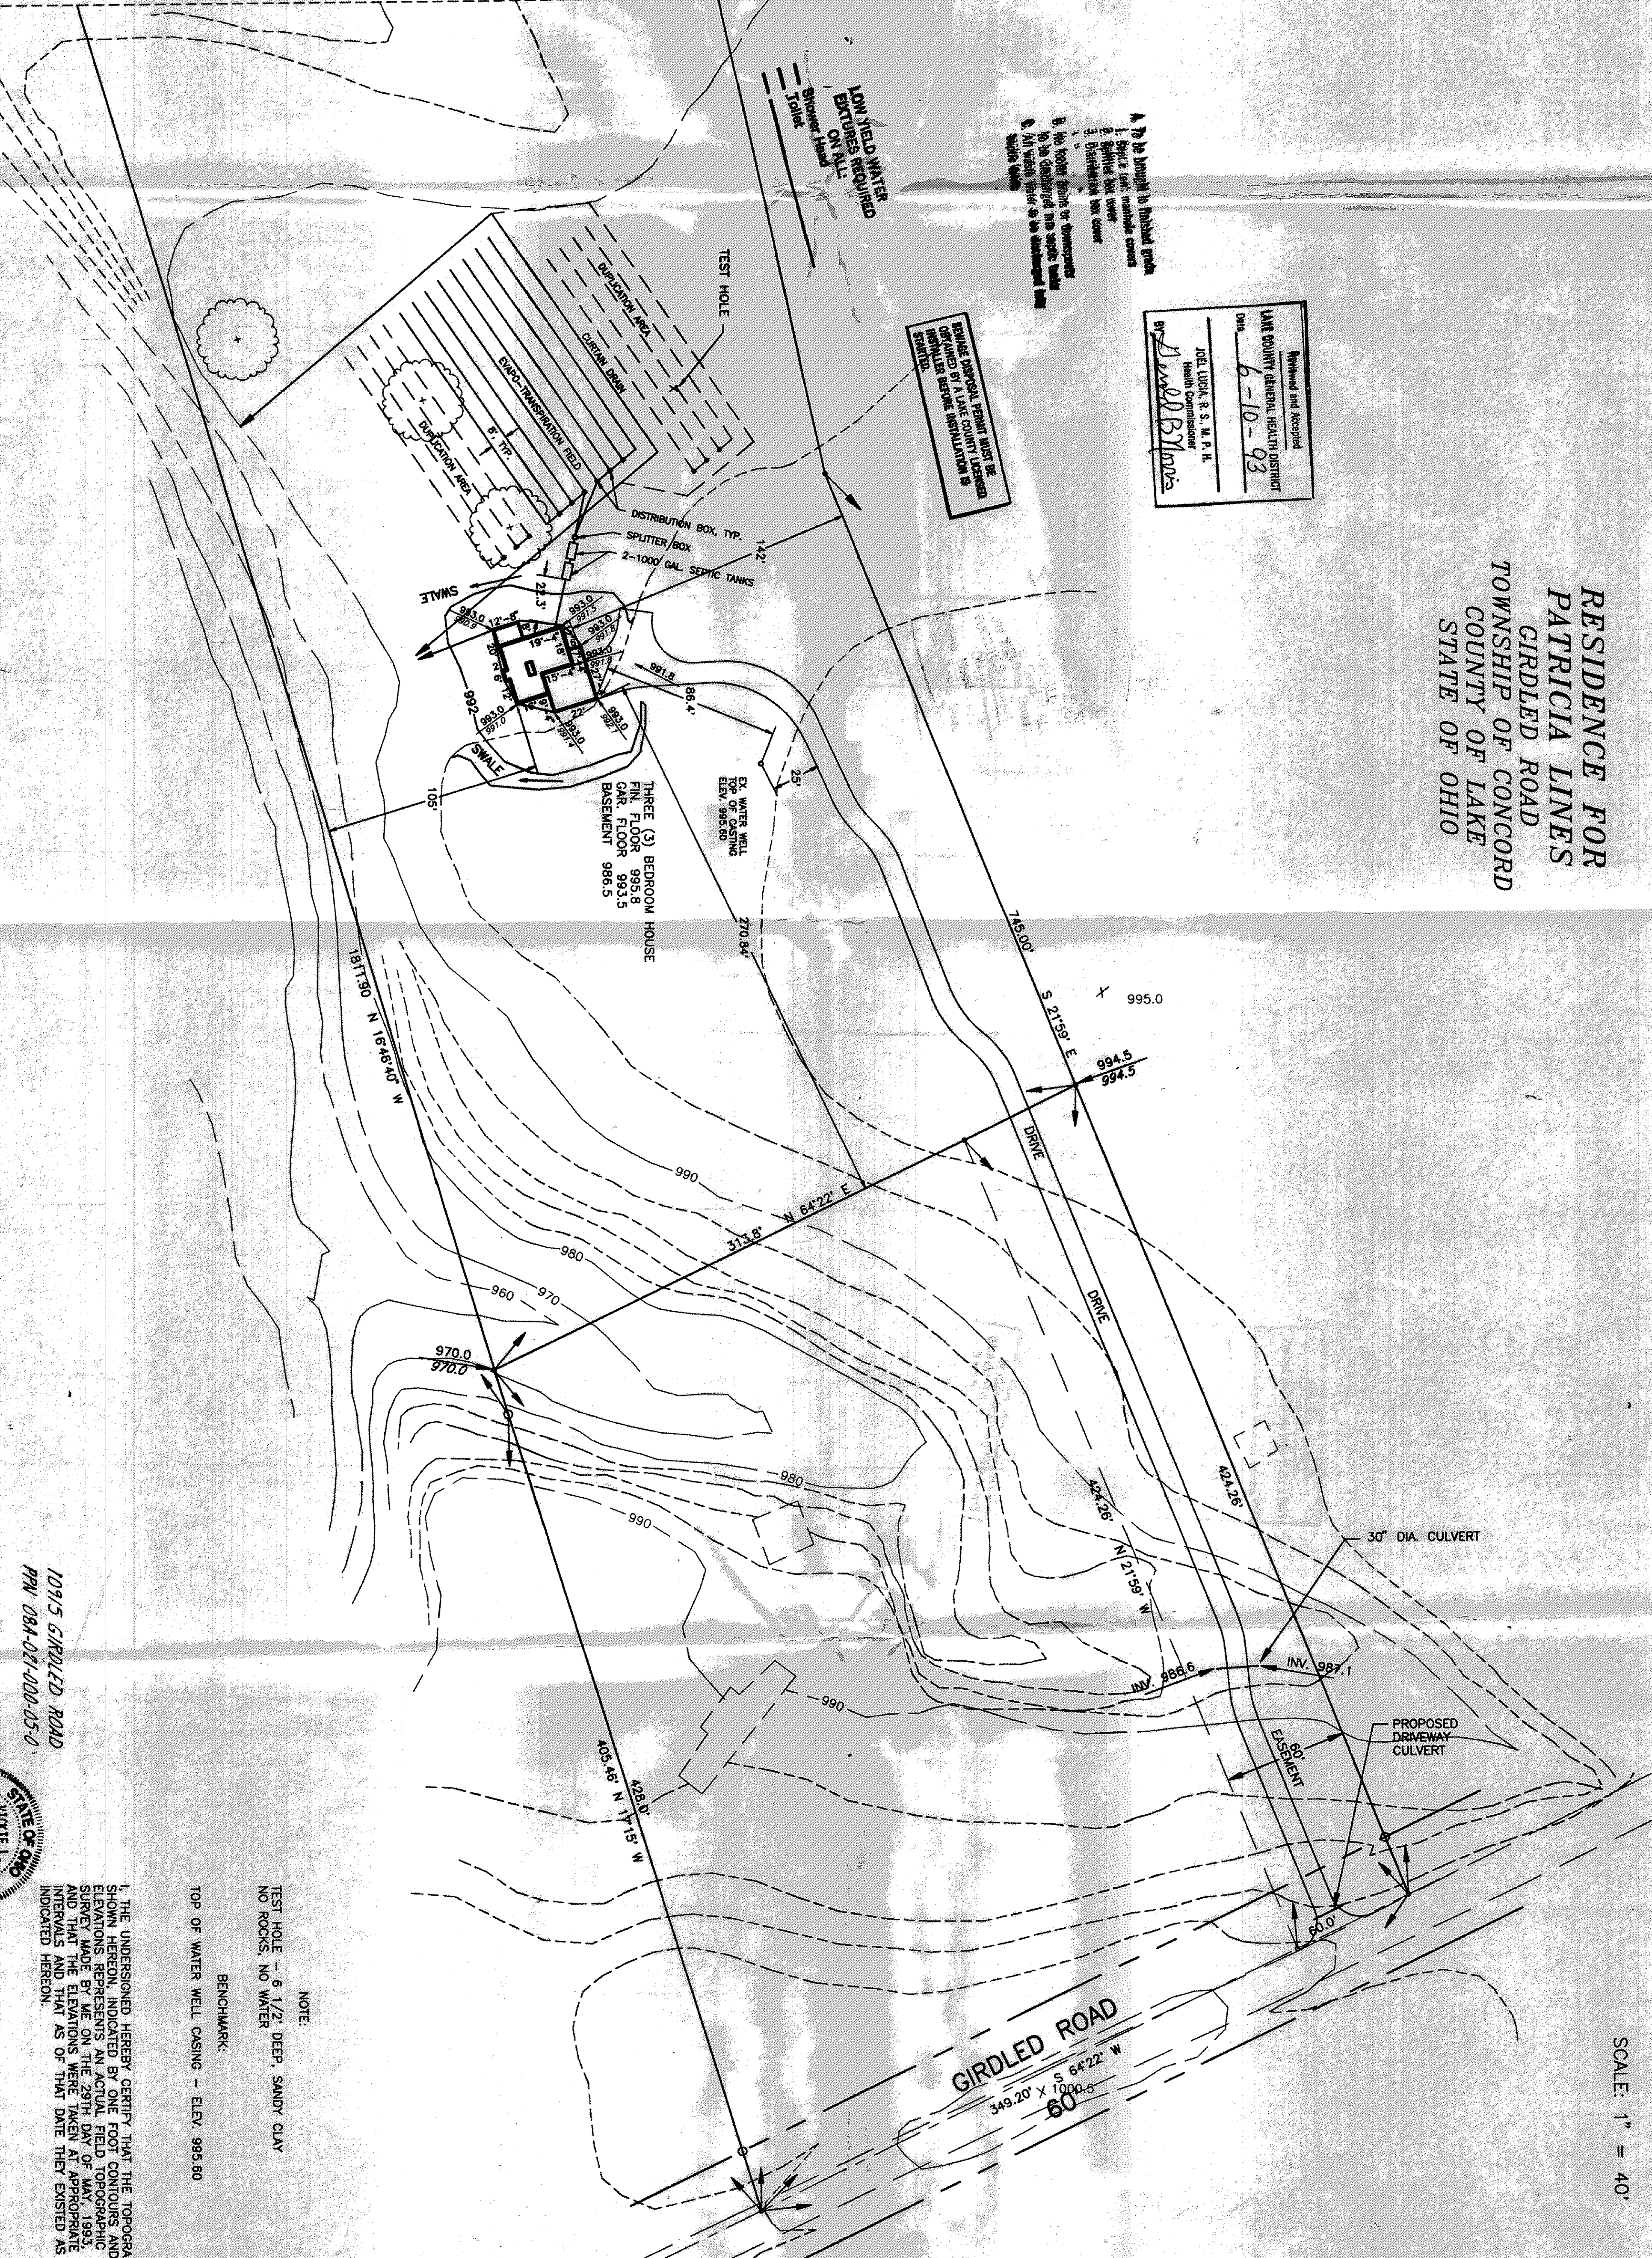

NOTE:
TEST HOLE - 6 1/2" DEEP, SANDY CLAY
NO ROCKS, NO WATER
BENCHMARK:
TOP OF WATER WELL CASING - ELEV. 995.60

I, THE UNDERSIGNED HEREBY CERTIFY THAT THE TOPOGRAPHY
SHOWN HEREON, INDICATED BY ONE FOOT CONTOURS AND
ELEVATIONS REPRESENTS AN ACTUAL FIELD SURVEY OF
THE PROPERTY AND THAT THE ELEVATIONS WERE TAKEN AT APPROPRIATE
INTERVALS AND THAT AS OF THAT DATE THEY EXISTED AS
INDICATED HEREON.

STATE OF OHIO
VICKIE L. WILSON
E-55556
REGISTERED PROFESSIONAL ENGINEER

10715 GIRDLED ROAD
PPW 084-01-000-05-0
Vickie L. Wilson - 55556 6/1/93