

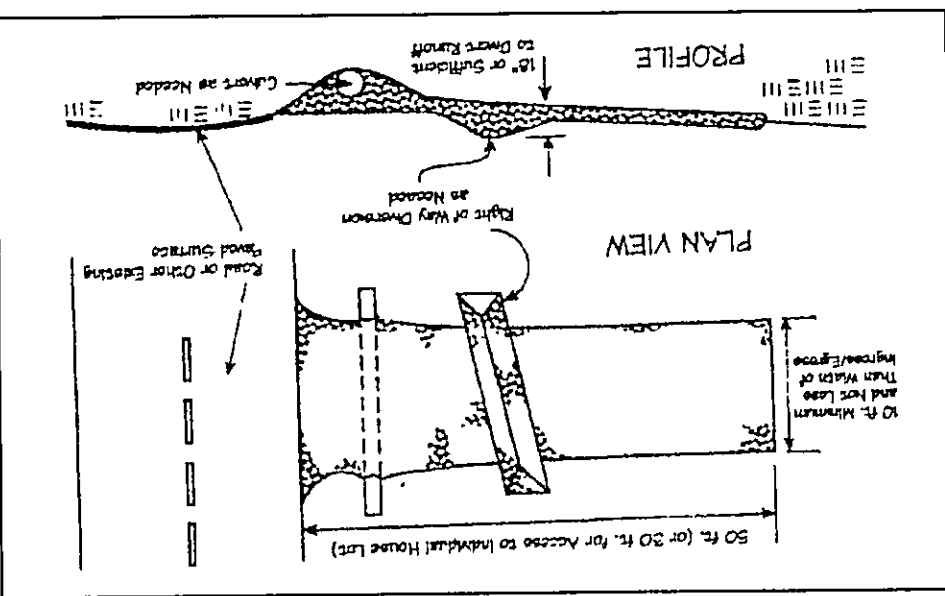


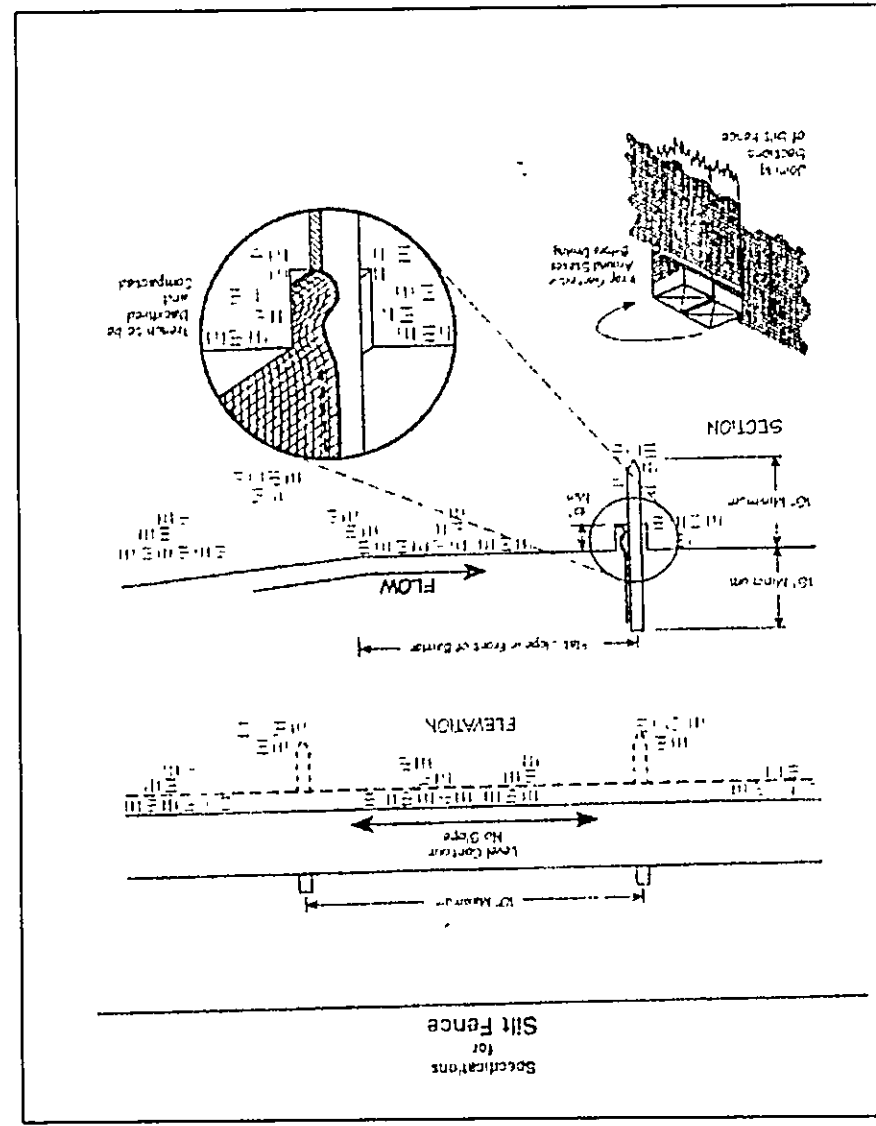

EXISTING UTILITIES NOTE:
THE SIZE AND LOCATION, BOTH HORIZONTAL AND VERTICAL
OF THE UNDERGROUND UTILITIES SHOWN HEREON, HAVE BEEN
OBTAINED BY A SEARCH OF AVAILABLE RECORDS.
VERIFICATION BY FIELD OBSERVATION HAS BEEN CONDUCTED
WHERE PRACTICAL. HOWEVER, BABCOCK, JONES AND ASSOCIATES
INC. DOES NOT GUARANTEE THE COMPLETENESS NOR ACCURACY
THEREOF.

Name Harry S. Jones, Jr. Reg. No. 8-0343

"I, the undersigned hereby certify that this topography indicated by 6", 1", or 2" contours, and elevations shown hereon represent an actual field survey made by me on the 23 day of Aug., 2005 and that the elevations were taken at appropriate intervals and that as of that date they existed as indicated hereon."

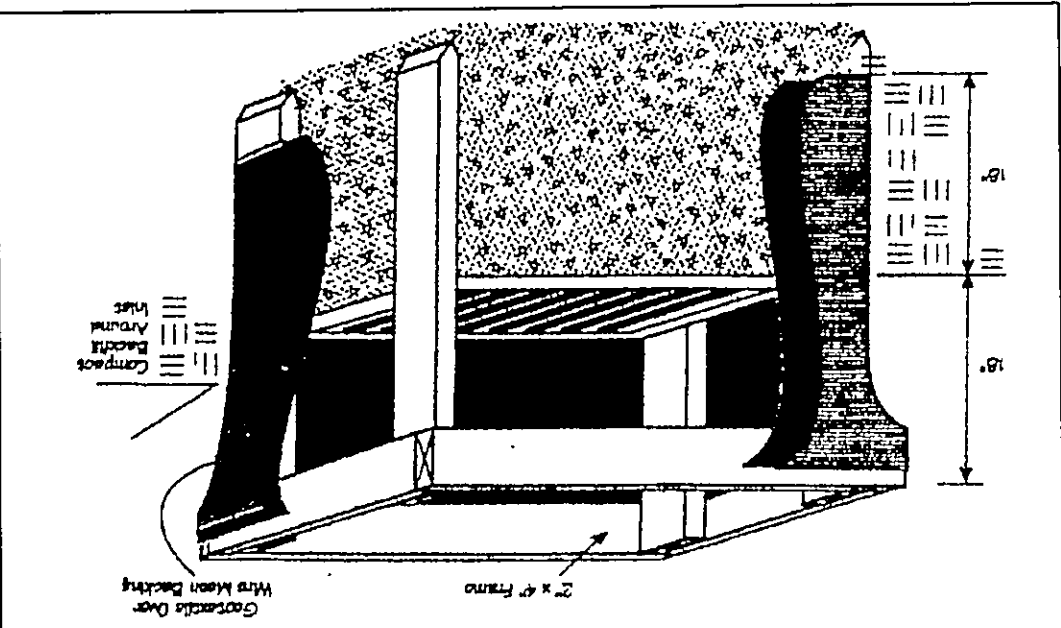

Maintenance
Erosion and sediment controls shall be inspected every seven(7) days or within 24 hours of a 0.5" or greater rainfall event.
Necessary repairs shall be made at this time.

Mulching
Straw-mulch shall be applied at a rate of 1 bale per every ten (10) feet of curb, at a width of thirty(30) feet to the entire length of the lot. Wood chips may also be used but must be spread at a minimum depth of four inches over the thirty-foot width and must be accompanied by a properly installed silt fence.

Stabilization of critical areas within fifty(50) feet of any stream or wetland shall be complete within two(2) days of the disturbance. If the site is to remain inactive for longer than fourteen(14) days.

Temporary Seeding
Disturbed areas of the site that are to remain idle for more than thirty(30) days shall be properly seeded and straw mulched within seven(7) days of completion of initial grading. Temporary seeding and mulching as a thirty(30) foot strip of the entire front of the lot shall be maintained on the site once initial grading is complete.

Silt Fence
A silt fence shall be installed prior to any earthwork activities at the site in the locations shown on the site plan as well as along the front of any lot that slopes towards the street.

Ingress-Egress
A stone access drive complete with underlying geo-textile fabric (20 feet wide and 50 feet long) for ingress and egress at the site shall be installed. This drive shall be the only entrance and exit to the site.

Erosion and Sediment Control Schedule

Temporary Seeding Species Selection				
Seeding Dates	Species	Lb./1,000 ft. ²	Per Ac.	
March 1 to August 15	Oats	4 bushel	40 lb.	
	Tall Fescue	1	40 lb.	
	Perennial Ryegrass	1	40 lb.	
	Annual Ryegrass	1	40 lb.	
August 16 to November 1	Rye	2 bushel	40 lb.	
	Tall Fescue	1	40 lb.	
	Perennial Ryegrass	1	40 lb.	
	Annual Ryegrass	1	40 lb.	
November 1 to Spring Seeding	Wheat	3	40 lb.	
	Tall Fescue	1	40 lb.	
	Perennial Ryegrass	1	40 lb.	
	Annual Ryegrass	1	40 lb.	

REGISTERED SURVEYOR

"AS BUILT" CERTIFICATION
I, HEREBY CERTIFY THAT THE CIRCLED GRADES ARE EXISTING
FINISH GRADES CHECKED IN THE FIELD ON 20,
AND ARE CORRECT TO THE BEST OF MY KNOWLEDGE AND BELIEF.

5	CHIEF	APD	57-129-57
4	CHK'D.	DATE	8/25/05
3	DRAWN BY	SCALE	1"=40'
2	PHONE NO.		440-357-1811
1	DATE	BY	

PLAN PREPARED BY: **BABCOCK, JONES & ASSOCIATES, INC.**
PAINESVILLE, OHIO

NO. OF BEDROOMS	BEARINGS	TIE TO NEAREST STREET
SAN. SEWER SIZE, LOCATION	SAN. MH. CAST, ELEV. INV. ELEV.	SAN. CONN. SIZE, LOC. DEPTH
STORM SEWER SIZE, LOC.	STORM MH. CAST ELEV. INV. ELEV.	BLDG. DIMENSIONS FIN GR.
BLDG. DIMENSIONS FIN GR.	BLDG. TIES F.T.R. GRADES	APRON TYPE WIDTH THICKNESS
SIDEWALK TYPE DIA. LENGTH	CULVERT TYPE DIA. LENGTH	ISOLATION RADIUS FROM WELL
WELL LOCATION	SEPTIC TANK LOCATION & DUPLICATION AREA	GAS LINE LOC. SIZE PRESSURE
PAVT TYPE GRADE CURBS	STORM MH. CAST ELEV. INV. ELEV.	SURROUNDING OWNERS
WATER MAIN SIZE, LOCATION	SAN. MH. CAST, ELEV. INV. ELEV.	SAN. CONN. SIZE, LOC. DEPTH

DESIGN CERTIFICATION
THIS PLAN WAS PREPARED BY ME, AND IS CORRECT
TO THE BEST OF MY KNOWLEDGE AND BELIEF.
SURVEYOR Harry S. Jones, Jr. REGISTRATION NO. 8-0343

REMARKS
ALL BOUNDARY DATA SHOWN WAS OBTAINED FROM (DEEDS, RECORDED
SUBDIVISION PLAT OR OTHER PUBLIC RECORDS)
LOCATIONS AS SHOWN OF ADJACENT WELLS AND SEPTIC TANKS OBTAINED FROM
LAKE COUNTY HEALTH DEPARTMENT

LEGEND
AS BUILT ELEVATION
INDICATES
DIRECTION OF
SURFACE DRAINAGE
PROPOSED CONTOURS
EXISTING CONTOURS
HYDRANT
INLET OR CATCH BASIN
STORM MANHOLE
SANITARY MANHOLE
EXST. ELEV. 100.0
PROP. ELEV. 100.0

OWNER Mr. & Mrs. Jones
CLIENT Mr. & Mrs. Jones
FOR: Mr. & Mrs. Jones
COUNTY, OHIO
ADDRESS 10000 N. Main St. CITY Wadsworth ZIP 44157
SUBDIVISION Maple Preserve NAME Maple Preserve
LOT 57 VOL-PG. 61-26
STREET Maple Preserve PERM. PARCEL NO. 57