

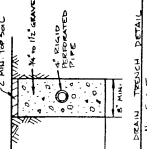
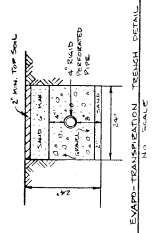
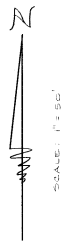


CONTRACT No. 86-000
SHEET 1 OF 1

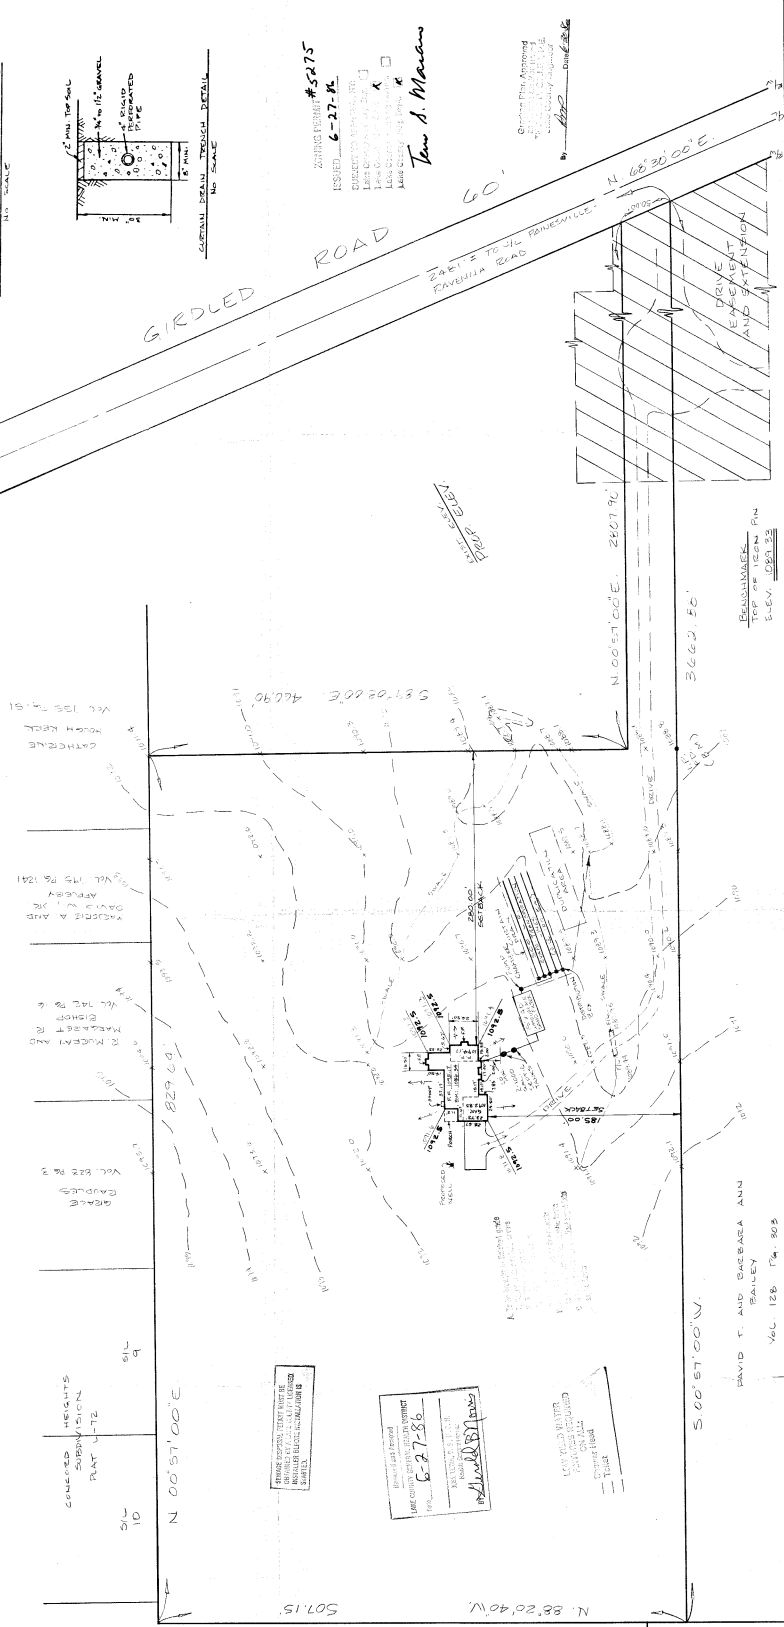

ZONING PERMIT #5875
ISSUED 6-27-86
EXEMPT TO ZONING ORDINANCE
TOWN OF CANTON, OHIO
TAM A. MARAN

HYDRAULIC PROFILE
SCALE: 1" = 50'

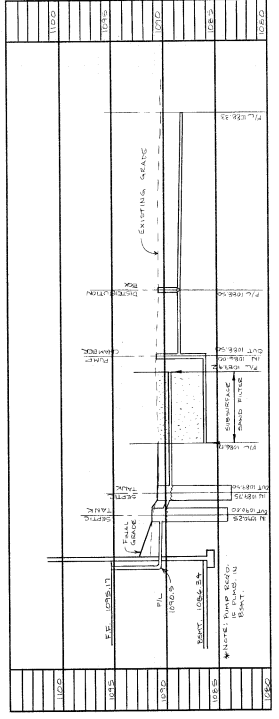

DATE OF PLAN: 6-27-86
SCALE: HORIZ. 1" = 50'
SCALE: VERT. 1" = 5'
CHECKED BY: [Signature]
DATE: FEB 24 1993

SITE PLAN
ME KING
BEING PART OF LOT NO. 2 TRACT NO. 1,
CONCEDED TOWNSHIP, LAKE COUNTY, OHIO.

DATE OF PLAN: 6-27-86
SCALE: HORIZ. 1" = 50'
SCALE: VERT. 1" = 5'
CHECKED BY: [Signature]
DATE: FEB 24 1993

COLPETZER · WOODS
CONSULTANTS, INC.
MENTOR, OHIO 44060



REV. NO.	DATE	BY	DESCRIPTION

DESIGN CERTIFICATION
I, the undersigned, being a duly licensed Professional Engineer in the State of Ohio, do hereby certify that the above design was prepared by me or under my direct supervision and that I am a duly licensed Professional Engineer in the State of Ohio.



JAMES C. HOWARD
VOL. 597 PG. 94

MARY LEGAN
VOL. 128 PG. 805