

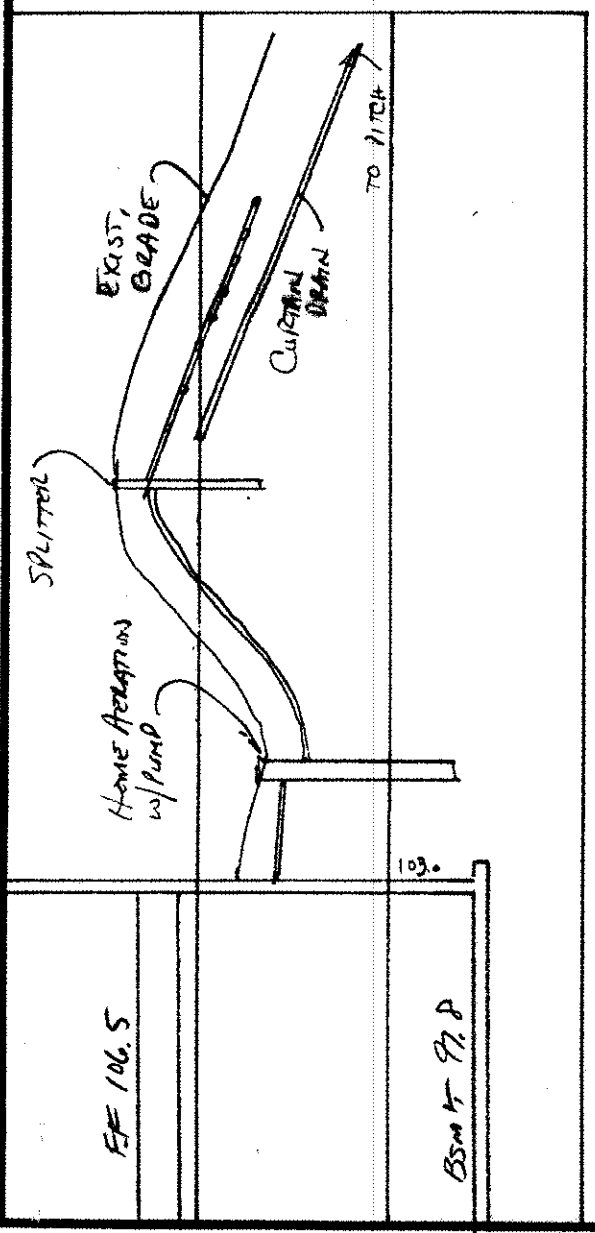
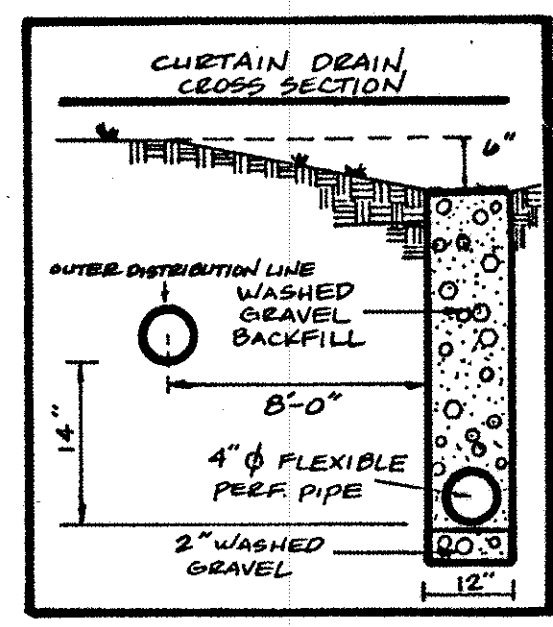


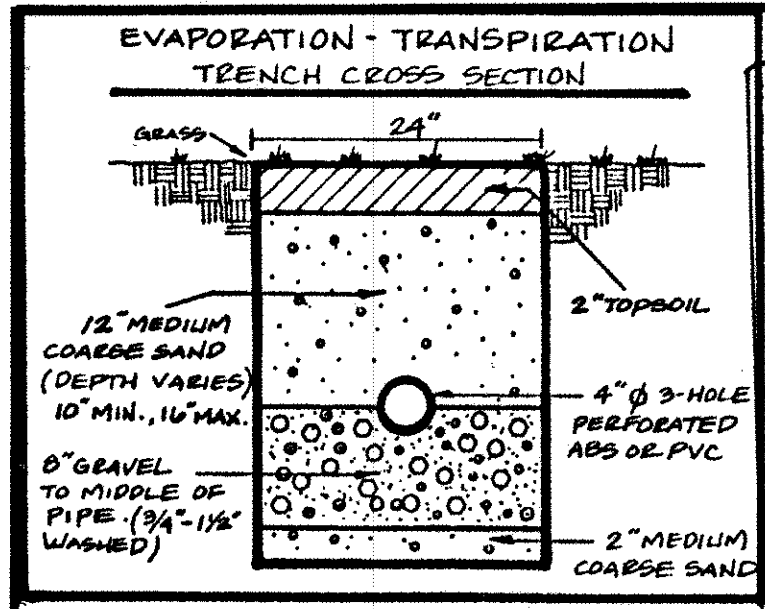

HYDRAULIC PROFILE
SLOPE: 1:40' VERT.: 1:5'

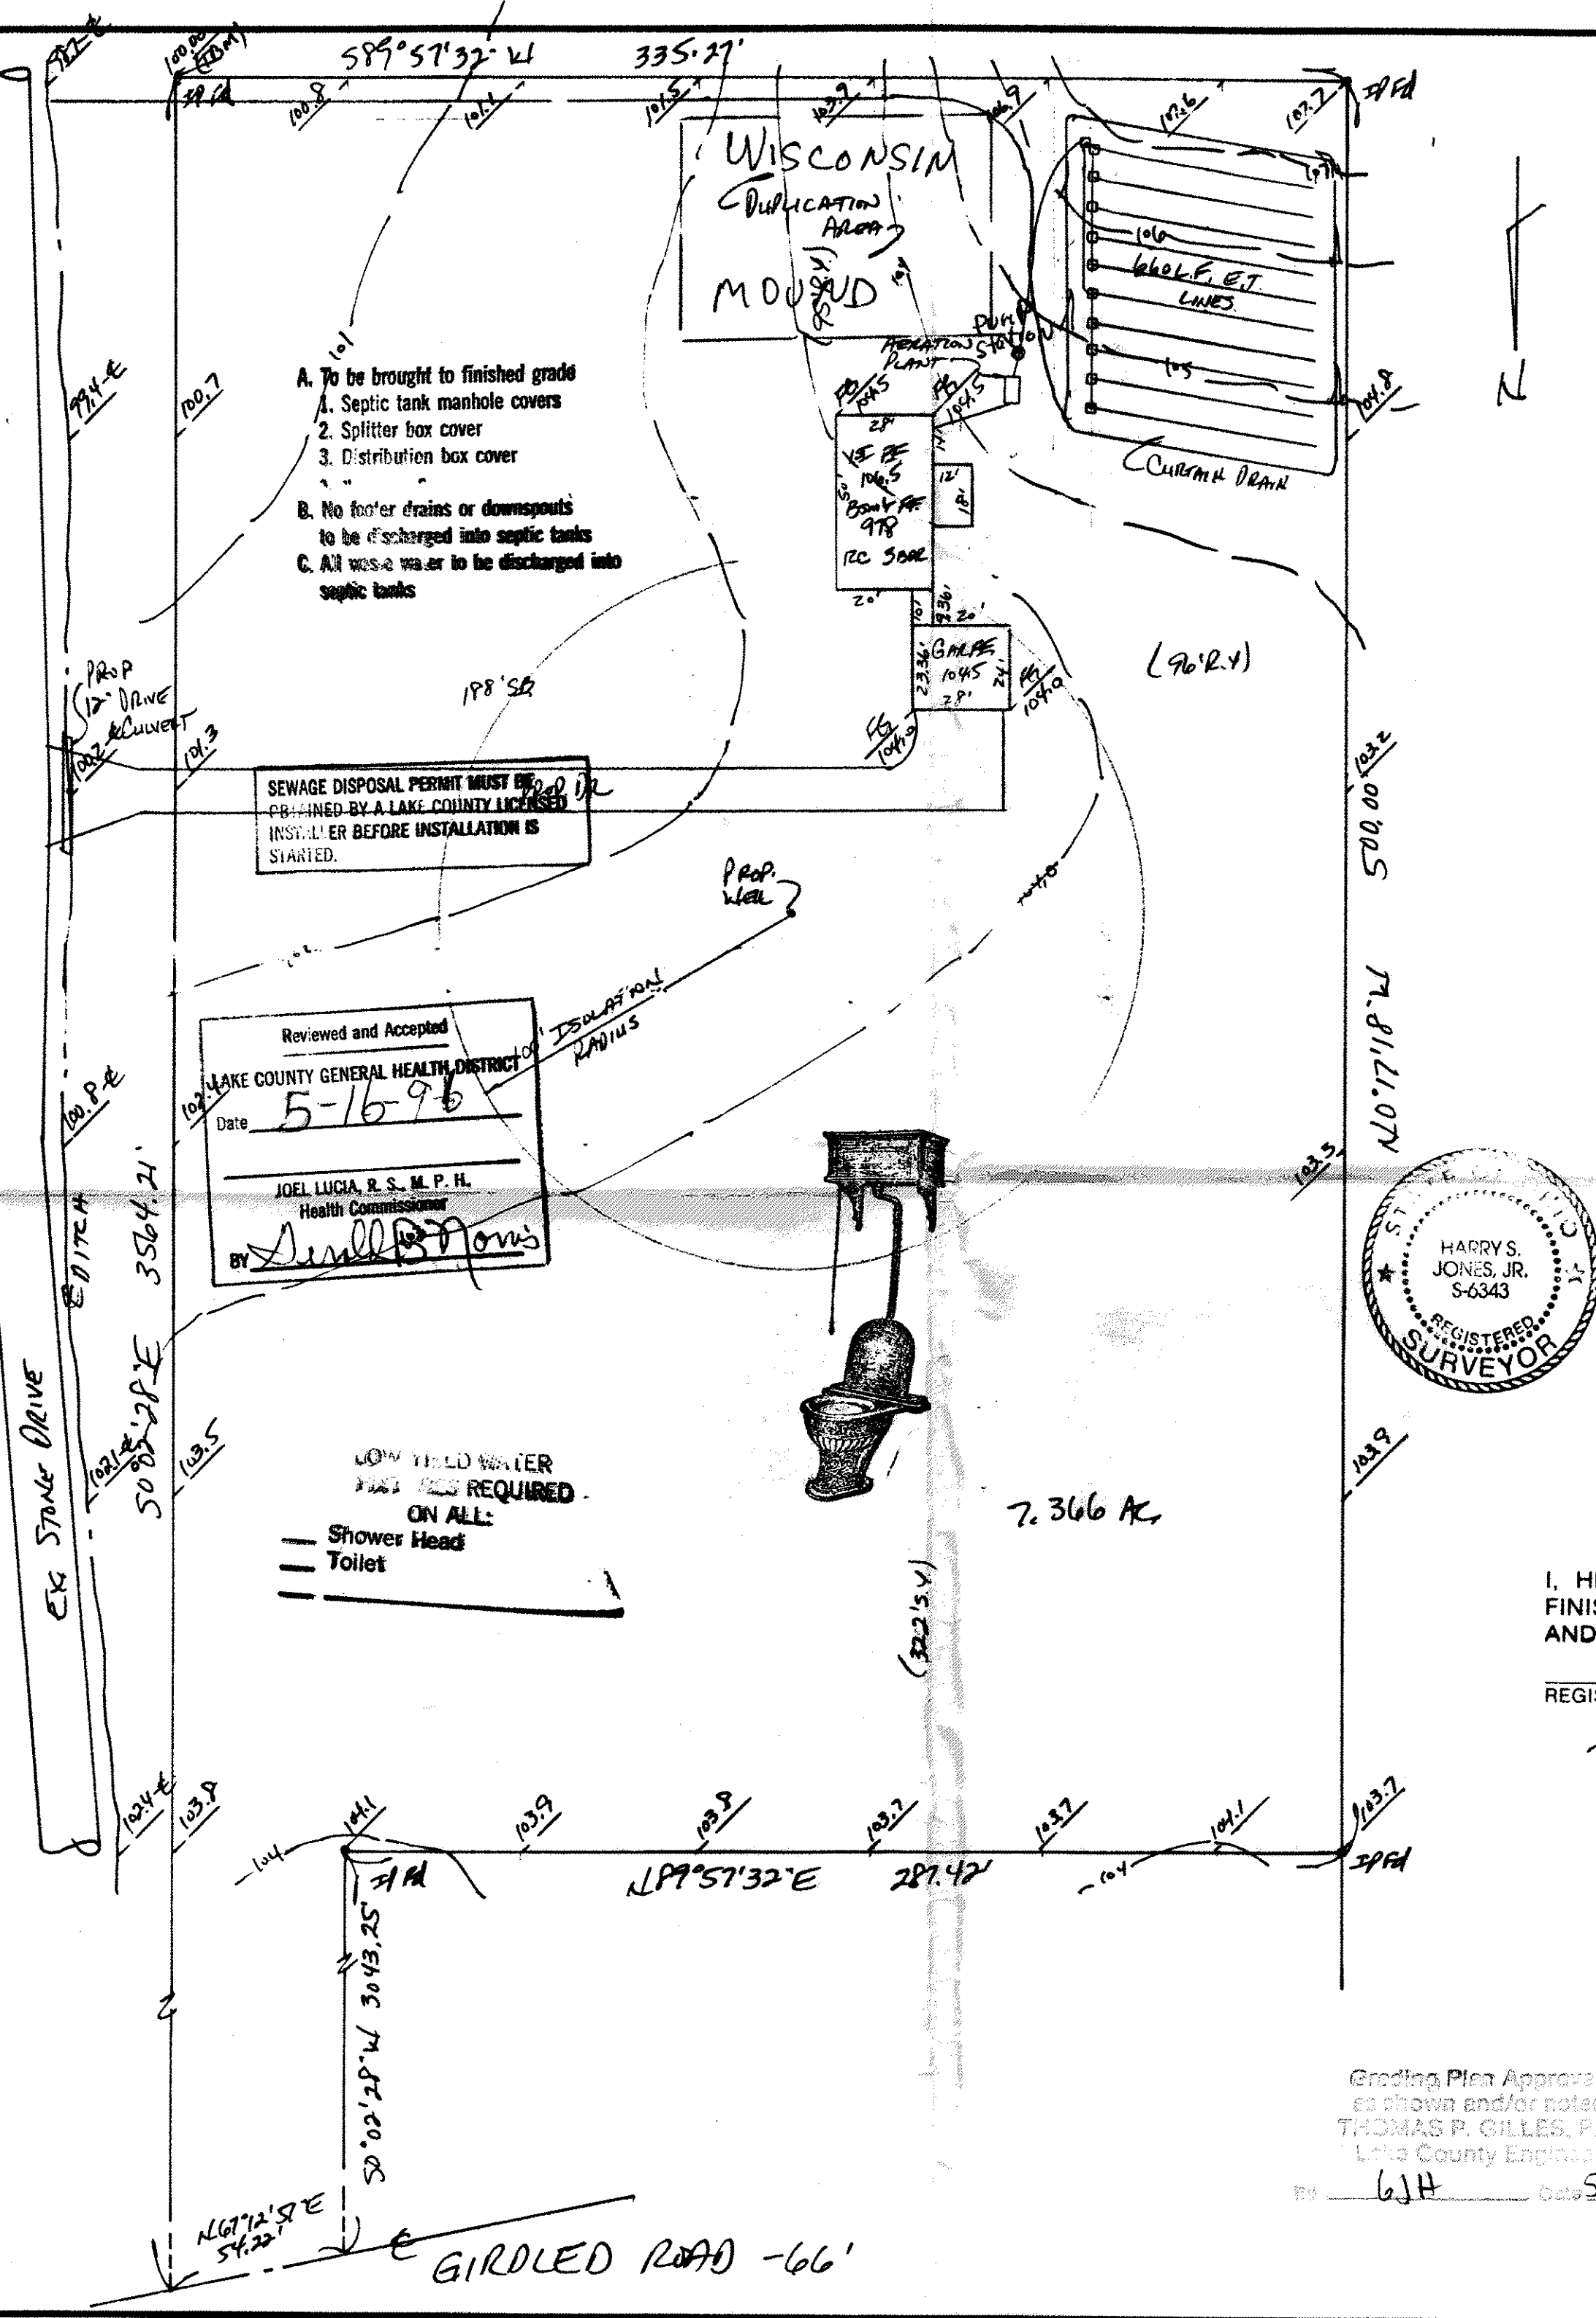


- A. To be brought to finished grade
1. Septic tank manhole covers
 2. Splitter box cover
 3. Distribution box cover
- B. No footer drains or downspouts to be discharged into septic tanks
- C. All waste water to be discharged into septic tanks

SEWAGE DISPOSAL PERMIT MUST BE OBTAINED BY A LAKE COUNTY LICENSED INSTALLER BEFORE INSTALLATION IS STARTED.

Reviewed and Accepted
LAKE COUNTY GENERAL HEALTH DISTRICT
Date 5-16-96
JOEL LUCIA, R.S., M.P.H.
Health Commissioner
BY Deirdre Brown

LOW YIELD WATER TREATMENT REQUIRED ON ALL:
— Shower Head
— Toilet

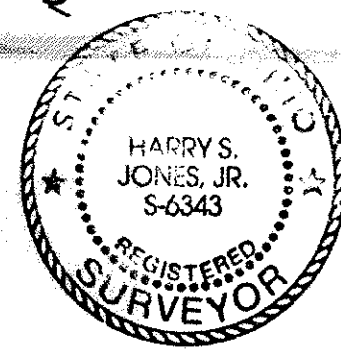

SITE PLAN

CONCORD TOWNSHIP, LAKE COUNTY, OHIO

for: CEDARCRAFT, Inc

CLIENT: _____ OWNER: _____

ADDRESS: _____ STREET: _____ CITY: _____ ZIP: _____

SUBDIVISION NAME		LOT TRACT	
VOL. - PG.		PAGE	
SUBLOT NO. STREET		PERM. PARCEL NO. STREET	

LEGEND

SANITARY MANHOLE	---	WATER VALVE (GAS)	---
STORM MANHOLE	---	WATER METER (GAS)	---
INLET OR CATCH BASIN	---	AS BUILT ELEVATION	100.0
HYDRANT	---	INDICATES DIRECTION OF SURFACE DRAINAGE	↓
EXISTING CONTOURS	---		
PROPOSED CONTOURS	---		
EXIST. ELEV.	100.0	PROP. ELEV.	100.0

REMARKS

ALL BOUNDARY DATA SHOWN WAS OBTAINED FROM (DEEDS, RECORDED SUBDIVISION PLAT OR OTHER PUBLIC RECORDS)

LOCATIONS AS SHOWN OF ADJACENT WELLS AND SEPTIC TANKS OBTAINED FROM LAKE COUNTY HEALTH DEPARTMENT

DESIGN CERTIFICATION

THIS PLAT WAS PREPARED BY ME, AND IS CORRECT TO THE BEST OF MY KNOWLEDGE AND BELIEF.

NAME: Harry Jones SURVEYOR REGISTRATION NO. 46343

CHECK LIST

NO. OF BEDROOMS	WATER MAIN SIZE, LOCATION
DIMENSIONS	SAN. SEWER SIZE % GR. LOC.
BEARINGS	SAN. MH. CAST. ELEV. INV. ELEV.
TIE TO NEAREST STREET	SAN. CONN. SIZE, LOC. DEPTH
SUBLOT NO. PARCEL NO.	STORM SEWER SIZE % GR. LOC.
SURROUNDING OWNERS	STORM MH. CAST. ELEV. INV. ELEV.
BLDG. DIMENSIONS FIN. GR.	PAV'T TYPE GRADE CURBS
BLDG. TIES FL'R. GRADES	GAS LINE LOC. SIZE PRESSURE
APRON TYPE WIDTH THICKNESS	SEPTIC TANK LOCATION & DUPLICATION AREA
SIDEWALK TYPE WIDTH THICKNESS	WELL LOCATION
CULVERT TYPE DIA. LENGTH	ISOLATION RADIUS FROM WELL
ROCK OUTCROPPINGS	

PLAN PREPARED BY:

BABCOCK • JONES & ASSOCIATES, INC.

PAINESVILLE, OHIO

DRAWN BY <u>HJ</u>	SCALE <u>1" = 40'</u>	PHONE NO. <u>357-1811</u>
CHK'D. <u>HJ</u>	DATE <u>4/10/96</u>	DRAWING NO. <u>96-073</u>
CREW CHIEF <u>WJ</u>	APP'D. <u>HJ</u>	

"AS BUILT" CERTIFICATION

I, HEREBY CERTIFY THAT THE CIRCLED GRADES ARE EXISTING FINISH GRADES CHECKED IN THE FIELD ON _____, 19____ AND ARE CORRECT TO THE BEST OF MY KNOWLEDGE AND BELIEF.

REGISTERED SURVEYOR _____ REG. NO. _____

TBM - TOP OF IRON PIN @ S.E. CORNER OF THIS PARCEL
ELEV. = 100.00

I, the undersigned hereby certify that the topography indicated by 6", 1" or 2" contours, and elevations shown hereon represent an actual field survey made by me on the 2nd day of APRIL, 1996 and that the elevations were taken at appropriate intervals and that as of that date they existed as indicated hereon.

Harry Jones #6343
Reg. No.

Grading Plan Approved as shown and/or noted
THOMAS P. GILLES, P.E.
Lake County Engineer

By GJA Date 5.23.96