

SITE PLAN

LOREND TOWNSHIP, LAKE COUNTY, OHIO

for: DUNNA DOEDERLEIN 951-6340

CLIENT OWNER

ADDRESS STREET CITY ZIP

SUBDIVISION	NAME	LOT	TRACT
VOL. - PG.			
SUBLOT NO.	STREET	VOLUME	PAGE
			GRADED PD
			STREET

LEGEND

SAINTARY MANHOLE	WATER VALVE (GAS)
STORM MANHOLE	WATER METER (GAS)
INLET OR CATCH BASIN	AS BUILT ELEVATION
HYDRAUNT	INDICATES DIRECTION OF SURFACE DRAINAGE
EXISTING CONTOURS	
PROPOSED CONTOURS	
EXIST. ELEV.	100.0
PROP. ELEV.	100.0

REMARKS

ALL BOUNDARY DATA SHOWN WAS OBTAINED FROM (DEEDS, RECORDED SUBDIVISION PLAT OR OTHER PUBLIC RECORDS) LOCATIONS AS SHOWN OF ADJACENT WELLS AND SEPTIC TANKS OBTAINED FROM LAKE COUNTY HEALTH DEPARTMENT

DESIGN CERTIFICATION

THIS PLAT WAS PREPARED BY ME, AND IS CORRECT TO THE BEST OF MY KNOWLEDGE AND BELIEF

NAME SUPERVISOR REGISTRATION NO.

CHECK LIST

NO. OF BEDROOMS	WATER MAIN SIZE	LOCATION
DIMENSIONS	SAN. SEWER SIZE	% GR. LOC.
BEARINGS	SAN. MH. CAST. ELEV.	INV. ELEV.
THE TO NEAREST STREET	SAN. CONN. SIZE	LOC. DEPTH
SUBLOT NO. PARCEL NO.	STORM SEWER SIZE	% GR. LOC.
ADJACENT OWNERS	STORM MH. CAST. ELEV.	INV. ELEV.
BLDG. DIMENSIONS FIN. OR	PAV. TYPE	GRADE CURBS
BLDG. TIES P.T. GRADES	GAS LINE	LOC. SIZE PRESSURE
ADJ. TYPE WITH THICKNESS	SEPTIC TANK	LOCATION & DUALICATION AREA
SEWER TYPE WITH THICKNESS	WELL	LOCATION
SEWER TYPE DIA. LENGTH	ISOLATION RADIIUS	FROM WELL
ROCK OUTCROPPINGS		

PLAN PREPARED BY:

BABCOCK • JONES & ASSOCIATES, INC.

PAINEVILLE OHIO

NO.	DATE	BY	SCALE	PHONE NO.
1	6-12-91	✓	1" = 40'	357-1811
2				
3				
4				
5				

"AS BUILT" CERTIFICATION

I, HEREBY CERTIFY THAT THE CIRCLED GRADES ARE EXISTING FINISH GRADES CHECKED IN THE FIELD ON 19 19 AND ARE CORRECT TO THE BEST OF MY KNOWLEDGE AND BELIEF.

REGISTERED SURVEYOR

REG. NO.

T.B.M. TOP OF IRON PIN 5/8 CORNER OF

LOT, ELEV. = 100.00

"I, the undersigned hereby certify that this topography indicated by 6', 1' or 2' contours, and elevations shown hereon represent an actual field survey made by me on the 2nd day of June 1991 and that the elevations were taken at appropriate intervals and that as of that date they existed as indicated hereon."

Name

6343

Reg. No.

LOT# NEED NUMBER
EXCHANGES REQUIRED
ON FILE
Shower Room
Toilet


PACCEL #4
1.313 AC

REPLACEMENT AREA
W/ AERATION PLANT

(232.75)

N 22° 45' W 476.70'

N 22° 45' W 476.70'

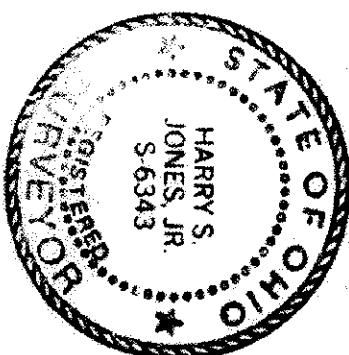


SEWER DISPOSAL PERMIT MUST BE OBTAINED BY A LAKE COUNTY LICENSED INSTALLER BEFORE INSTALLATION IS STARTED.

1. To be brought to finished grade
2. Slope and manhole covers
3. Siphon box cover
4. Distribution box cover
5. No footer drains or downspouts to be discharged into septic tanks
6. All waste water to be discharged into septic tanks

Grading Plan Approved
as shown and/or noted
THOMAS P. GILLES, P.E.
Lake County Engineer
By GJH Date 6/20/91
Prop 15" DRIVE CULVERT.

S.E. 608

GIRDED ROAD - 66'

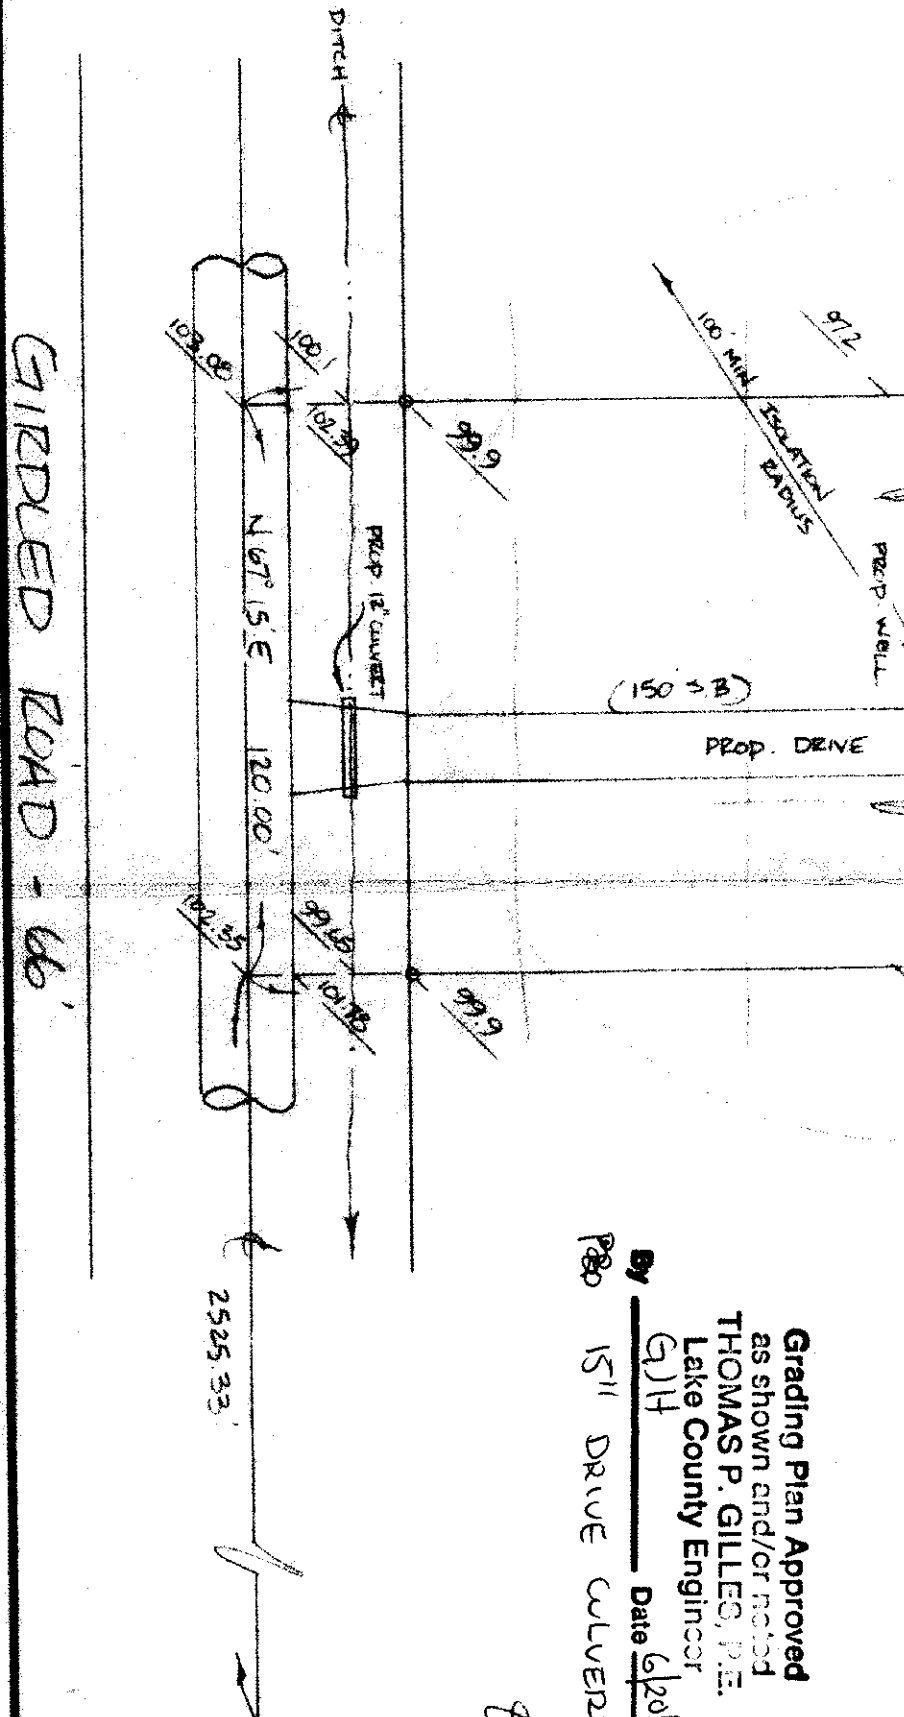

HYDRAULIC PROFILE

SCALE HORIZ. 1"=30', VERT. 1"=5'

