



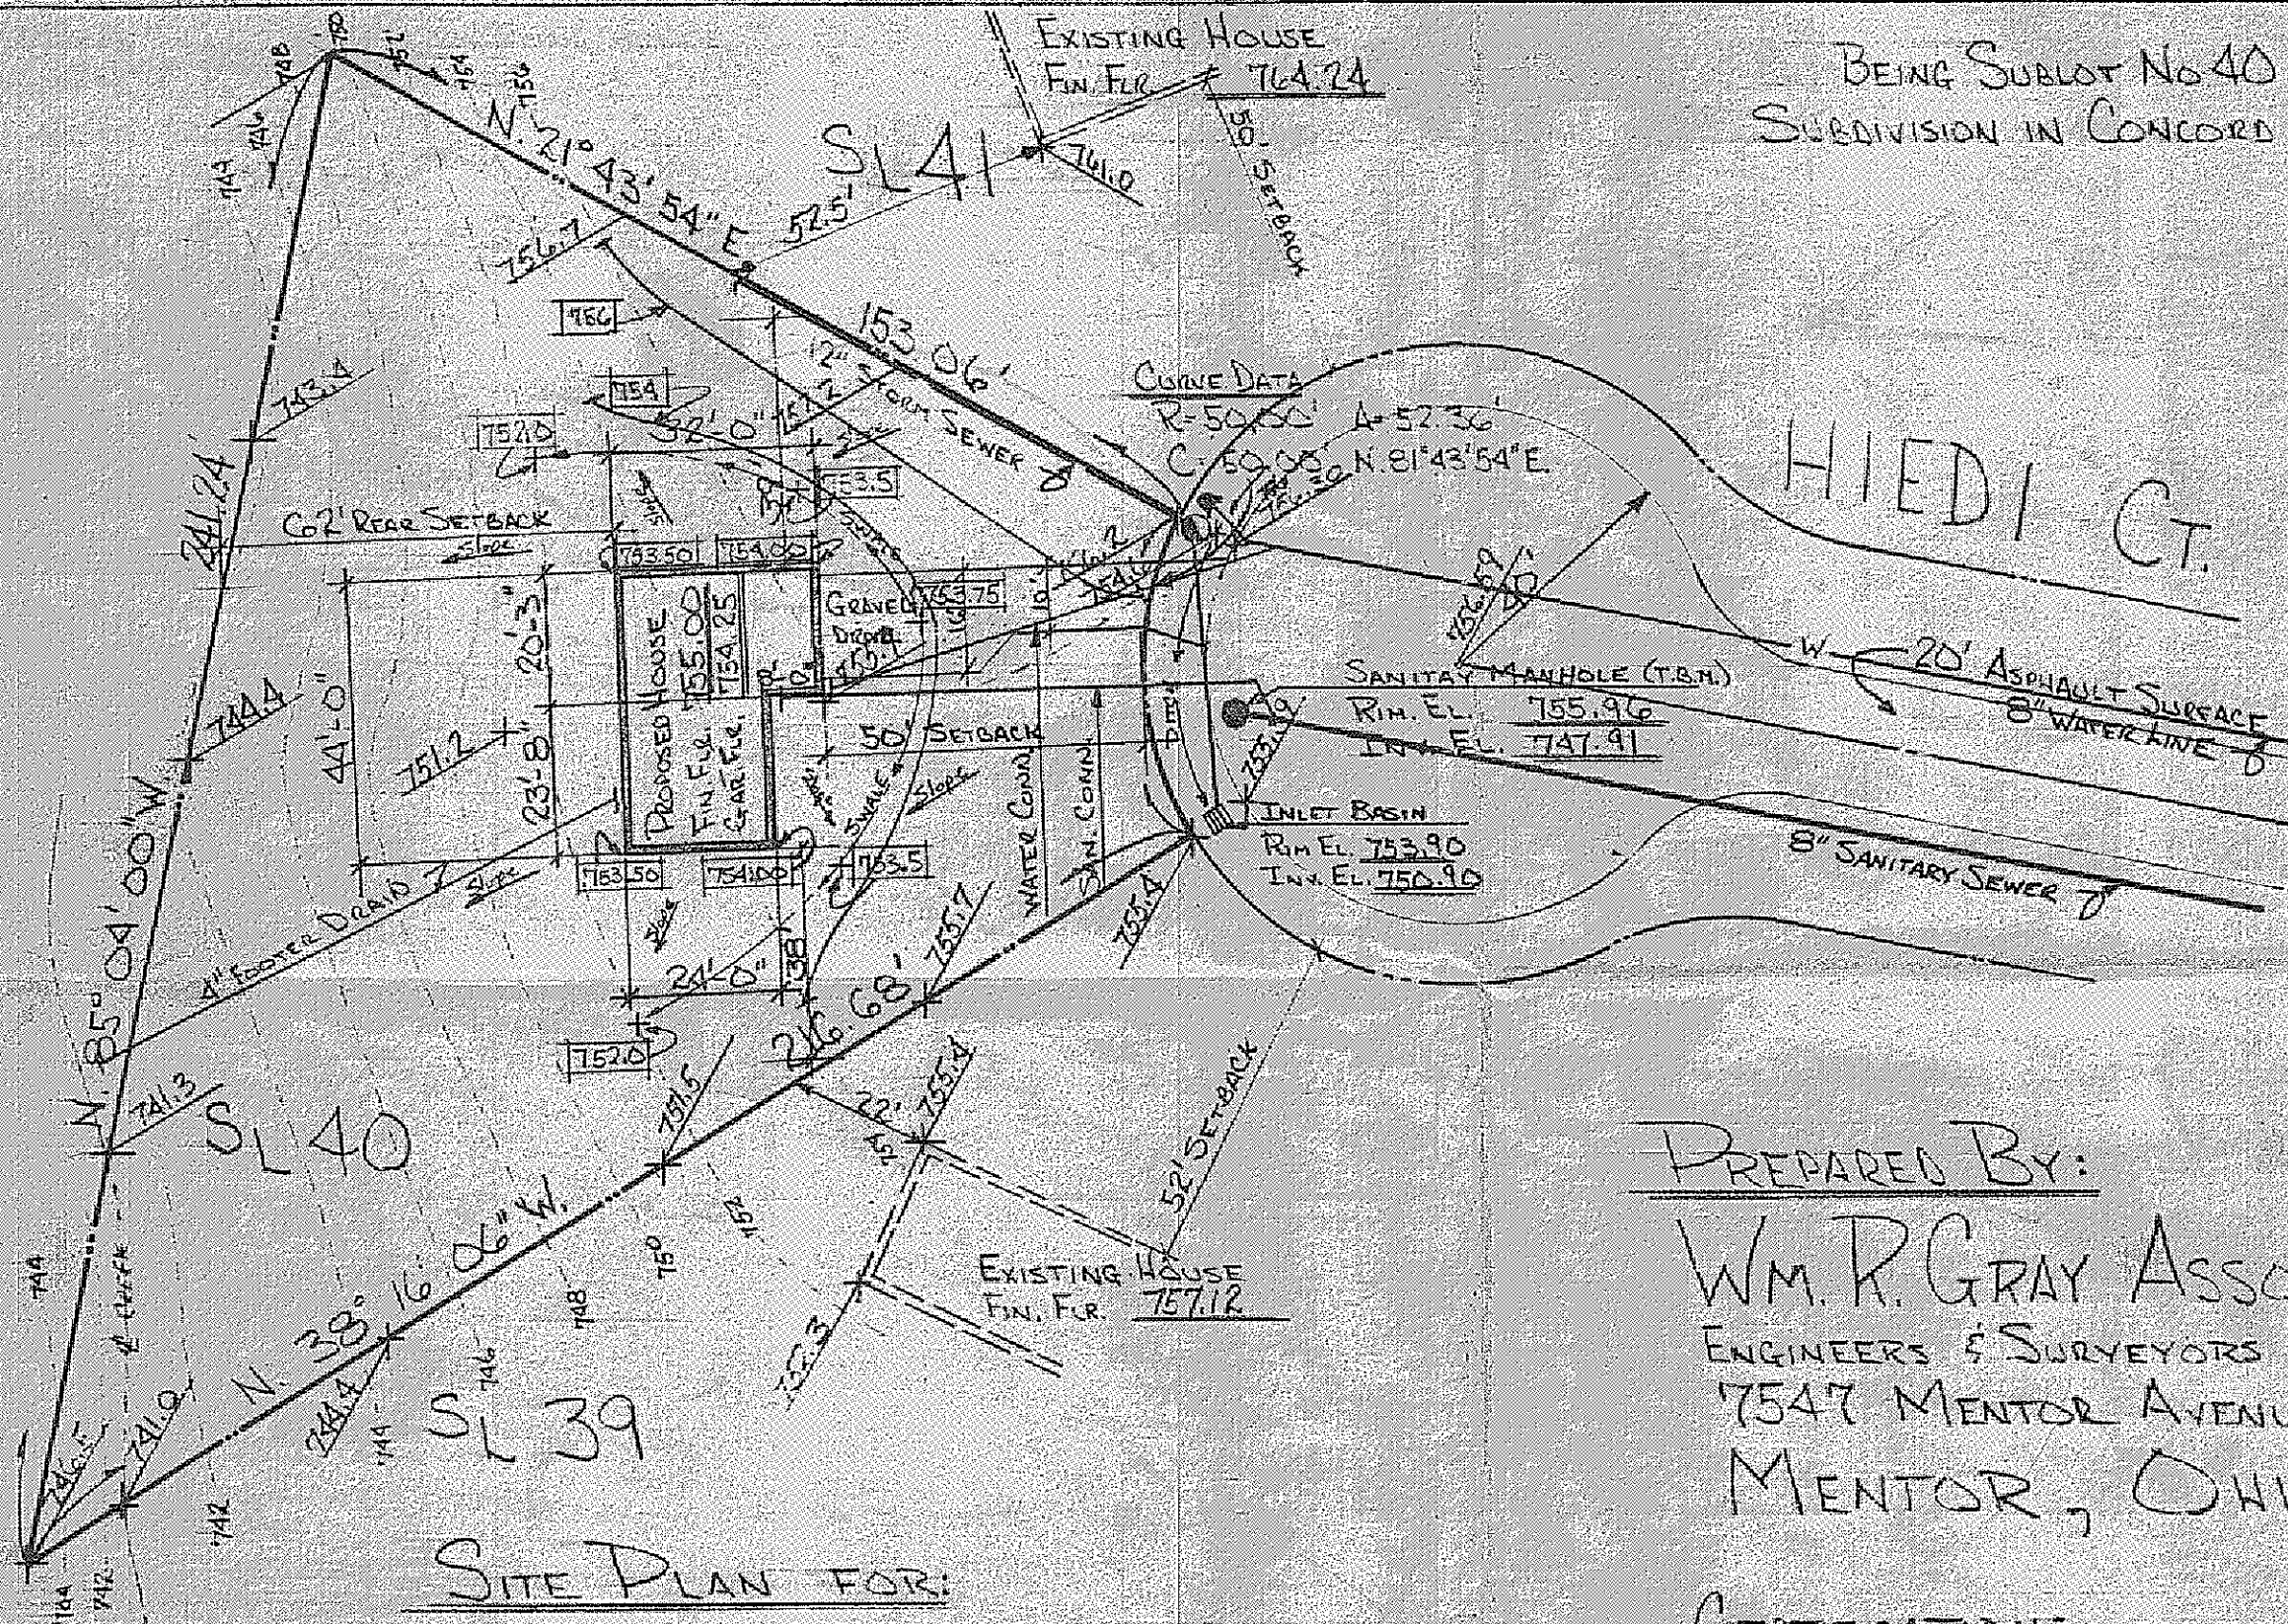

BEING SUBLT NO 40 IN CREEKVIEW PARK
SUBDIVISION IN CONCORD TWP., OHIO.

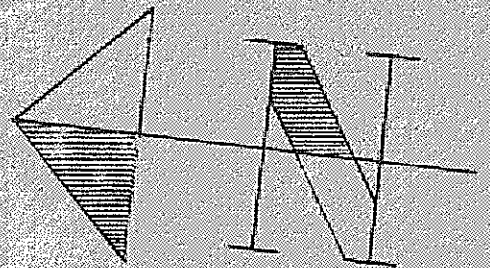

DATE: JULY 11, 1973
SCALE: 1" = 30'

Zoning Permit # 2572
issued July 12, 73
J.E. man Direct

PREPARED BY:
WM. R. GRAY ASSOC., INC.
ENGINEERS & SURVEYORS
7547 MENTOR AVENUE
MENTOR, OHIO

Grading Plan As
as shown and/or not
THOMAS P. GILLES, P.E.
Lake County Engineer

By JWK Date 16 July 73

SITE PLAN FOR:
RYAN HOMES, INC.
7660 CHIPPEWA ROAD
BRECKSVILLE, OHIO

CERTIFICATION:
I HEREBY CERTIFY THAT THIS PLAT IS
CORRECT TO THE BEST OF MY KNOWLEDGE.
By: Wm. R. Gray
Wm. R. Gray REG. SURV. # 2752

