
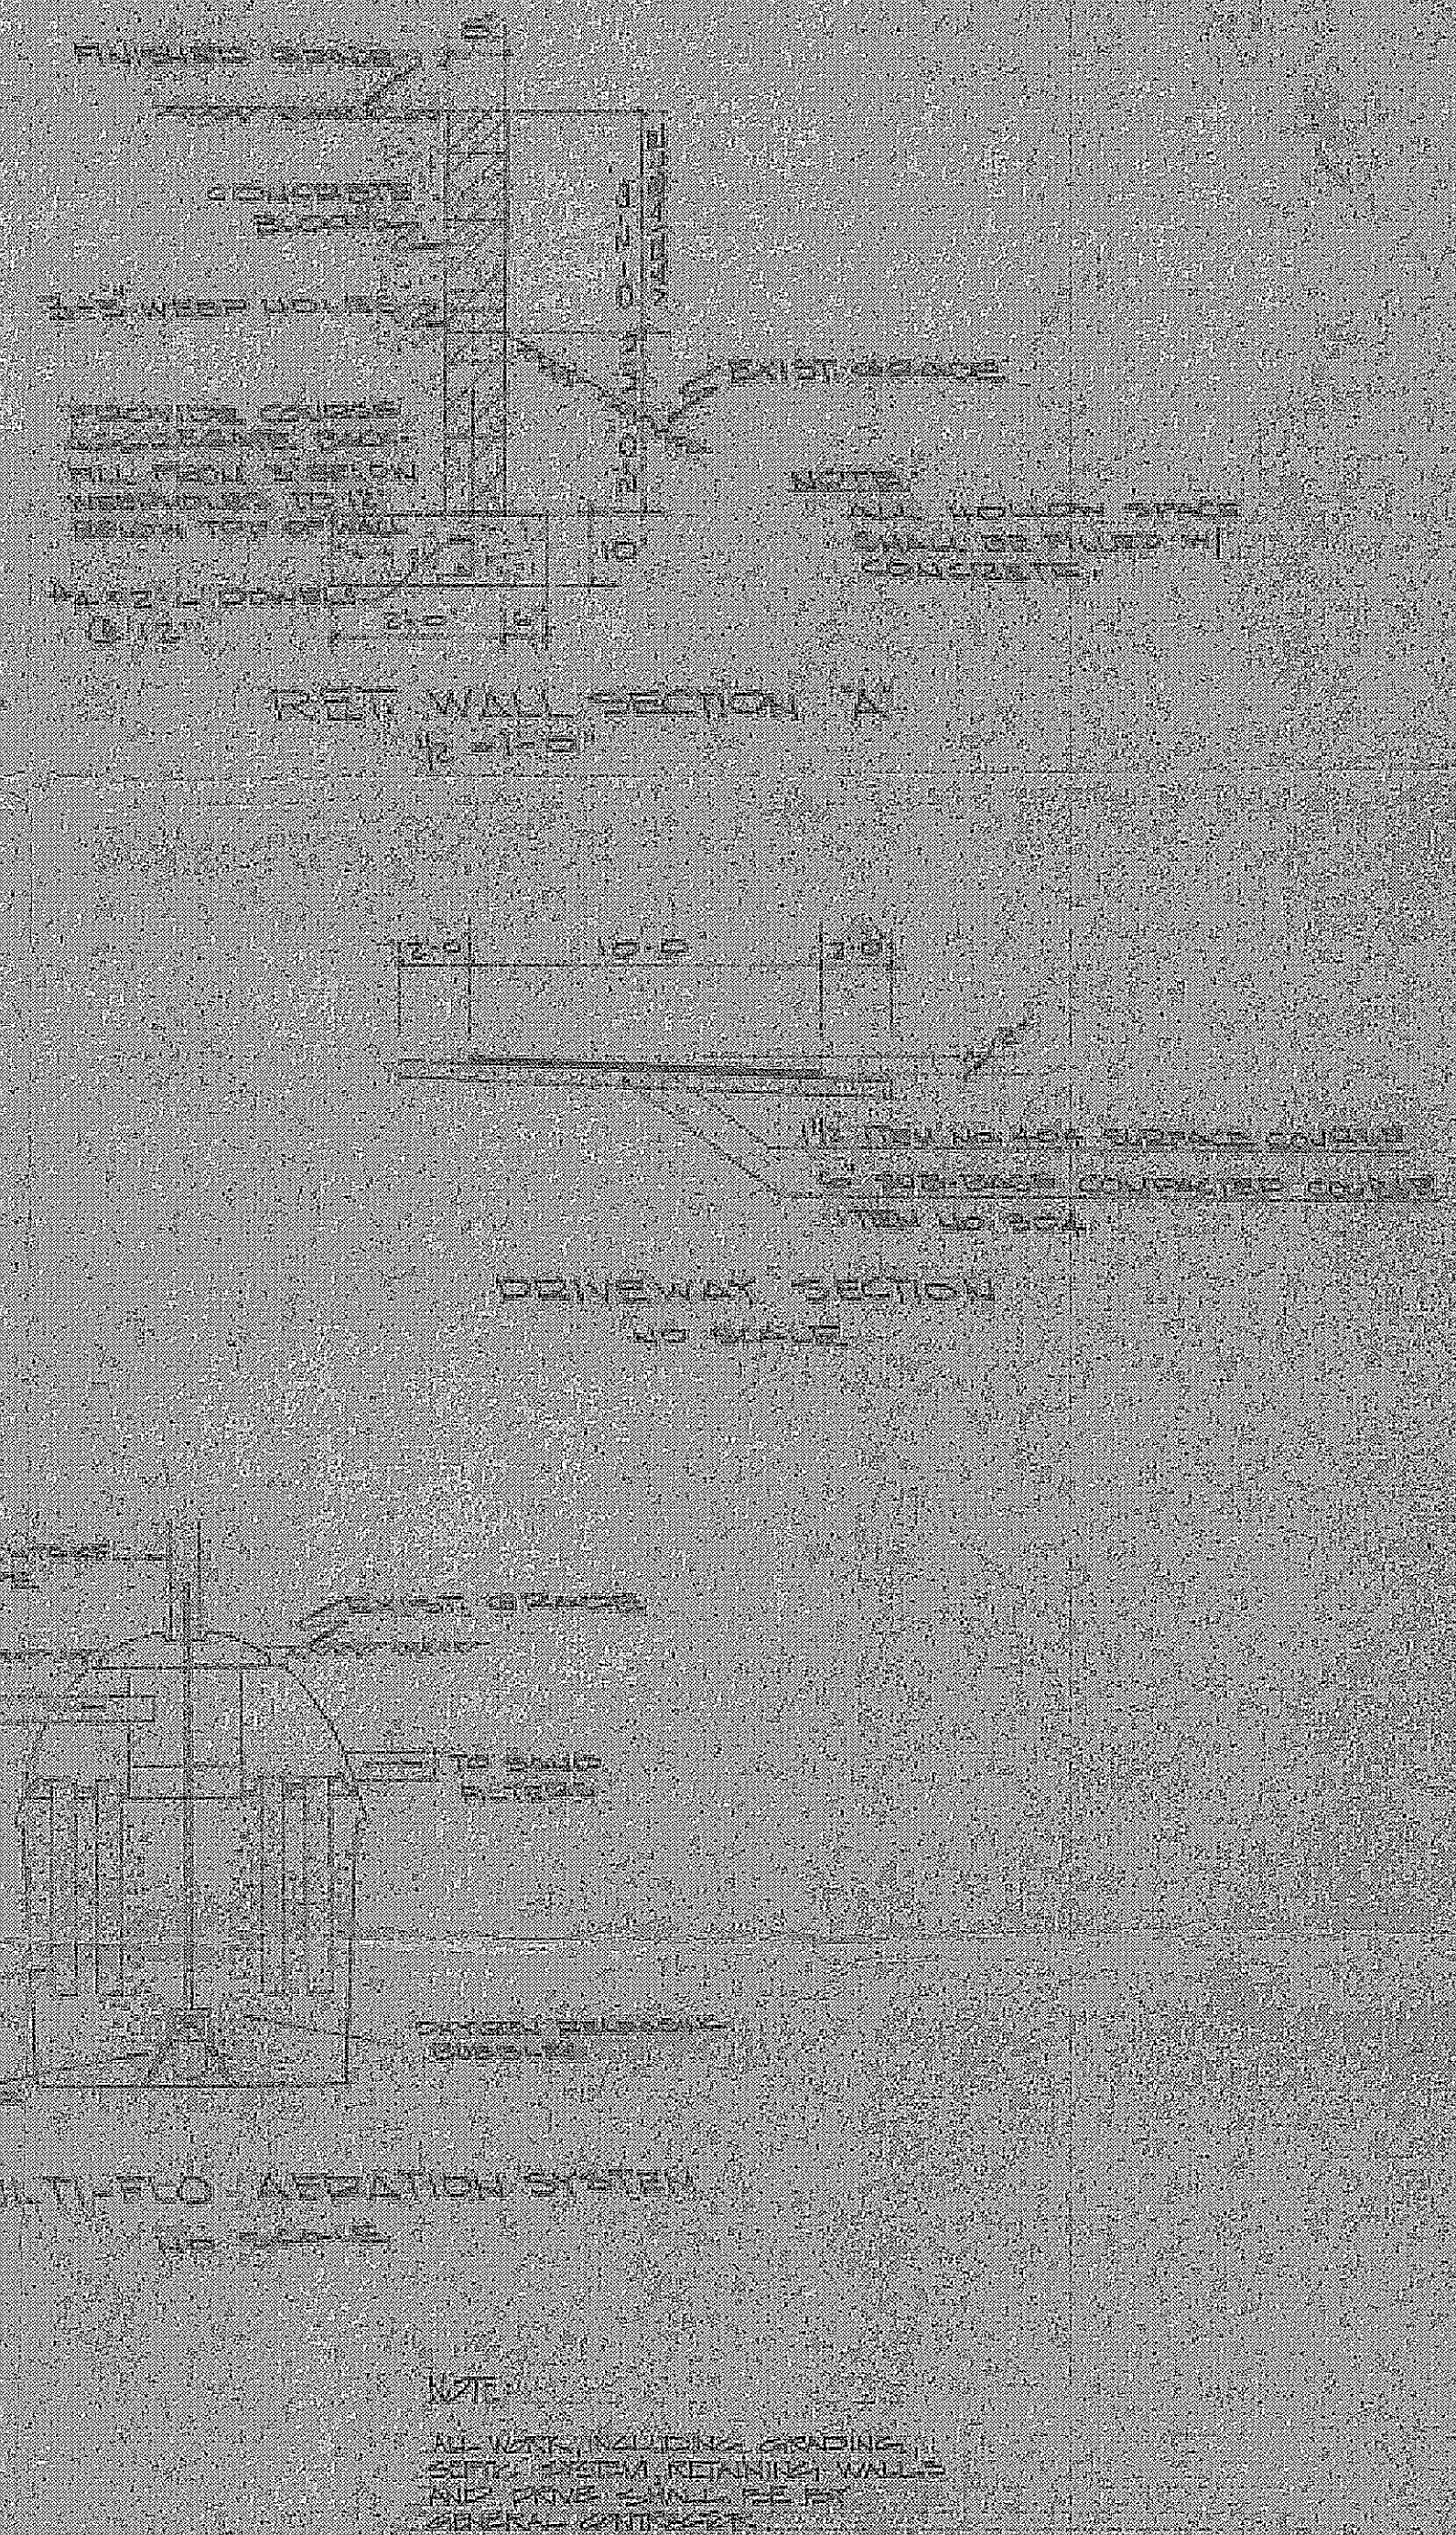


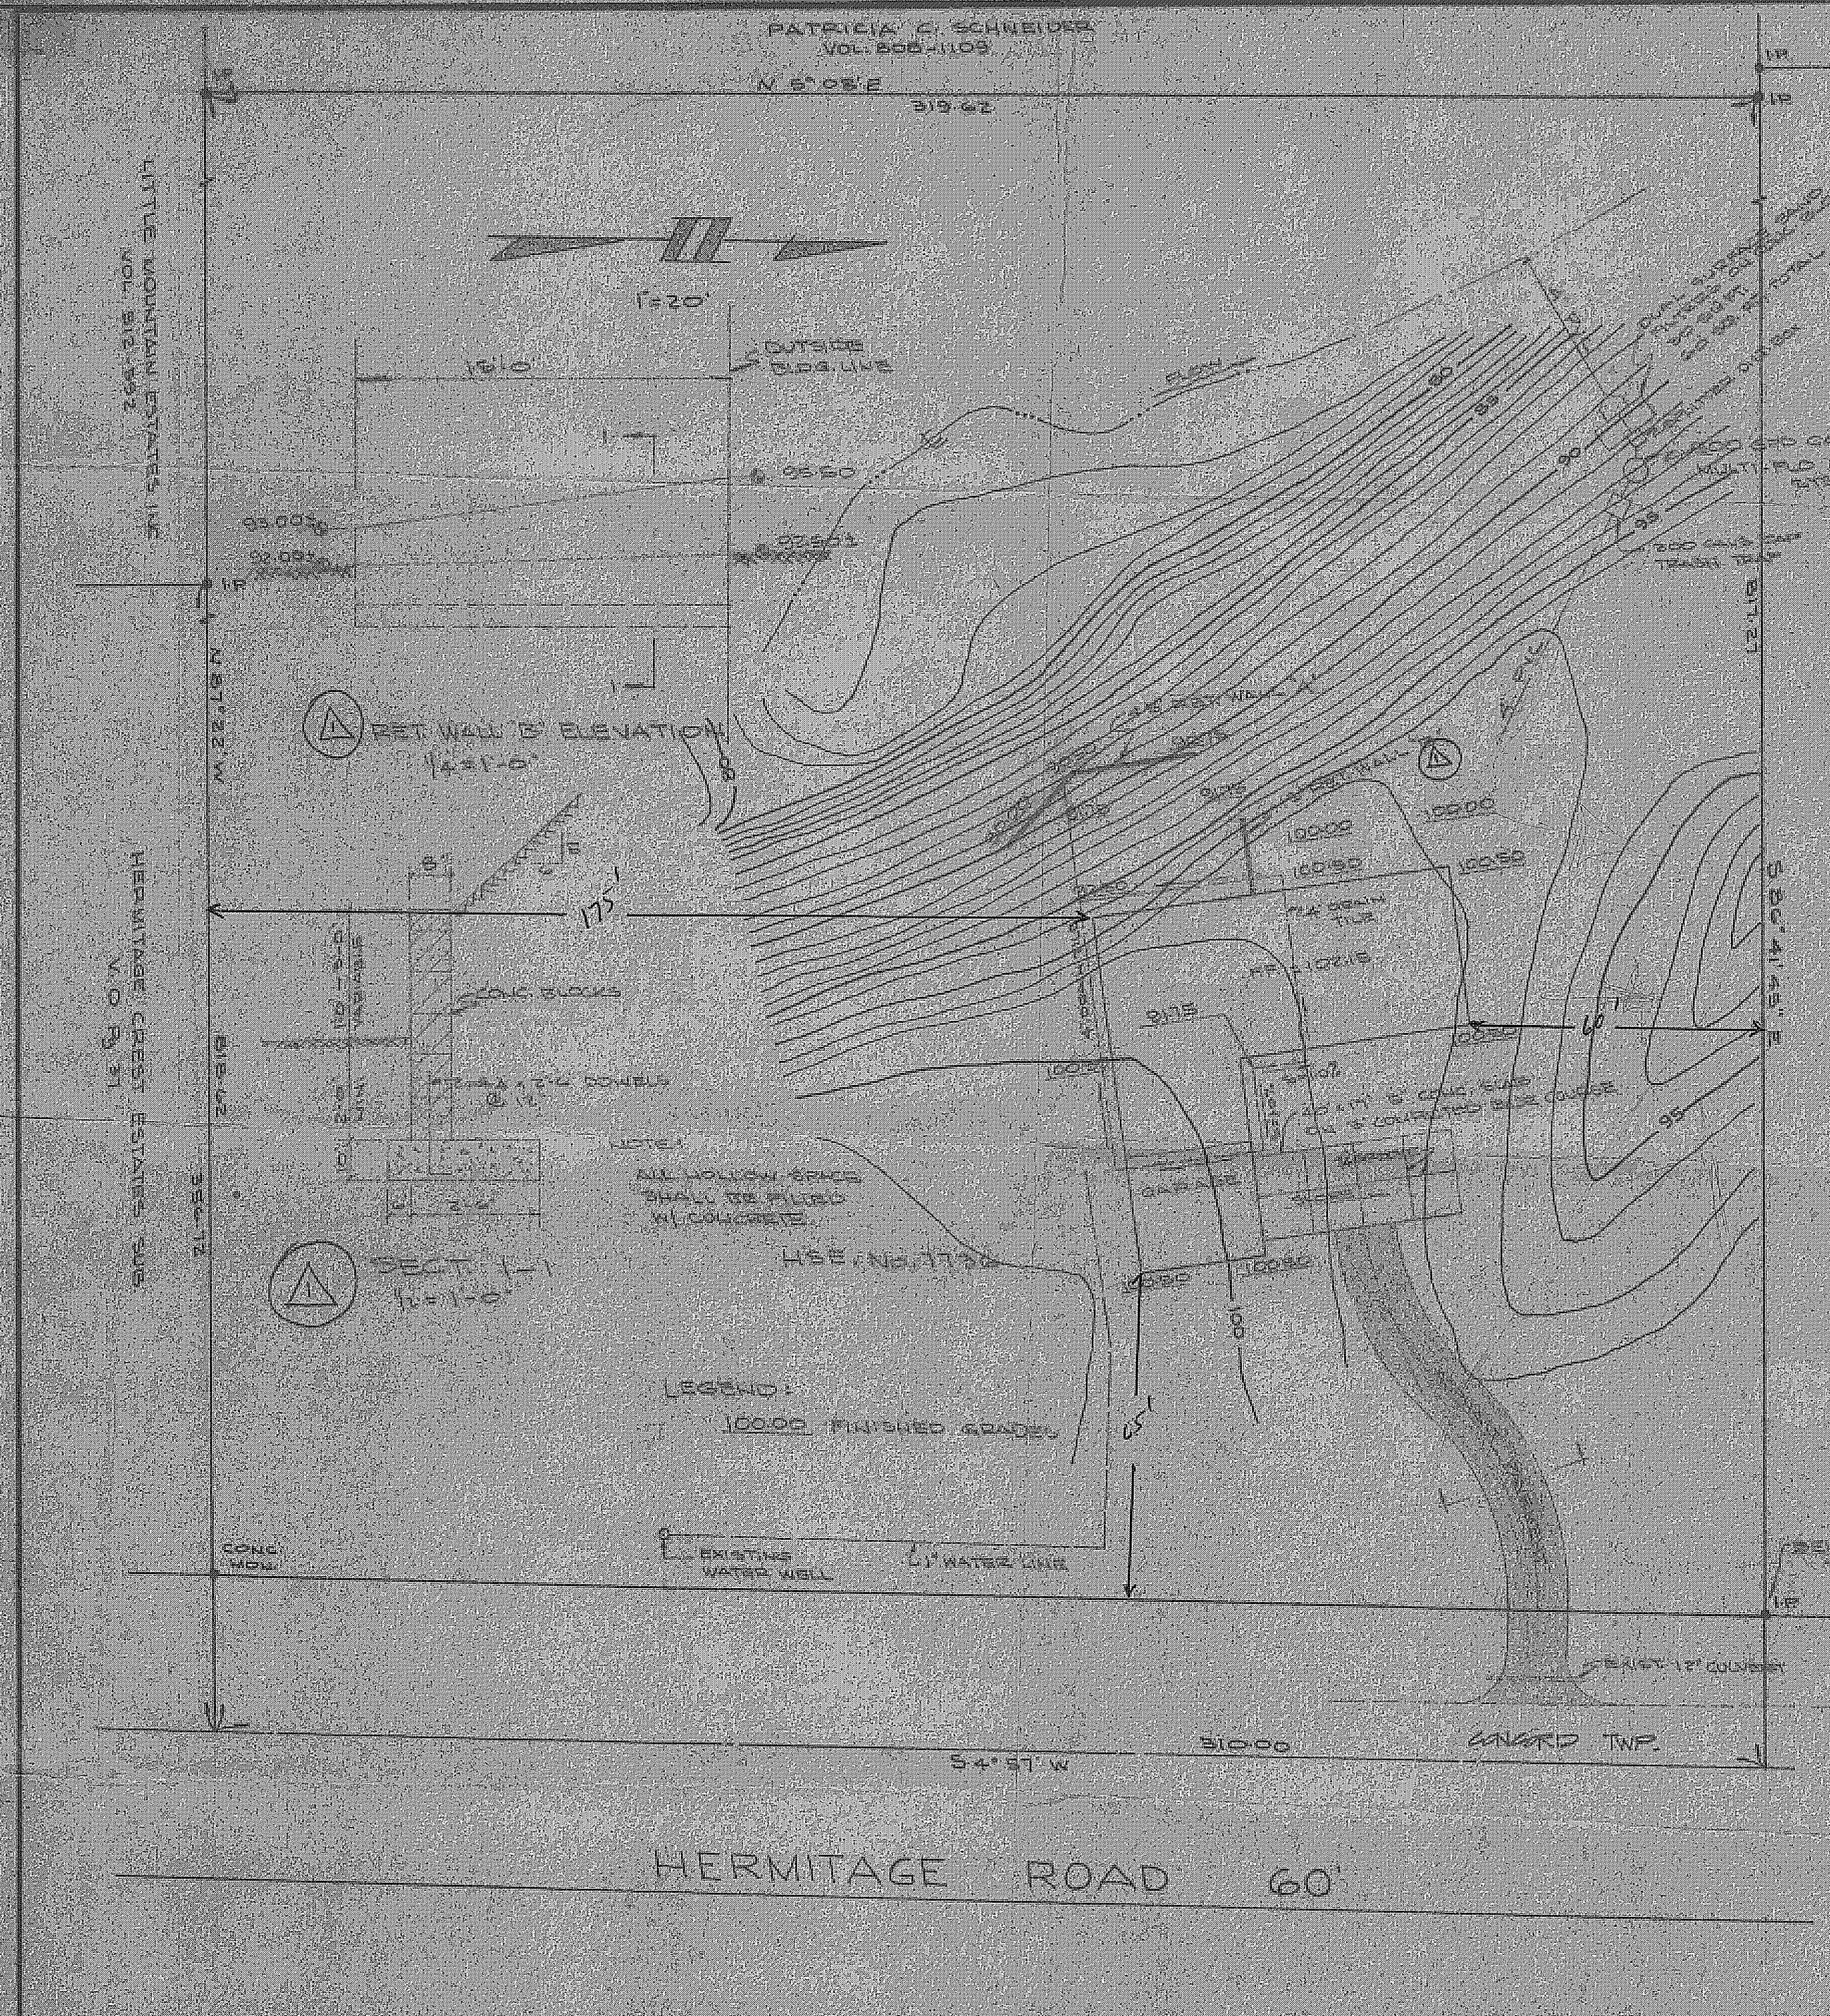

ZONING PERMIT

Grading Plan Approved as shown and/or noted
By THOMAS F. GILLES, P.E.
Lake County Engineer
Date 4-20-77

Approved 4-20-77
Richard F. Thomas

GRADING PLAN & DETAILS

Colpetzer • Woods Consultants, Inc.
CONSULTING ENGINEERS AND SURVEYORS
PAINESVILLE, OHIO 44077

DATE 3-4-76
SCALE 1" = 20'
DRAWN BY _____
CHECKED BY _____
P.E.# _____

Richard F. Thomas Associates
Architects and Land Planners
270 E. Main Street, Suite 20
Painesville, Ohio 44077
(216) 357 5080

VILLAGE RESIDENCE
1700 HERMITAGE ROAD
PAINESVILLE, OHIO
SITE PLAN

PN. 0200111 sheet 1
date 4-20-77 of 7

REV. Δ APPENDIX 2
REV. Δ OCT 6, 1976