


Zoning Permit # 2524
issued 7-19-73
H.E. van Dusen

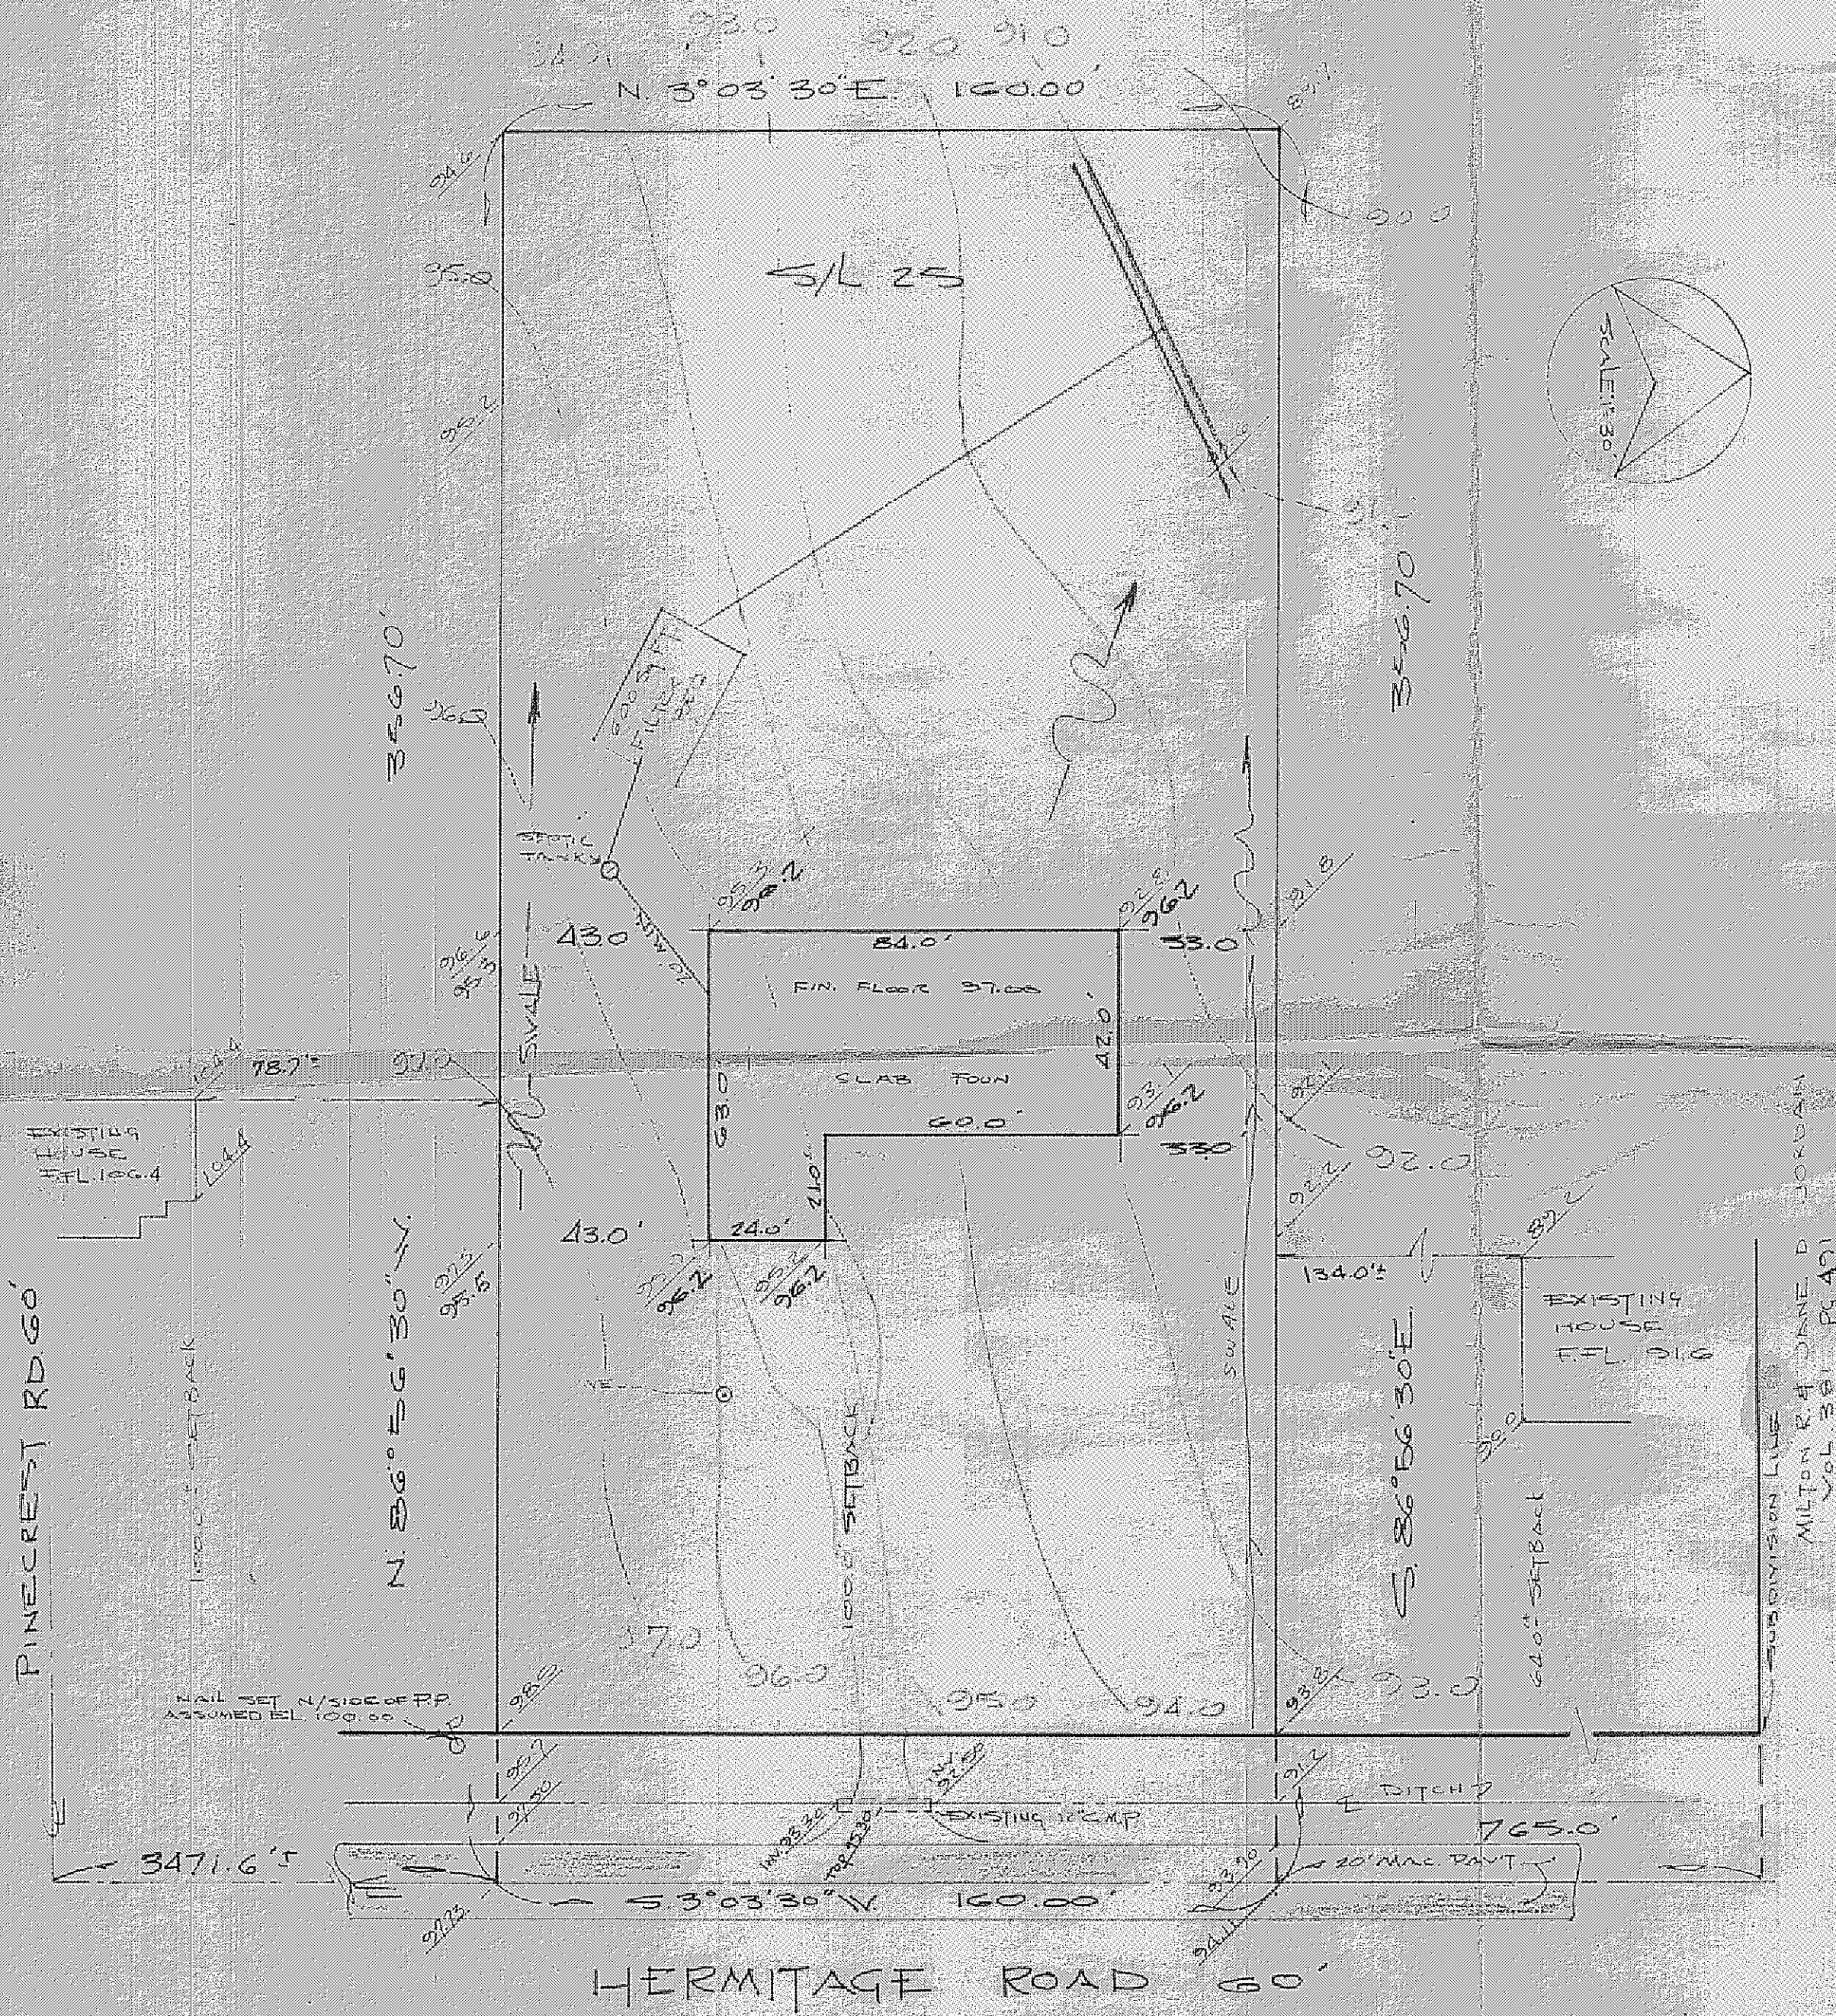

SITE PLAN

CONCORD TOWNSHIP LAKE COUNTY, OHIO

for R. + D. CONST. CLIENT OWNER

ADDRESS STREET CITY ZIP

HERMITAGE CREST ESTATES	LOT	TRACT
SUBDIVISION NO. 37	VOLUME	PAGE
# 25	PERM. PARCELS	STREET
SUBJECT NO.		

LEGEND

SANITARY MANHOLE	WATER VALVE (GAS)
STORM MANHOLE	WATER METER (GAS)
INLET OR CATCH BASIN	AS BUILT ELEVATION
HYDRANT	INDICATES DIRECTION OF SURFACE DRAINAGE
EXISTING CONTOURS	
PROPOSED CONTOURS	
EXIST ELEV. 100.0	
PROPOSED ELEV. 100.0	

REMARKS

ALL BOUNDARY DATA SHOWN WAS OBTAINED FROM DEEDS RECORDED SUBDIVISION PLAT OR OTHER PUBLIC RECORDS.

DESIGN CERTIFICATION

THIS PLAN WAS PREPARED BY ME, AND IS CORRECT TO THE BEST OF MY KNOWLEDGE AND BELIEF.
Richard P. Gilles, P.E. PS#5244
NAME SURVEYOR REGISTRATION NO.

CHECK LIST

DIMENSIONS	WATER MAIN SIZE LOCATION
BEARINGS	SAN SEWER SIZE % GR LOC
TIE TO NEAREST STREET	SAN MM CAST ELEV. INVELEV
SUBLOT NO. PARCEL NO.	SAN CONN. SIZE LOC. DEPTH
SURROUNDING OWNERS	STORM SEWER SIZE % GR LOC
BLOG DIMENSIONS FIN GR	STORM MM CAST ELEV. INVELEV
BLOG TIES FLR GRADES	PAVT TYPE GRADE CURBS
APRON TYPE WIDTH THICKNESS	GAS LINE LOC. SIZE PRESSURE
SIDEWALK TYPE WIDTH THICKNESS	SEPTIC TANK SIZE LOC
CULVERT TYPE DIA. LENGTH	WELL LOCATION

REVISIONS			PLAN PREPARED BY:		
NO.	DATE	BY	DEBEVEC. SALO & ASSOC., INC.	NAME	
1			130 EAST JACKSON ST. PAINESVILLE	ADDRESS	
2					
3			DRAWN BY: V.C.B.	SCALE: 1"=30'	PHONE NO.
4			CHK'D: RJB	DATE: 6/13/73	DRAWING NO.
5					3089-25

Grading Plan Approved
as shown and/or noted
THOMAS P. GILLES, P.E.
Lake County Engineer

By: JWK Date: 20 July 73