

zoning Permit # 2467


issued 4-23-73

H E Wood Const Co


Grading Plan Approved
as shown and/or noted
THOMAS P. GILLES, P.E.
Lake County Engineer.

By JWK Date 23 April 73

S/L 23 & 24 - HERMITAGE ROAD - CONCORD TOWNSHIP
COUNTY OF LAKE, OHIO

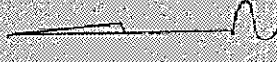NORTH 

SCALE 1" = 50'

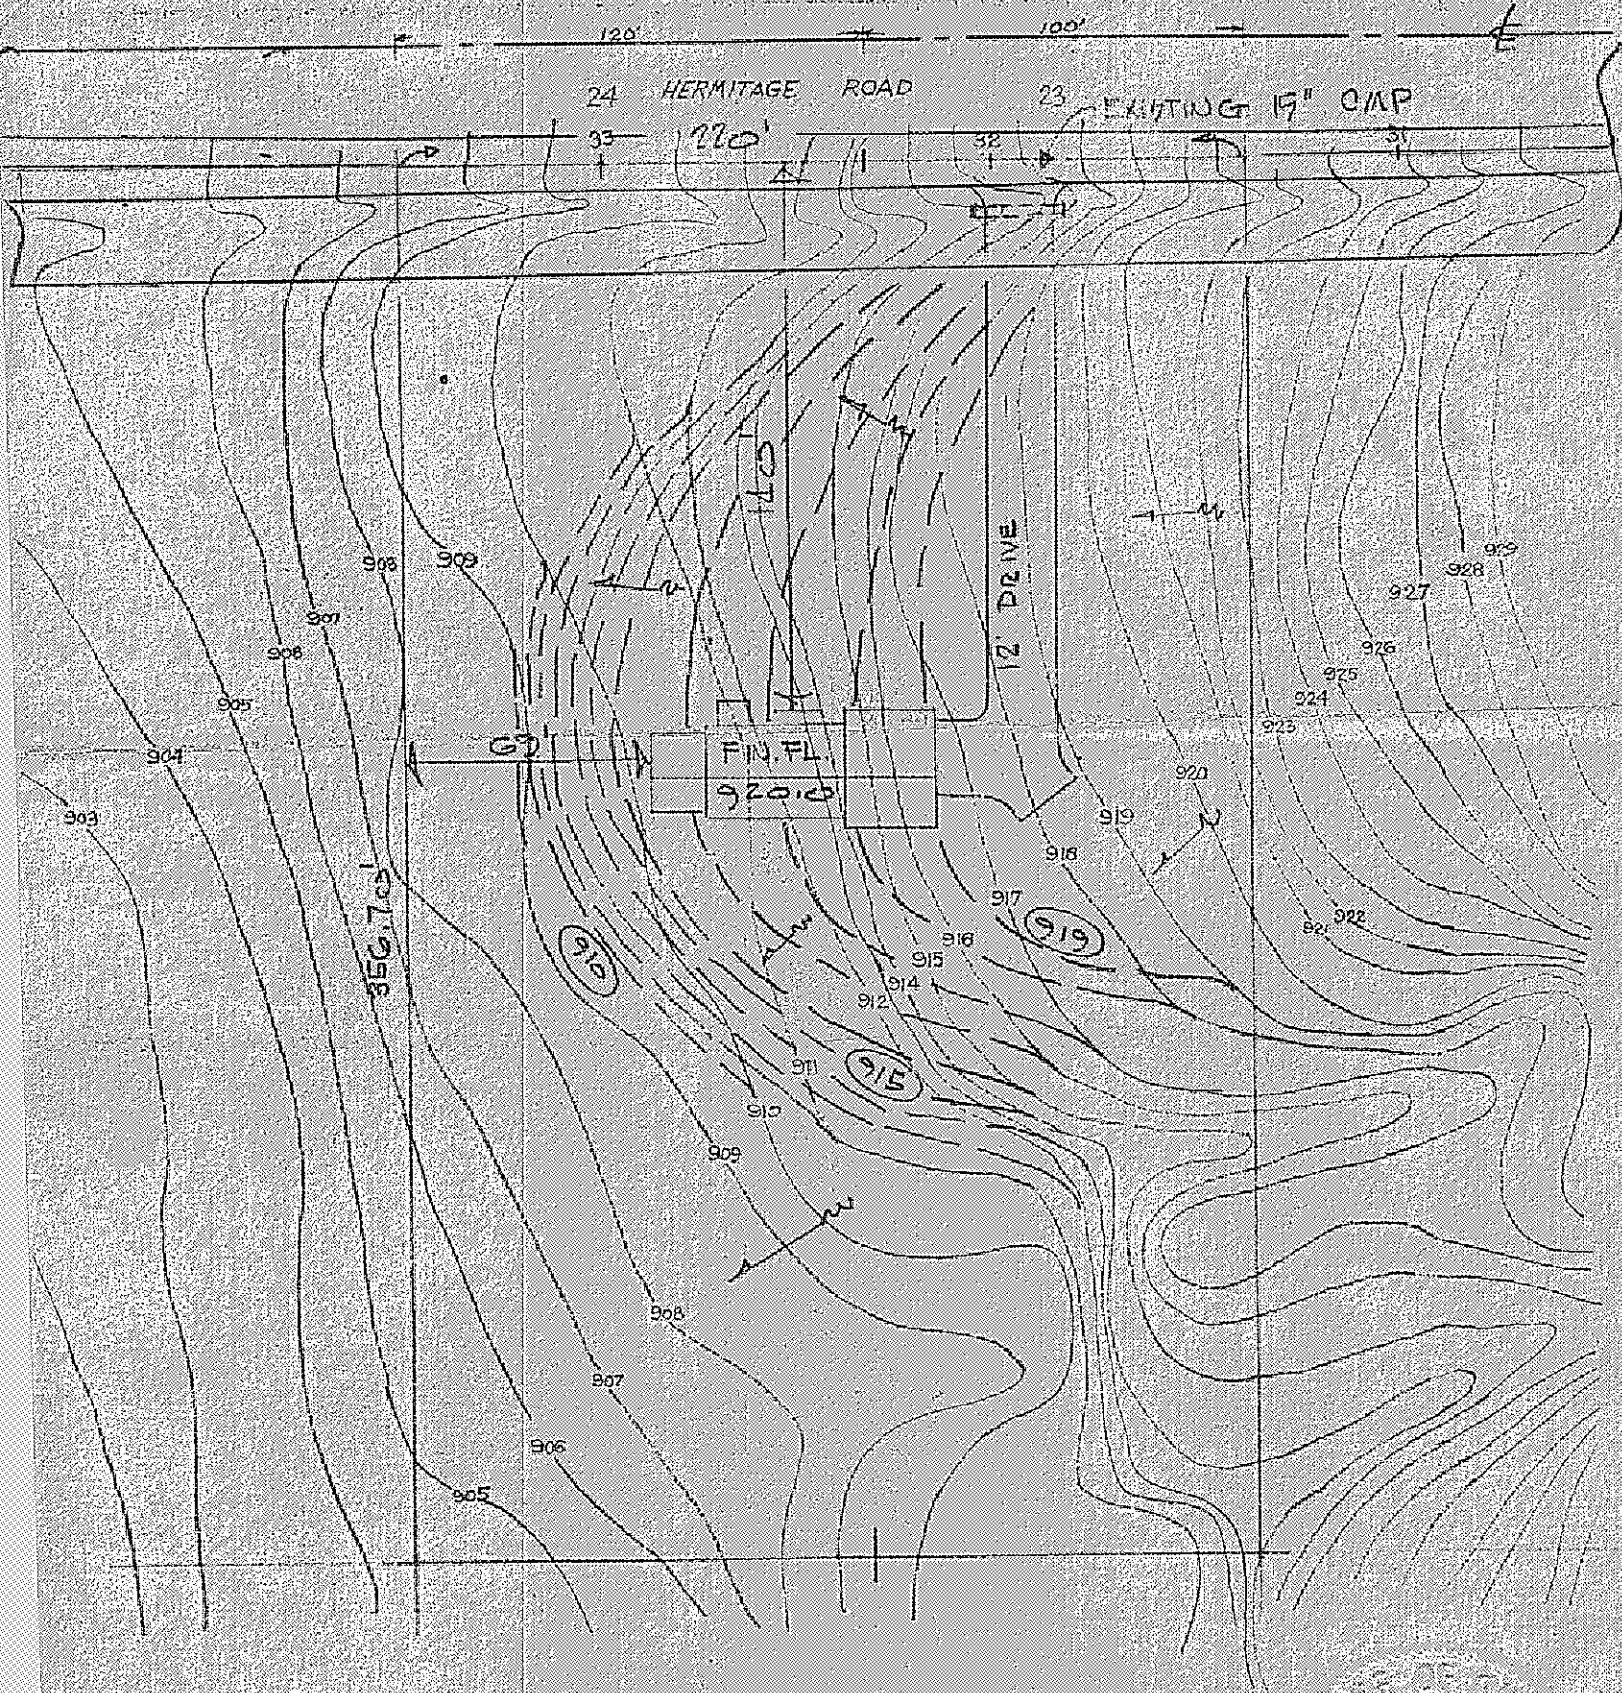

PLOT PLAN for
O.E. WOOD CONST CO
APRIL - 1973 J.R. GILLES, P.E.