


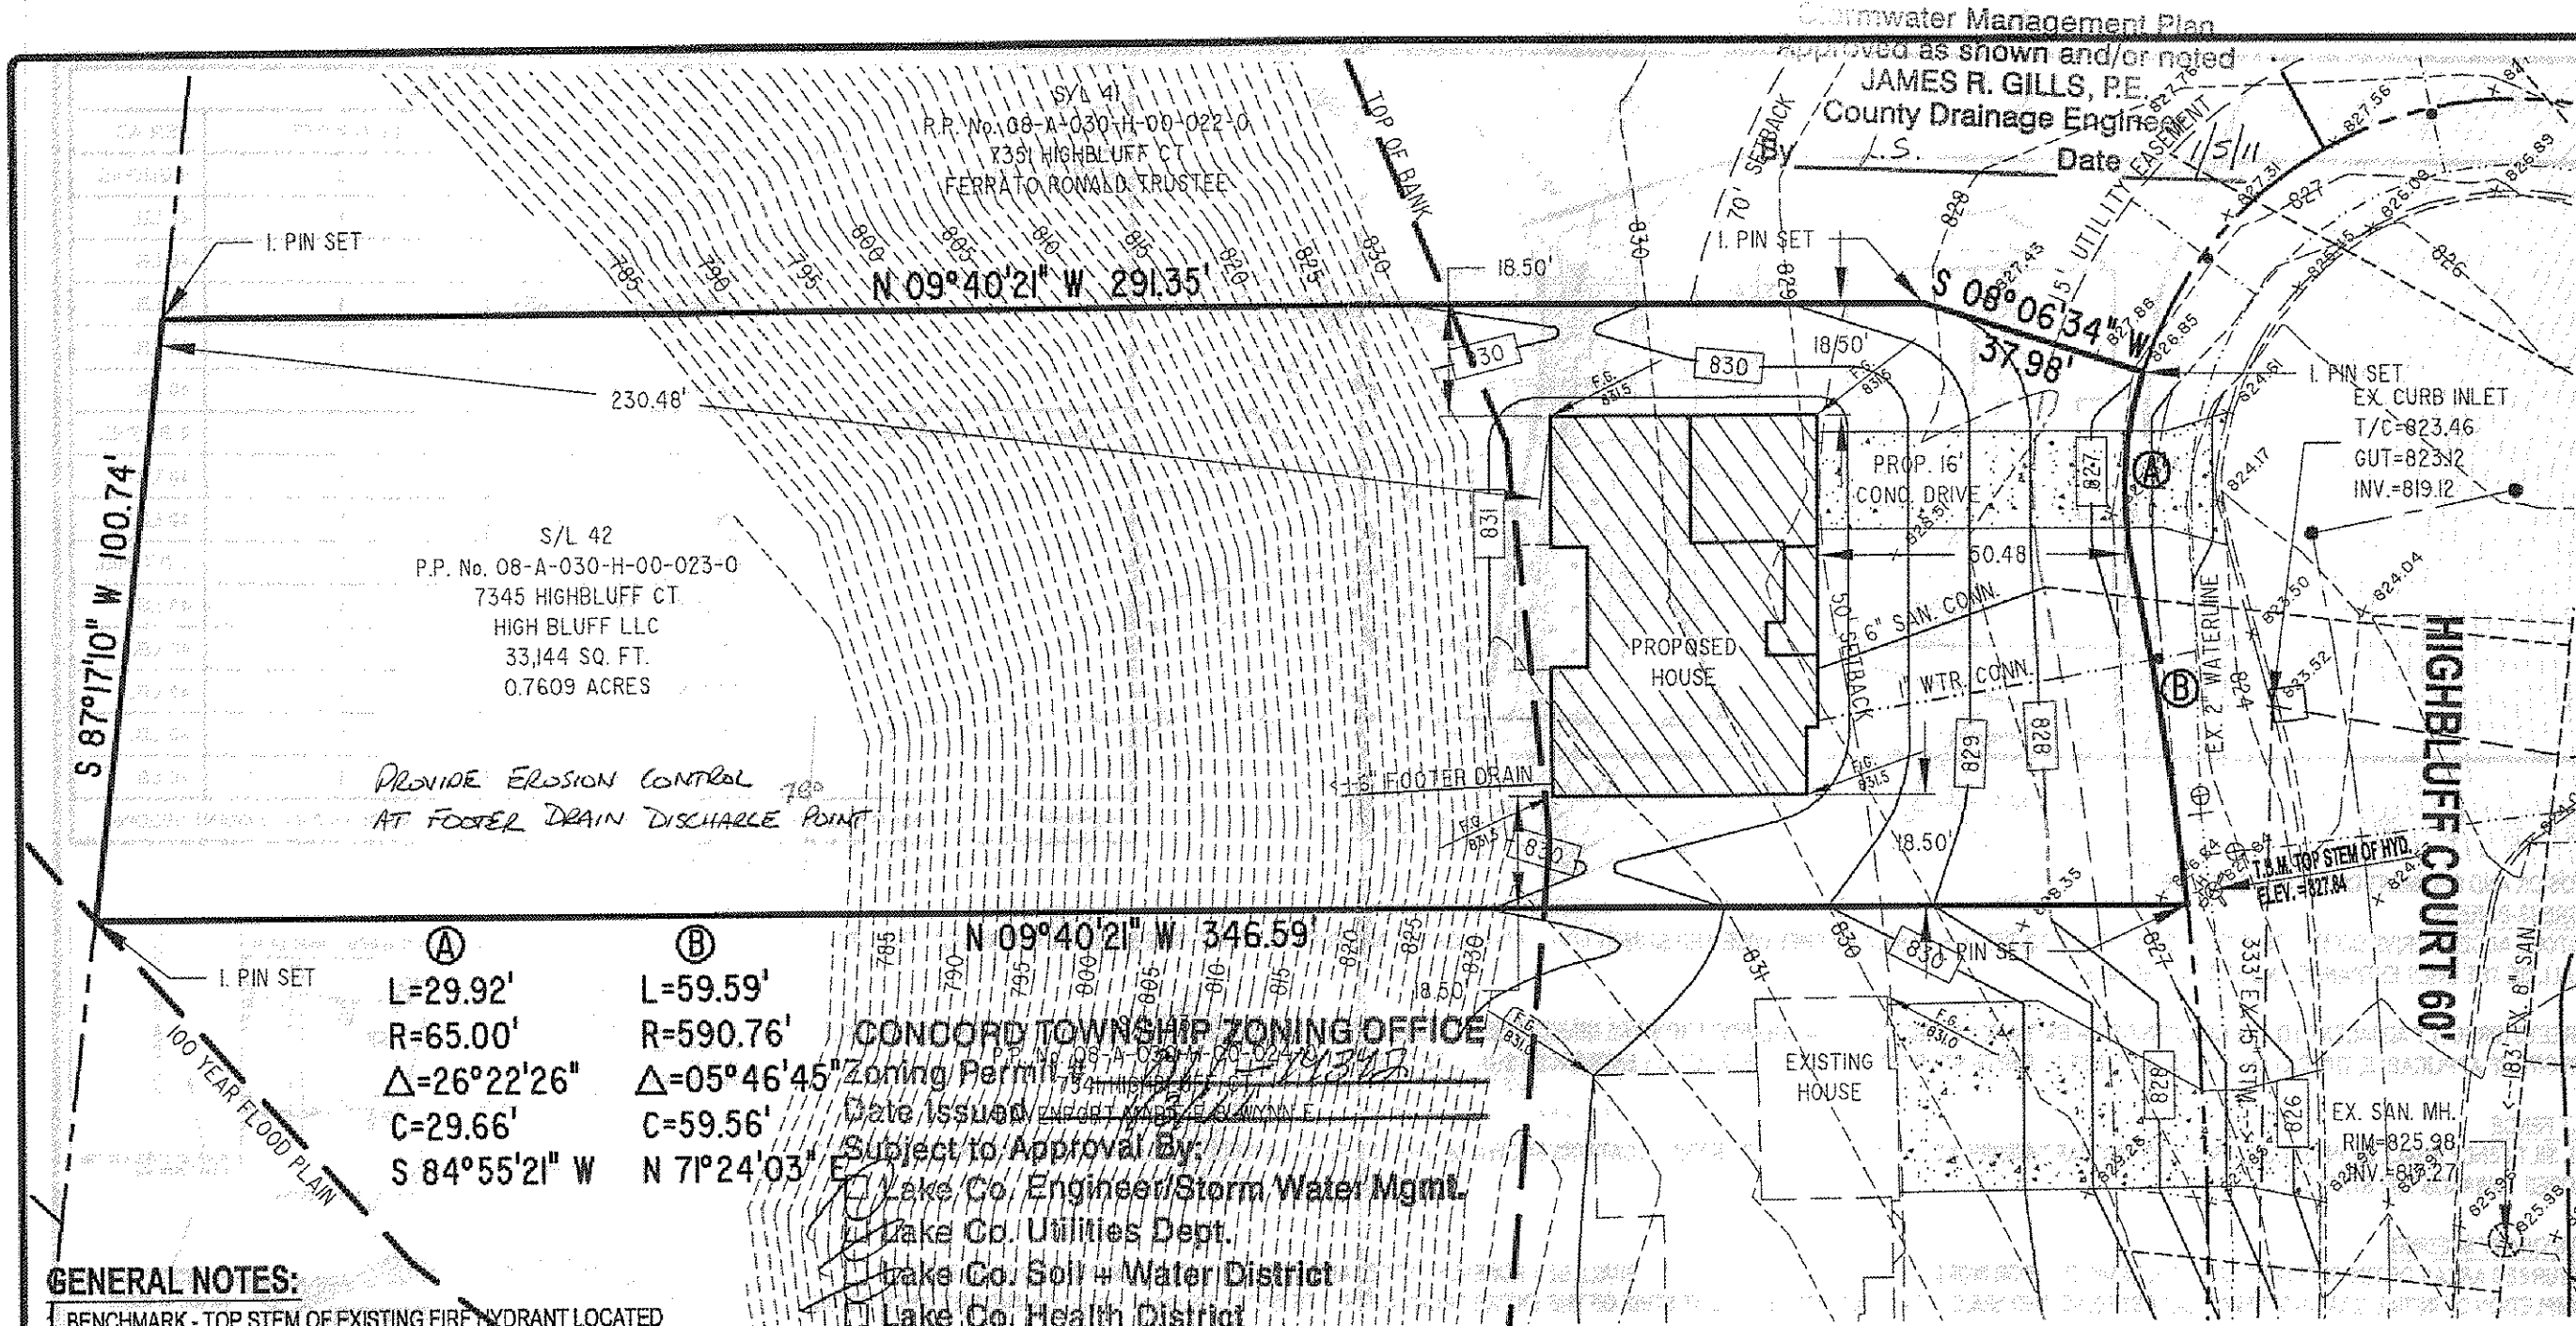

GENERAL NOTES:

- BENCHMARK - TOP STEM OF EXISTING FIRE HYDRANT LOCATED IN FRONT SUBLOT 42, ELEVATION = 827.84.
- DRIVEWAY APRON TO BE 6" THICK CONCRETE.
- ALL DOWNSPOUTS TO BE OUTLETED TO SPLASH BLOCKS.
- CONTRACTOR RESPONSIBLE FOR CONTACTING THE OHIO UTILITY PROTECTION SERVICE (1.800.362.2764) AND ALL UTILITY COMPANIES A MINIMUM OF 48 HOURS PRIOR TO CONSTRUCTION.
- THE LOCATION BOTH HORIZONTAL AND VERTICAL OF EXISTING UNDERGROUND UTILITIES SHOWN HEREON, HAVE BEEN OBTAINED BY A DILIGENT AND COMPREHENSIVE SEARCH OF AVAILABLE RECORDS. VERIFICATION BY FIELD OBSERVATION HAS BEEN CONDUCTED WHERE PRACTICAL, HOWEVER, BARRINGTON CONSULTING GROUP, INC. DOES NOT GUARANTEE THE COMPLETENESS, NOR ACCURACY THEREOF.
- CONTRACTOR SHALL VERIFY ELEVATIONS OF LATERAL INVERTS IN THE FIELD PRIOR TO FOUNDATION EXCAVATION.
- SEE SHEET 2 FOR EROSION AND SEDIMENT-CONTROL PLAN
- SEE SHEET 2 FOR SEEDING INFORMATION


CERTIFICATION:

"I THE UNDERSIGNED HEREBY CERTIFIES THAT THIS TOPOGRAPHY INDICATED BY 1 FOOT CONTOURS AND ELEVATION SHOWN HEREON REPRESENTS AN ACTUAL SURVEY MADE BY ME ON THE 15th DAY OF OCTOBER, 2002 AND THE ELEVATIONS WERE TAKEN AT AN APPROPRIATE INTERVAL AND AS OF THAT DAY THEY EXISTED AS INDICATED HEREON.


"I HEREBY CERTIFY THAT THIS PLAN WAS PREPARED BY ME AND IS CORRECT TO THE BEST OF MY KNOWLEDGE AND BELIEF"

DAVID W. NOVAK, P.S. No. 7507
01/03/2011
CERT-1.DWG

Barrington
CONSULTING GROUP, INC.

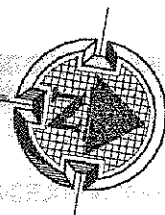


GRAPHIC SCALE

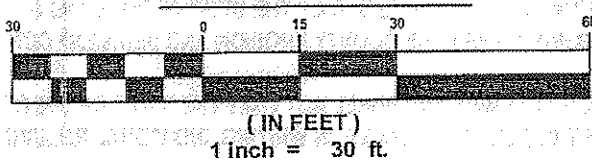

REVISIONS	BY

Barrington
CONSULTING GROUP, INC.
9114 TYLER BLVD., MENTOR, OHIO 44060
PHONE 440.205.1260 FAX 440.205.1262
www.BarringtonCGI.com

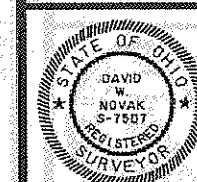

SITE PLAN
7345 HIGHBLUFF CT., CONCORD TWP., OHIO 44077
S/L 42 HERMITAGE BLUFFS SUBDIVISION No. 2 VOL. 42 PG. 13
EYE-WILL DEVELOPMENT

DRAWN WSO
CHECKED DWN
DATE JAN. 3, 2011
SCALE 1" = 30'
JOB NO. 0211-042
SHEET 1/2
OF SHEETS

02111-042