

DON SPALLER
1651 MENTOR AVE.
MENTOR, OHIO


BEING PART OF SL 45 & PART OF SUBLOT No 4C
IN THE HOBBY HORSE FARMS SUBDIVISION IN
CONCORD TOWNSHIP, OHIO.

WM. R. GRAY ASSOC. INC.
ENGINEERS & SURVEYORS
7547 MENTOR AVE.
MENTOR, OHIO

DATE: JUNE 4, 1973 SCALE: 1"=30'


I HEREBY CERTIFY THAT THIS PLAT IS
CORRECT TO THE BEST OF MY KNOWLEDGE.

BY: Ronald O. Brewster
DONALD O. BREWSTER REG. SURV. #5273

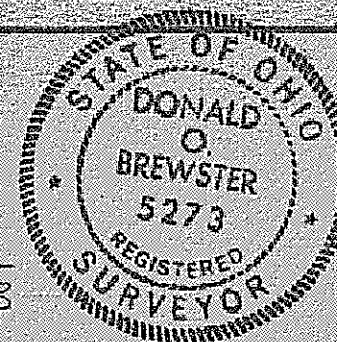

Joining Permit # 2498

period 6-14-73

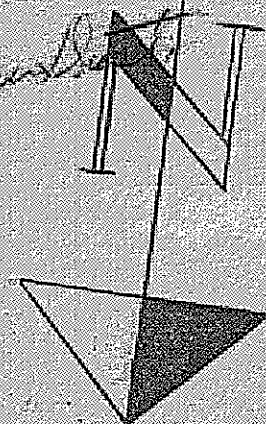

FIRE HYDRANT
EL. TOP 107.31

Grading Plan Approved
as shown and/or noted
THOMAS P. GILLES, P.E.
Lake County Engineer

By JWR Date _____

(T.M.) Saw. M. H.
Rim 100.00 (153)

