

SITE PLAN

LOCCED TOWNSHIP, LAKE COUNTY, OHIO

for: WILSHIRE HOMES

LAKE COUNTY SUPERVISION
 SUBDIVISION NO. 17
 PROJECT NO. 17
 SHEET NO. 17
 DATE 1-9-91
 DRAWN BY J. GILLES
 CHECKED BY J. GILLES
 APPROVED BY J. GILLES

LEGEND

STANDARD
 STORM
 INLET OR CATCH BASIN
 HYDRAULIC
 EXISTING CONTOURS
 PROPOSED CONTOURS
 EXIST. ELEV.
 PROPOSED ELEV.
 WATER VALVE (GAS)
 WATER METER (GAS)
 AS BUILT ELEVATION
 INDICATES
 DIRECTION OF
 SURFACE DRAINAGE

REMARKS


ALL SURVEY DATA SHOWN WAS OBTAINED FROM JONES, RECORDED
 SURVEYOR PLAT OR OTHER PUBLIC RECORDS
 LOCATIONS AS SHOWN OF ADJACENT WELLS AND SEPTIC TANKS OBTAINED FROM
 LAKE COUNTY HEALTH DEPARTMENT

DESIGN CERTIFICATION

THIS PLAN WAS PREPARED BY ME, AND IS CORRECT
 TO THE BEST OF MY KNOWLEDGE AND BELIEF
 NAME: J. GILLES
 SURVEYOR REGISTRATION NO. 176343

CHECK LIST

NO. OF BEDROOMS
 BATHS
 STORM
 INLET OR CATCH BASIN
 HYDRAULIC
 EXISTING CONTOURS
 PROPOSED CONTOURS
 EXIST. ELEV.
 PROPOSED ELEV.
 WATER VALVE (GAS)
 WATER METER (GAS)
 AS BUILT ELEVATION
 INDICATES
 DIRECTION OF
 SURFACE DRAINAGE

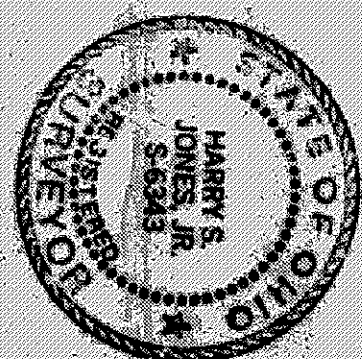

REVISIONS
 NO. DATE BY
 1
 2
 3
 4
 5

PLAN PREPARED BY:
 BABCOCK & JONES & ASSOCIATES, INC.
 PAINESVILLE, OHIO

DRAWN BY: J. GILLES
 SCALE: 1" = 20'
 DATE: 1-9-91
 CHECKED BY: J. GILLES
 APPROVED BY: J. GILLES

"AS BUILT" CERTIFICATION

I, HEREBY CERTIFY THAT THE CIRCLED GRADES ARE EXISTING
 FINISH GRADES CHECKED IN THE FIELD ON 1-9-91
 AND ARE CORRECT TO THE BEST OF MY KNOWLEDGE AND BELIEF

REGISTERED SURVEYOR REG. NO. 176343

T.B.M. SAN. M.H. 12+13 R.I.M. ELEV. = 924.34

#6696

ISSUED 2-21-91

ZONING PERMIT

Grading Plan Approved
 as shown and/or noted
 THOMAS P. GILLES, P.E.
 Lake County Engineer
 Date 2/20/91

Now & Mariano

HANSON PLACE - 60'

