


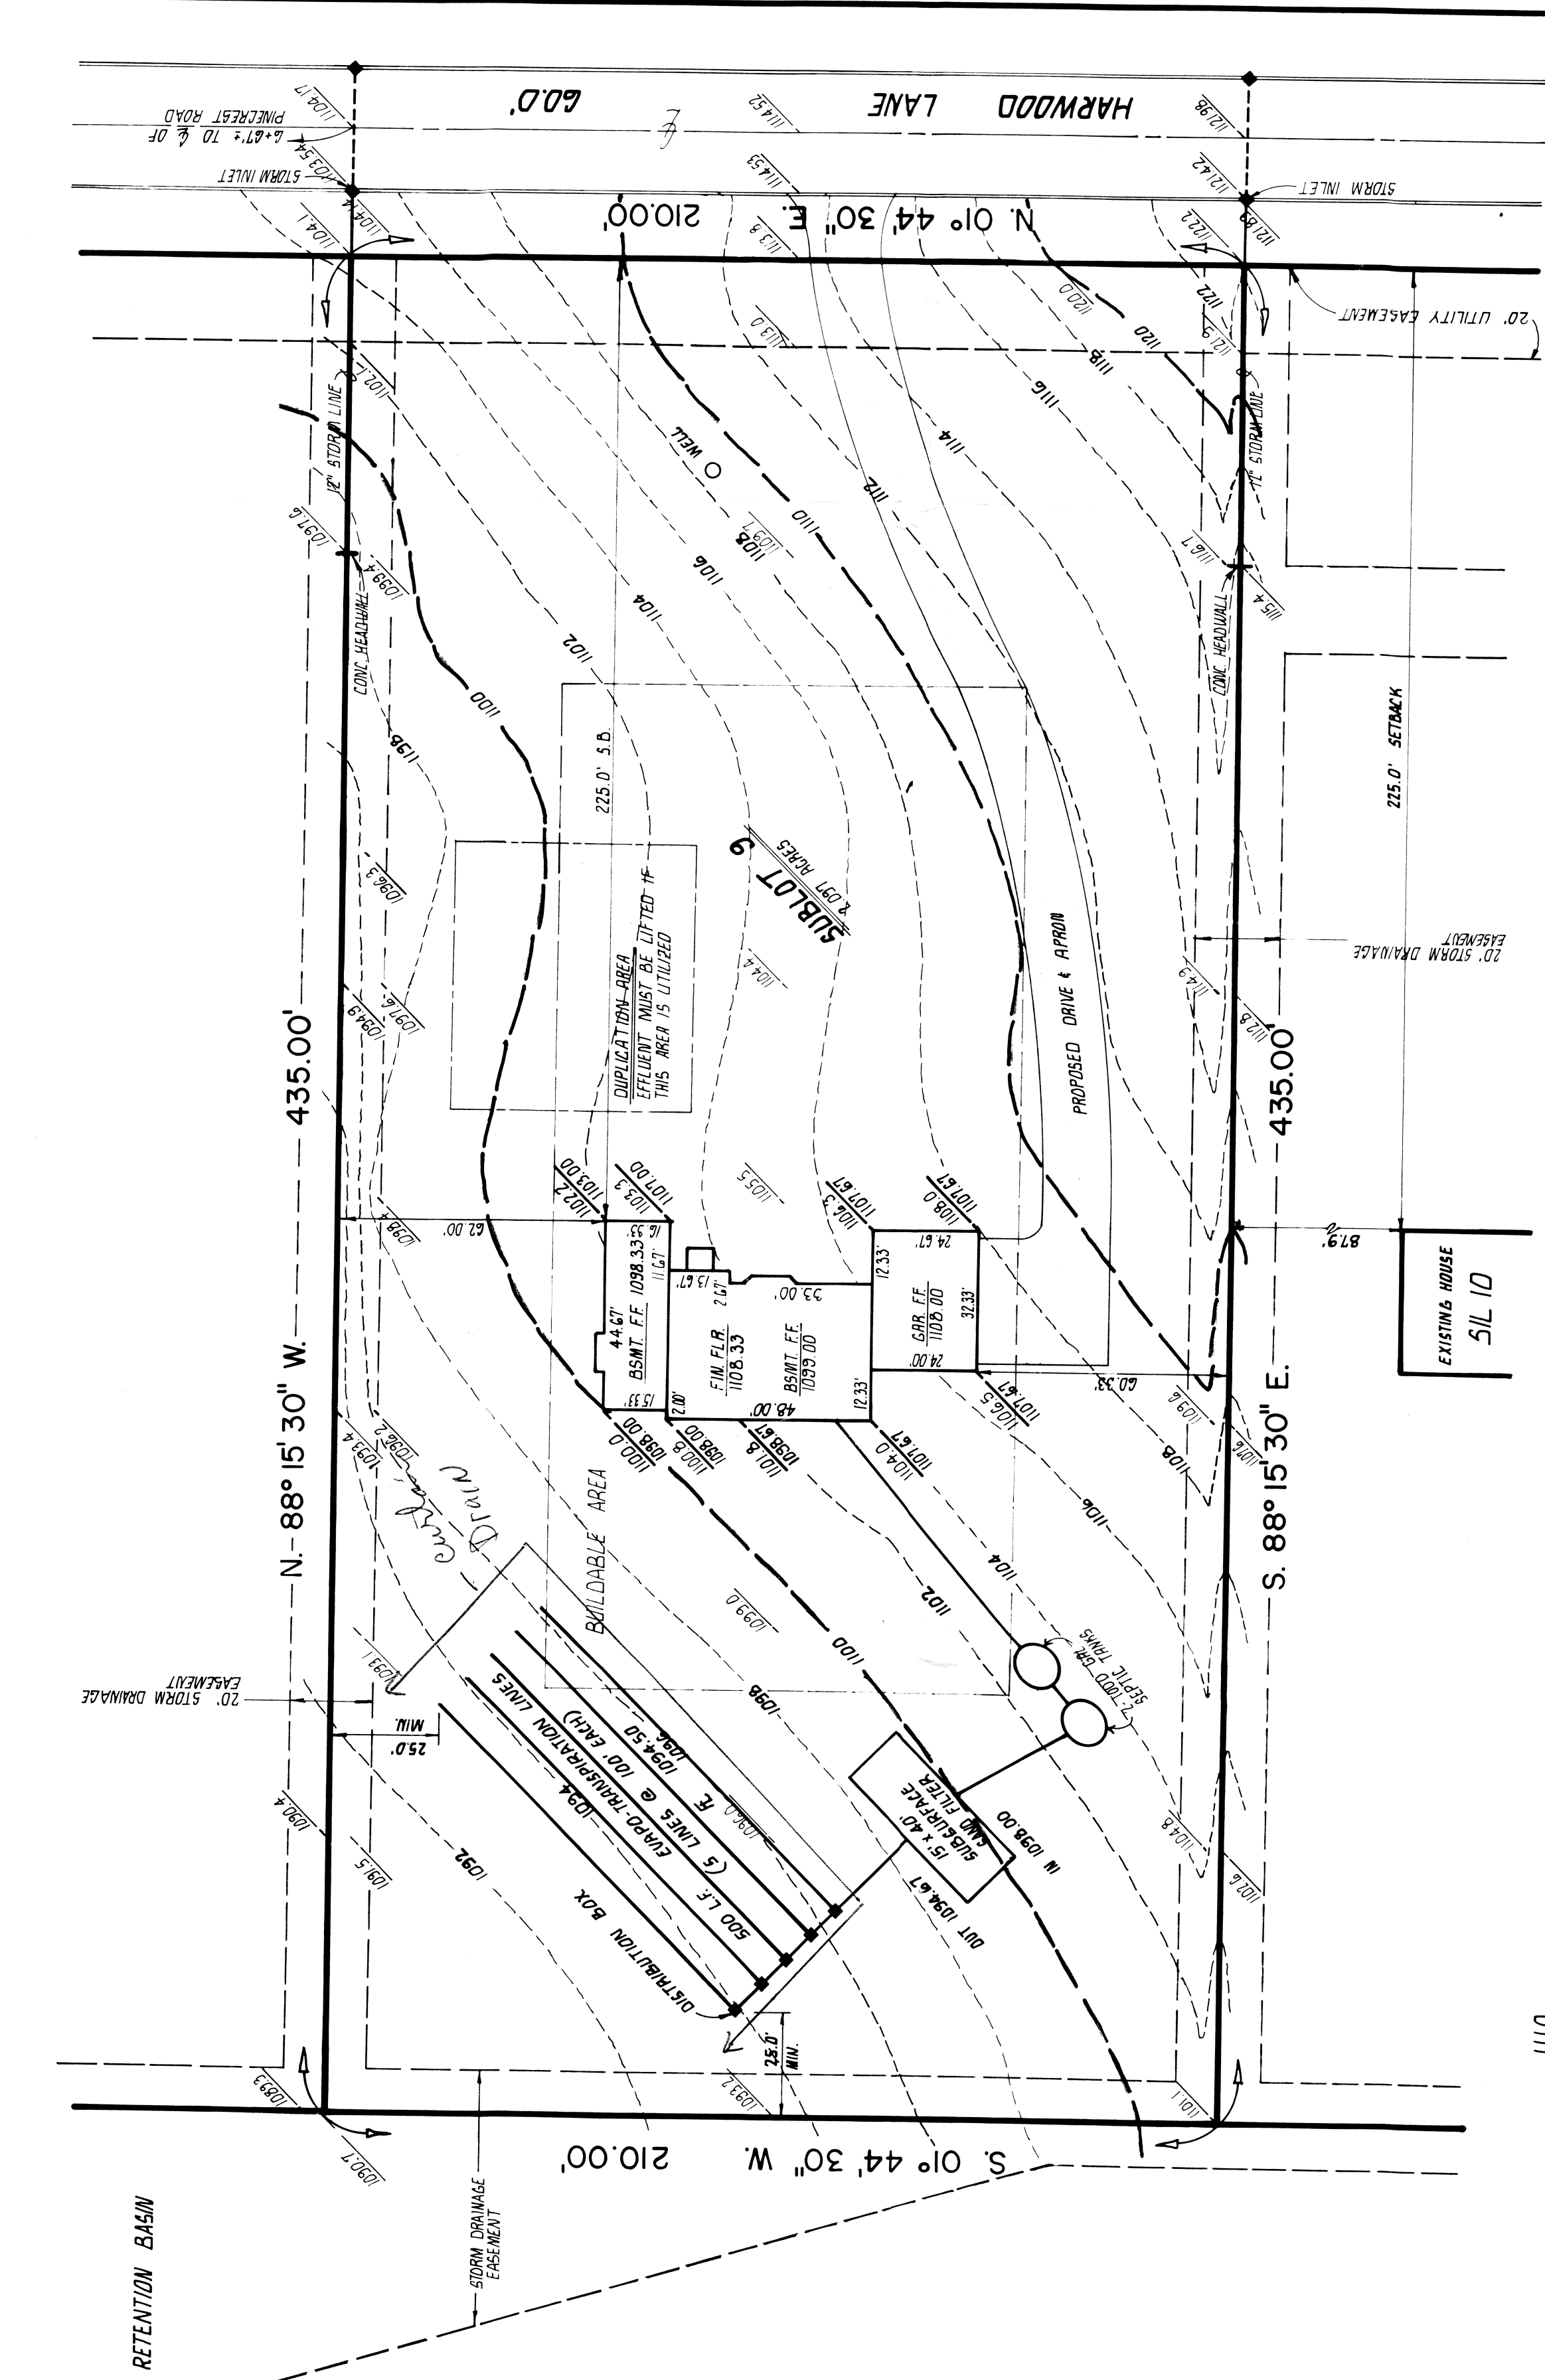

LOW YIELD WATER
FIXTURES REQUIRED
ON ALL:
Shower Head
Toilet

Reviewed and Accepted

Lake County General Health District
Health Department

Date 11-6-86

JOEL LUCKE, R.N.
Health Department

Dorinda B. Norris
EDD

Tens. L. Marano

By *[Signature]* Date 11.7.86

CT COLPETZER-THOMAS, INC.
AN ENGINEERING GROUP

WILLOUGHBY • MENTOR • NORTH CANTON • STEUBENVILLE • LORAIN

CERTIFICATION

"THIS PLAT WAS PREPARED BY ME
AND IS CORRECT TO THE BEST OF
MY KNOWLEDGE AND BELIEF"

L. B. B. B.

REG. SURVEYOR NC PS # 5244

DATE: <u>11-6-86</u>
DRAWN BY: <u>T.K.W.</u>
CHECKED BY: _____
APPROVED BY: _____
F.B. No. <u>502</u> PG. <u>109</u>

*SITE PLAN FOR
SCOTT ANDREWS
BEING OF SUBLOT NO. 9 OF HARWOOD II SUBD.
CONCORD TOWNSHIP-LAKE COUNTY- OHIO*