

Erosion and Sediment Control Schedule

Ingress-Egress
A stone access drive complete with under lying geo-textile fabric (20 feet wide and 50 feet long) for ingress and egress at the site shall be installed. This drive shall be the only entrance and exit to the site.

Silt Fence
All silt fence shall be installed prior to any earthwork activities at the site in the locations shown on the site plan as well as along the front of any lot that slopes towards the street.

Temporary Seeding
Disturbed areas of the site that are to remain idle for more than thirty (30) days shall be properly seeded and straw mulched within seven (7) days of completion of initial grading. Temporary seeding and mulching of a thirty (30) foot strip of the entire front of the lot shall be maintained on the site once initial grading is complete.

Stabilization of critical areas within fifty (50) feet of any stream or wetland shall be complete within two (2) days of the disturbance if the site is to remain inactive for longer than fourteen (14) days.

Mulching
Straw-mulch shall be applied at a rate of 1 bale per every ten (10) feet of curb, at a width of thirty (30) feet of the entire length of the lot. Wood chips may also be used but must be spread at a minimum depth of four inches over the thirty-foot width and must be accompanied by a properly installed silt fence.

Maintenance
Erosion and sediment controls shall be inspected every seven (7) days or within 24 hours of a 0.5" or greater rainfall event. Necessary repairs shall be made at this time.


Note:
All erosion and sediment control specifications, applications, and timetables are based on the descriptions and standards of the Ohio Department of Natural Resources "Rainwater and Land Development Manual" and can be found in the Lake County Erosion and Sediment Control Rules as adopted December 21, 1999.

The specified erosion and sediment control standards are the general guidelines and shall not limit the right of the county to impose, at any time, additional, more stringent requirements. Nor shall the standards limit the right of the county to waive, in writing, individual requirements.

Temporary Seeding Specifications


Seeding Dates	Species	Lb. / 1000sqft	Per Acre
March 1 to August 15	Oats	3	4 bushel
	Tall Fescue	1	40 lb.
	Annual Ryegrass	1	40 lb.
	Perennial Ryegrass	1	40 lb.
August 16 to November 1	Rye	1	2 bushel
	Tall Fescue	1	40 lb.
	Annual Ryegrass	1	40 lb.
	Wheat	1	40 lb.
November 1 to Spring Seeding	Tall Fescue	1	40 lb.
	Annual Ryegrass	1	40 lb.
	Perennial Ryegrass	1	40 lb.
	Tall Fescue	1	40 lb.

Note: other approved seed species may be substituted.

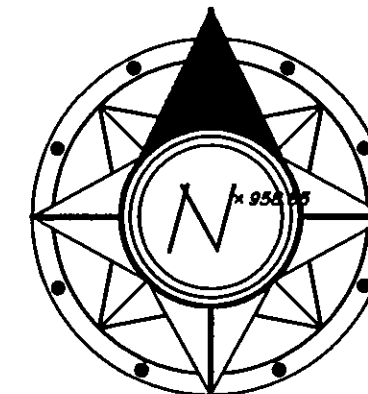

GRAPHIC SCALE

(IN FEET)
1 inch = 20 ft.

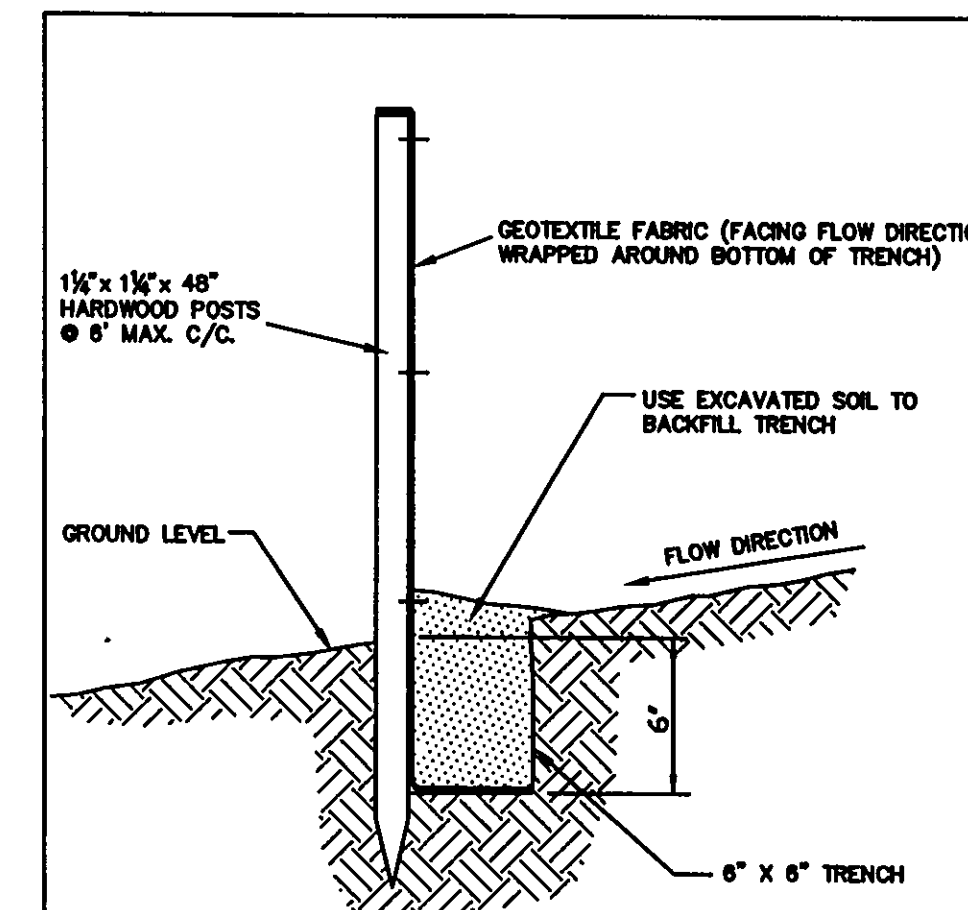

TYPICAL CROSS SECTION

SILT FENCE DETAIL

NO SCALE DECEMBER 18, 1997

ESTIMATED IMPERVIOUS AREA
HOUSE: 0.07 Ac.
DRIVE: 0.04 Ac.
TOTAL: 0.11 Ac.


House Summary
-3 Cor. Side Entry, Left Hand
With Basement
Str. Add. #286 Hemmingway Lane
-See Architect Plans For
Complete House Dimensions.
-Utility Connections Per Plan,
Contractor To Verify Location
And Depth Of All Laterals.

NOTE: HOUSE DOWNSPOUTS TO
BE TIED INTO EXISTING
STORM SYSTEM.

I, THE UNDERSIGNED, HEREBY CERTIFY THAT THIS TOPOGRAPHY, INDICATED BY 6", 1", OR 2" CONTOURS, AND ELEVATIONS SHOWN HEREON, REPRESENT AN ACTUAL FIELD SURVEY MADE BY ME ON THE 28th DAY OF JULY, 2005, AND THAT THE ELEVATIONS WERE TAKEN AT APPROPRIATE INTERVALS AND THAT AS OF THAT DATE, THEY EXISTED AS INDICATED HEREON.

Dustin R. Keeney
Dustin R. Keeney, P.E. 65512

Site & Grade Hse., 8-4-05 G.S.V.

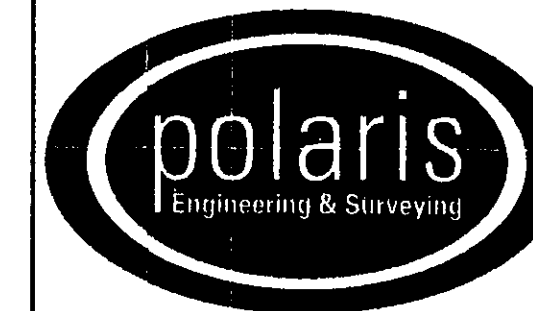

POLARIS ENGINEERING & SURVEYING, INC.
34600 CHARDON ROAD - SUITE D
WILLOUGHBY HILLS, OHIO 44094
(440) 944-4433 (440) 944-3722 (Fax)
www.polaris-es.com

DESIGN CERTIFICATION


THIS PLAN WAS PREPARED BY ME, AND IS CORRECT TO THE BEST OF MY KNOWLEDGE AND BELIEF.

Dustin R. Keeney
NAME

8/4/05
DATE

BENCHMARK:

B.M. = T.B.M Set On Top Of Hydrant
Located In Front Of S/L's. 27/28
Elevation 965.51

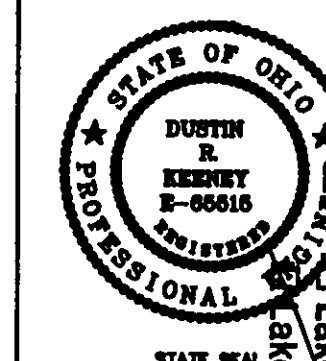

"AS-BUILT" CERTIFICATION

I HEREBY CERTIFY THAT THE CIRCLED INFORMATION IS EXISTING AS OBTAINED ON THE SITE AND IS CORRECT TO THE BEST OF MY KNOWLEDGE AND BELIEF.

NAME

DATE

SUBLOT 27

Holden Ridge Ph.2

(Formerly Wellesley Chase Subdivision No.2)
Concord Twp., Lake County, Ohio

CONTRACT No.

05750


DATE: 08/4/05

SCALE: HOR. 1"=20'
VERT.

FILENAME: sublot27-Rev.dwg

Stormwater Management Plan
Approved as shown and/or noted
AMES R. GILLS, P.E.
County Drainage Engineer
By *L.S.* Date 8/17/05

EROSION CONTROL TIMETABLE		September 22, 2003
ACCEPTABLE EROSION CONTROL TIMETABLE		
*** SEEDING INSTALLED FROM MAY 15 - AUG. 15 WILL REQUIRE ADDITIONAL MULCHING TO PROMOTE SEED GROWTH. MULCH MAY ALSO BE USED TO HOLD MOISTURE.		
SCHEDULE OF MAJOR CONSTRUCTION OPERATIONS		
*** PERMANENT SEEDING		
*** EROSION CONTROL MAINTENANCE		

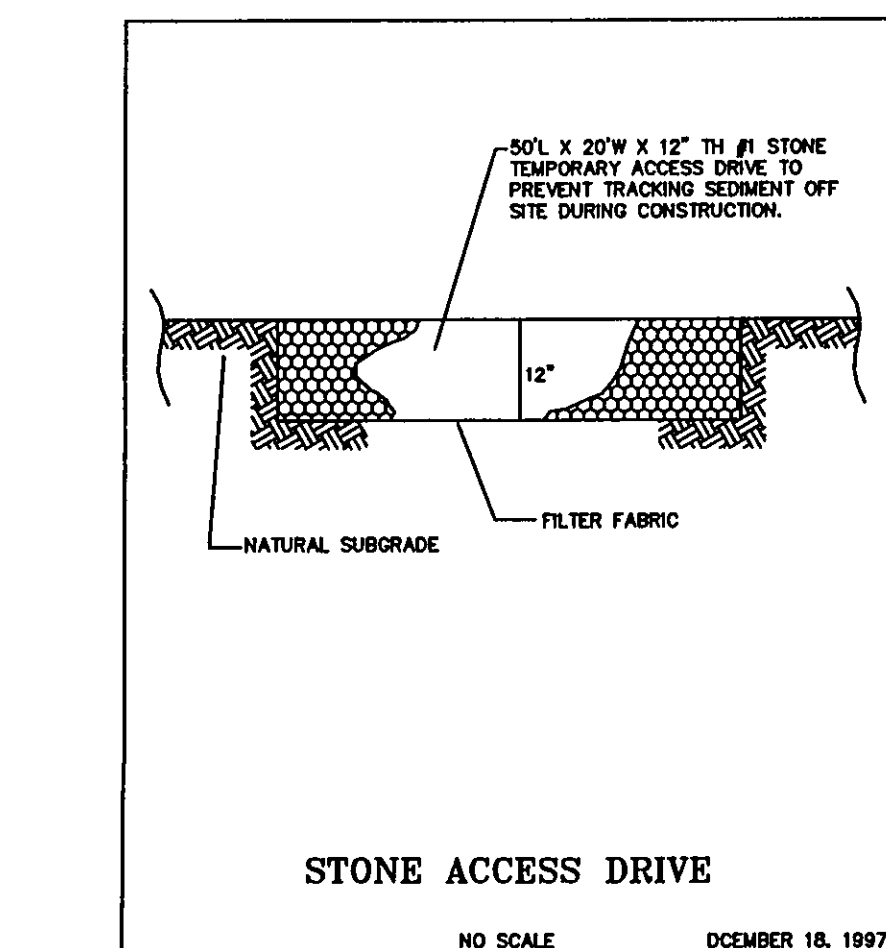


STONE ACCESS DRIVE

NO SCALE DECEMBER 18, 1997

2 WORKING DAYS
BEFORE YOU DIG
CALL TOLL FREE 800-362-2764
OHIO UTILITIES PROTECTION SERVICE

EXISTING UNDERGROUND UTILITIES NOTE:
THE SIZE AND LOCATION, BOTH HORIZONTAL AND VERTICAL OF THE UNDERGROUND UTILITIES SHOWN HEREON, HAVE BEEN OBTAINED BY A SEARCH OF AVAILABLE RECORDS. VERIFICATION BY FIELD OBSERVATION HAS BEEN CONDUCTED WHERE PRACTICAL. HOWEVER, POLARIS ENGINEERING & SURVEYING, INC. DOES NOT GUARANTEE THE COMPLETENESS NOR ACCURACY THEREOF.

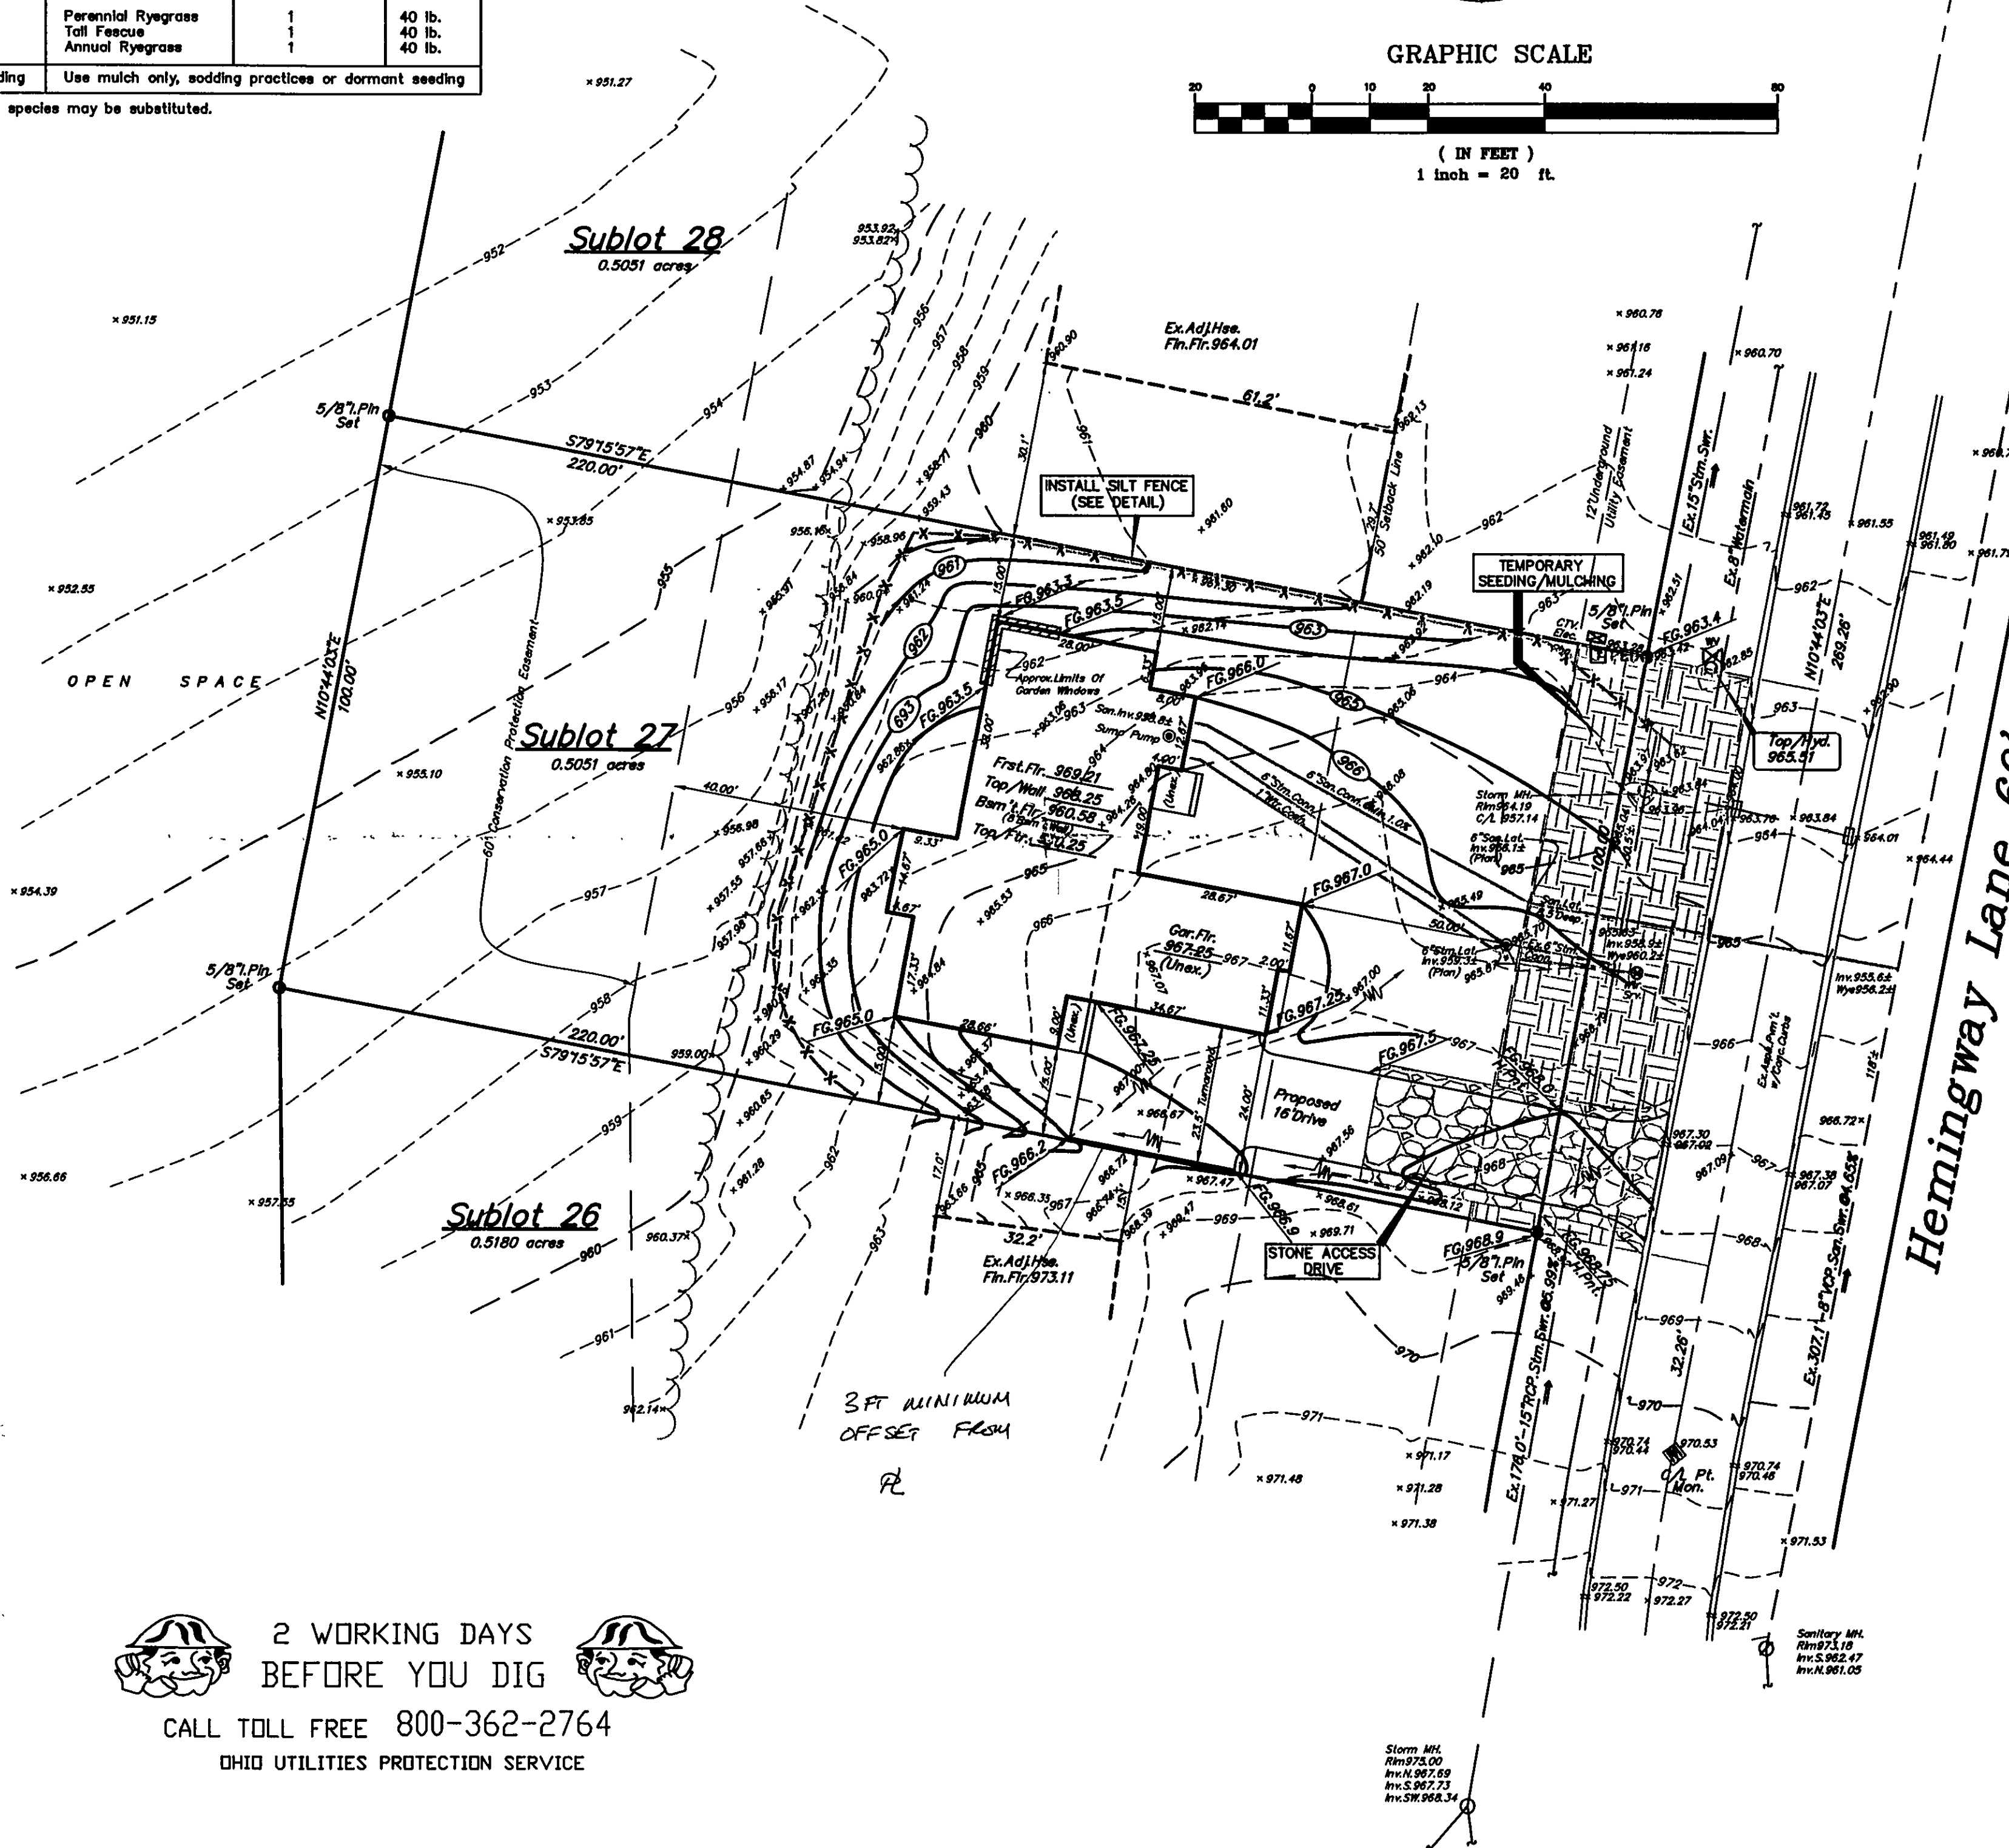

Prepared For:
B.R. Knez Construction, Inc.
3375 Blackmore Road
Perry Township, Ohio 44081
(440)259-0087
The Armstrong Residence

CONCORD TOWNSHIP ZONING OFFICE
Zoning Permit # 0726-12320
Date Issued 8/17/05
Subject to Approval By:
Lake Co. Engineer/Storm Water Mgmt.
Lake Co. Utilities Dept.
Lake Co. Soil & Water District
Lake Co. Health District
Lake Co. Building Dept.