



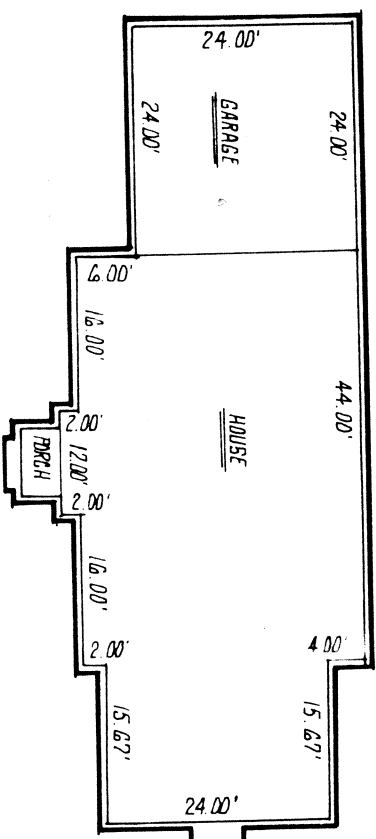

PARCEL NO. 3 HOUSE DETAIL

- PROPOSED -
100 YEAR FLOOD PLAIN ELEV. 786.25 FOR PARCEL NO. 3

MIKE & EVELYN SPISAK
VOL. 334 PG. 448

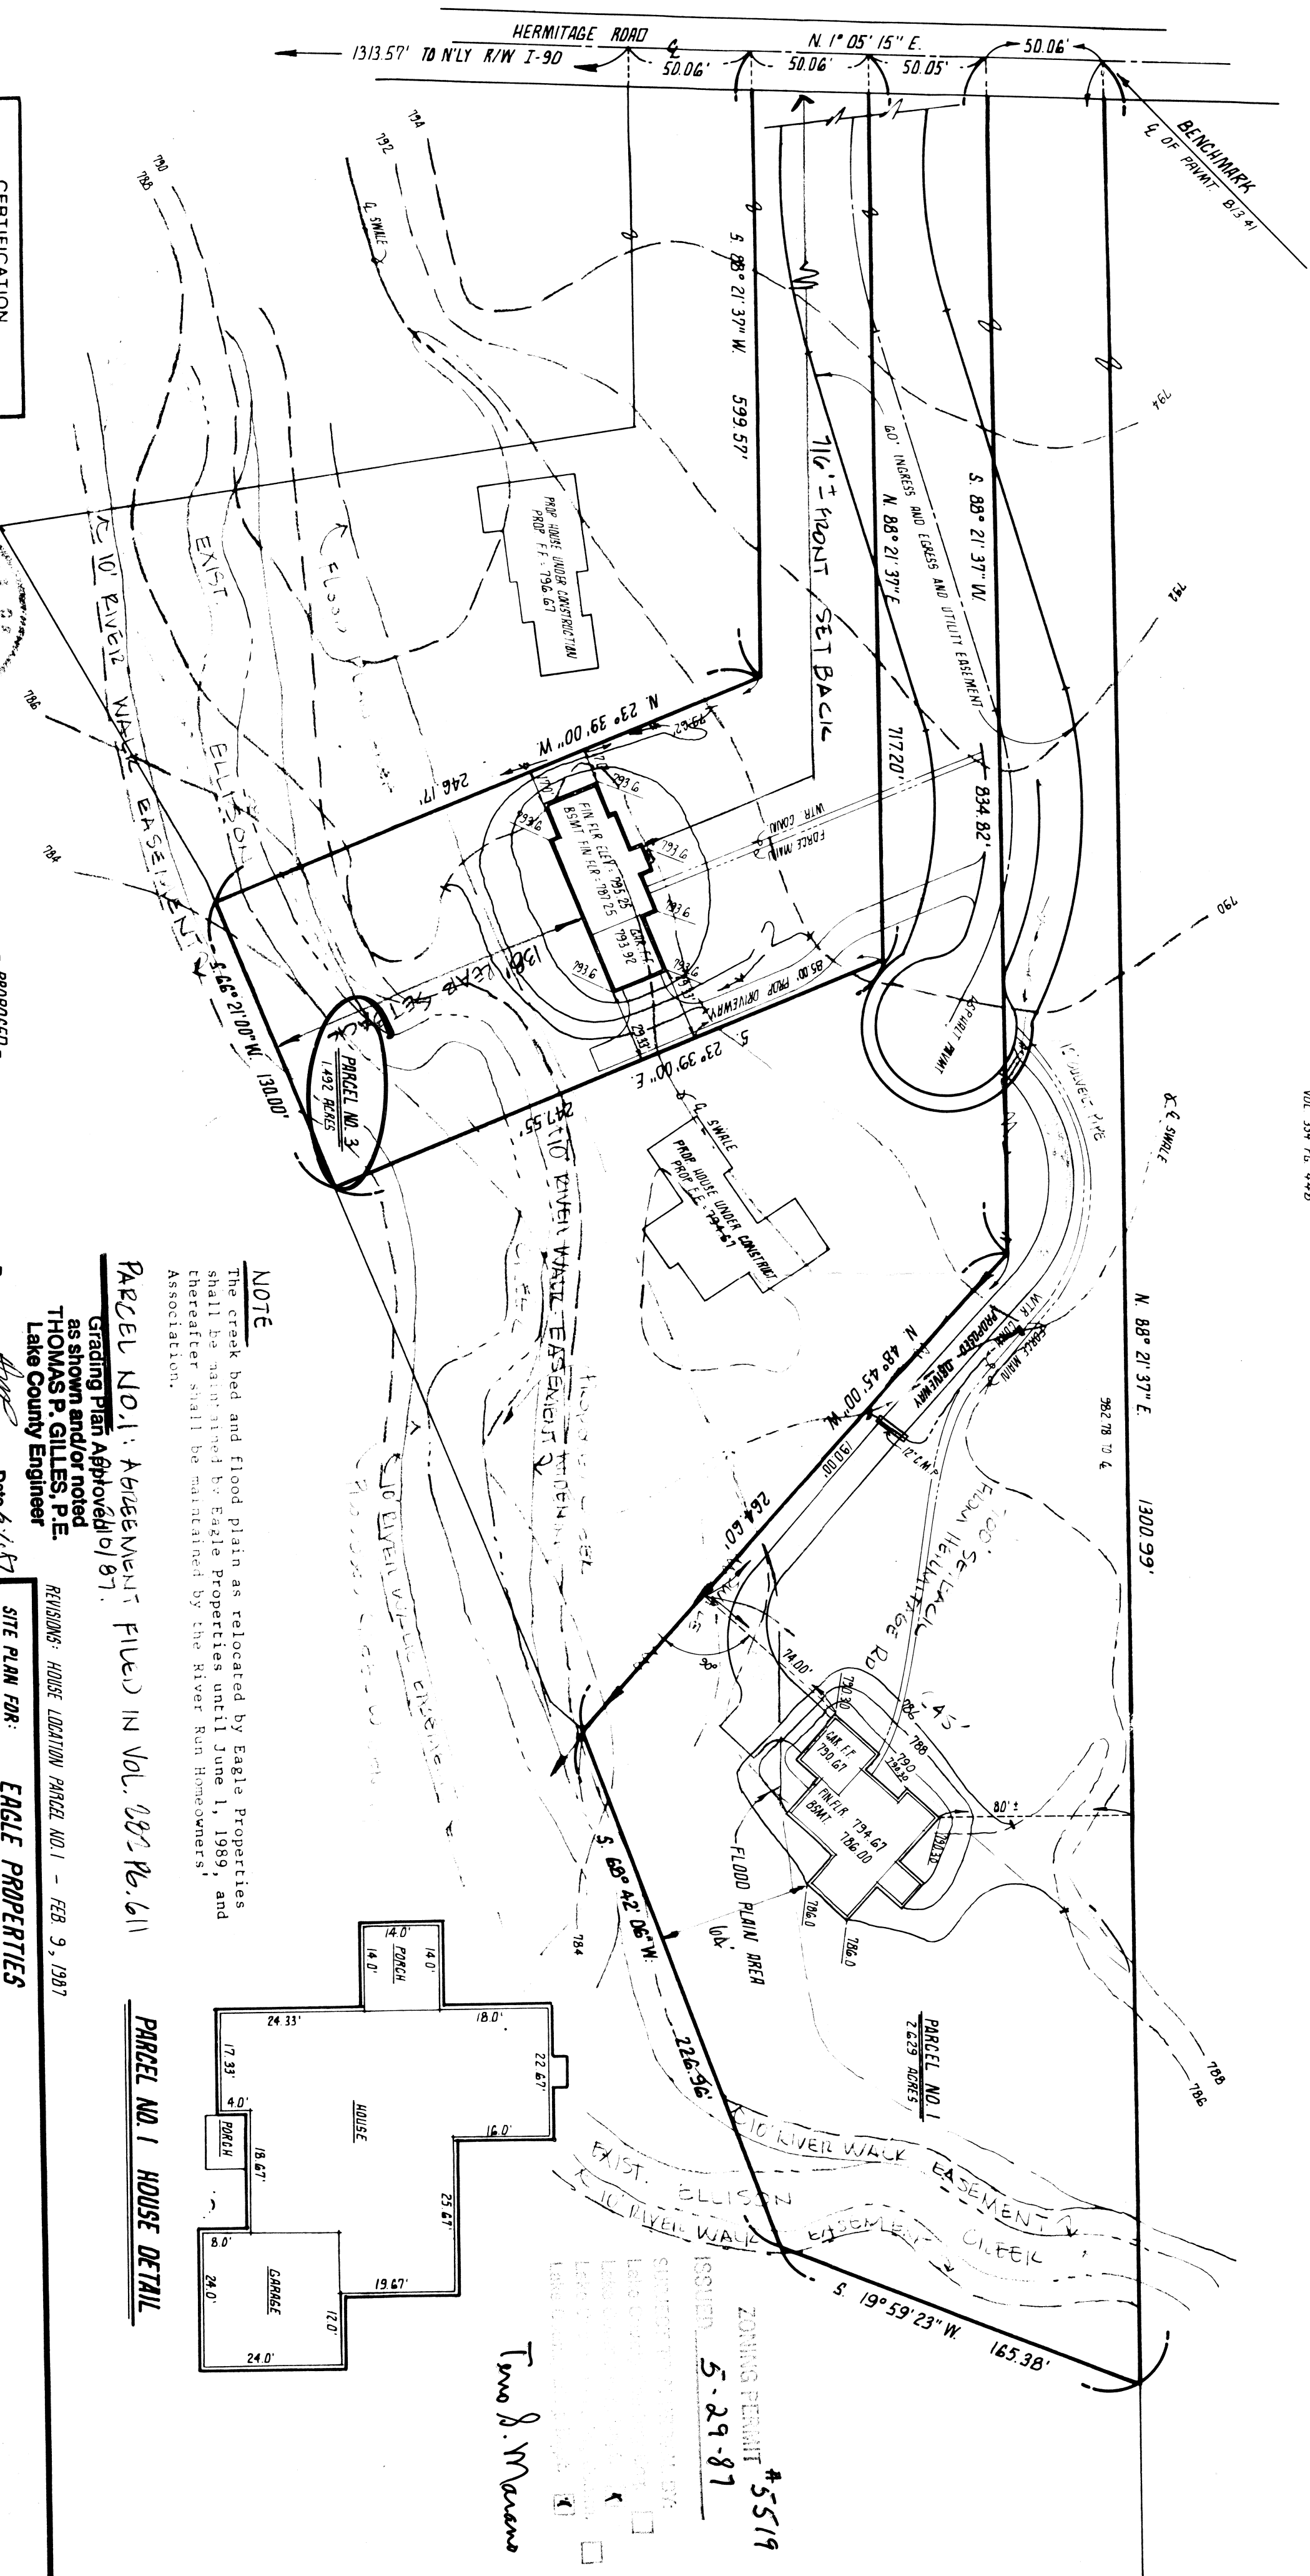

NORTH
SCALE 1" = 50'

CERTIFICATION

THIS PLAT WAS PREPARED BY ME,
AND IS CORRECT TO THE BEST OF
MY KNOWLEDGE AND BELIEF

[Signature]

REC. SURVEYOR NO. 5244

PARCEL NO. 3: AGREEMENT FILED IN VOL. 308
PAGE 648 LT. CO. OFFICIAL RECORDS.
FILED 5-18-87

PARCEL NO. 1: AGREEMENT FILED IN VOL. 282 P. 611
Grading Plan Approved 10/87.
as shown and/or noted
THOMAS P. GILLES, P.E.
Lake County Engineer

REVISIONS: HOUSE LOCATION PARCEL NO. 1 - FEB.

PARCEL NO. 1 HOUSE DETAIL

REVISIONS: HOUSE LOCATION PARCEL NO.1 - FEB. 9, 1987

SITE PLAN FOR:
EAGLE PROPERTIES

BEING PART OF LOT NO. 24 IN TRACT NO. 4 IN CONCORD TOWNSHIP, LAKE COUNTY, OHIO
BEING PARCEL NUMBER 1 (2.629 ACRES)



COLPETZER · WOODS
CONSULTANTS, INC.
MENTOR, OHIO 44060

SHEET	OF
ONE	ONE
CONTRACT NO.	
86-239	