


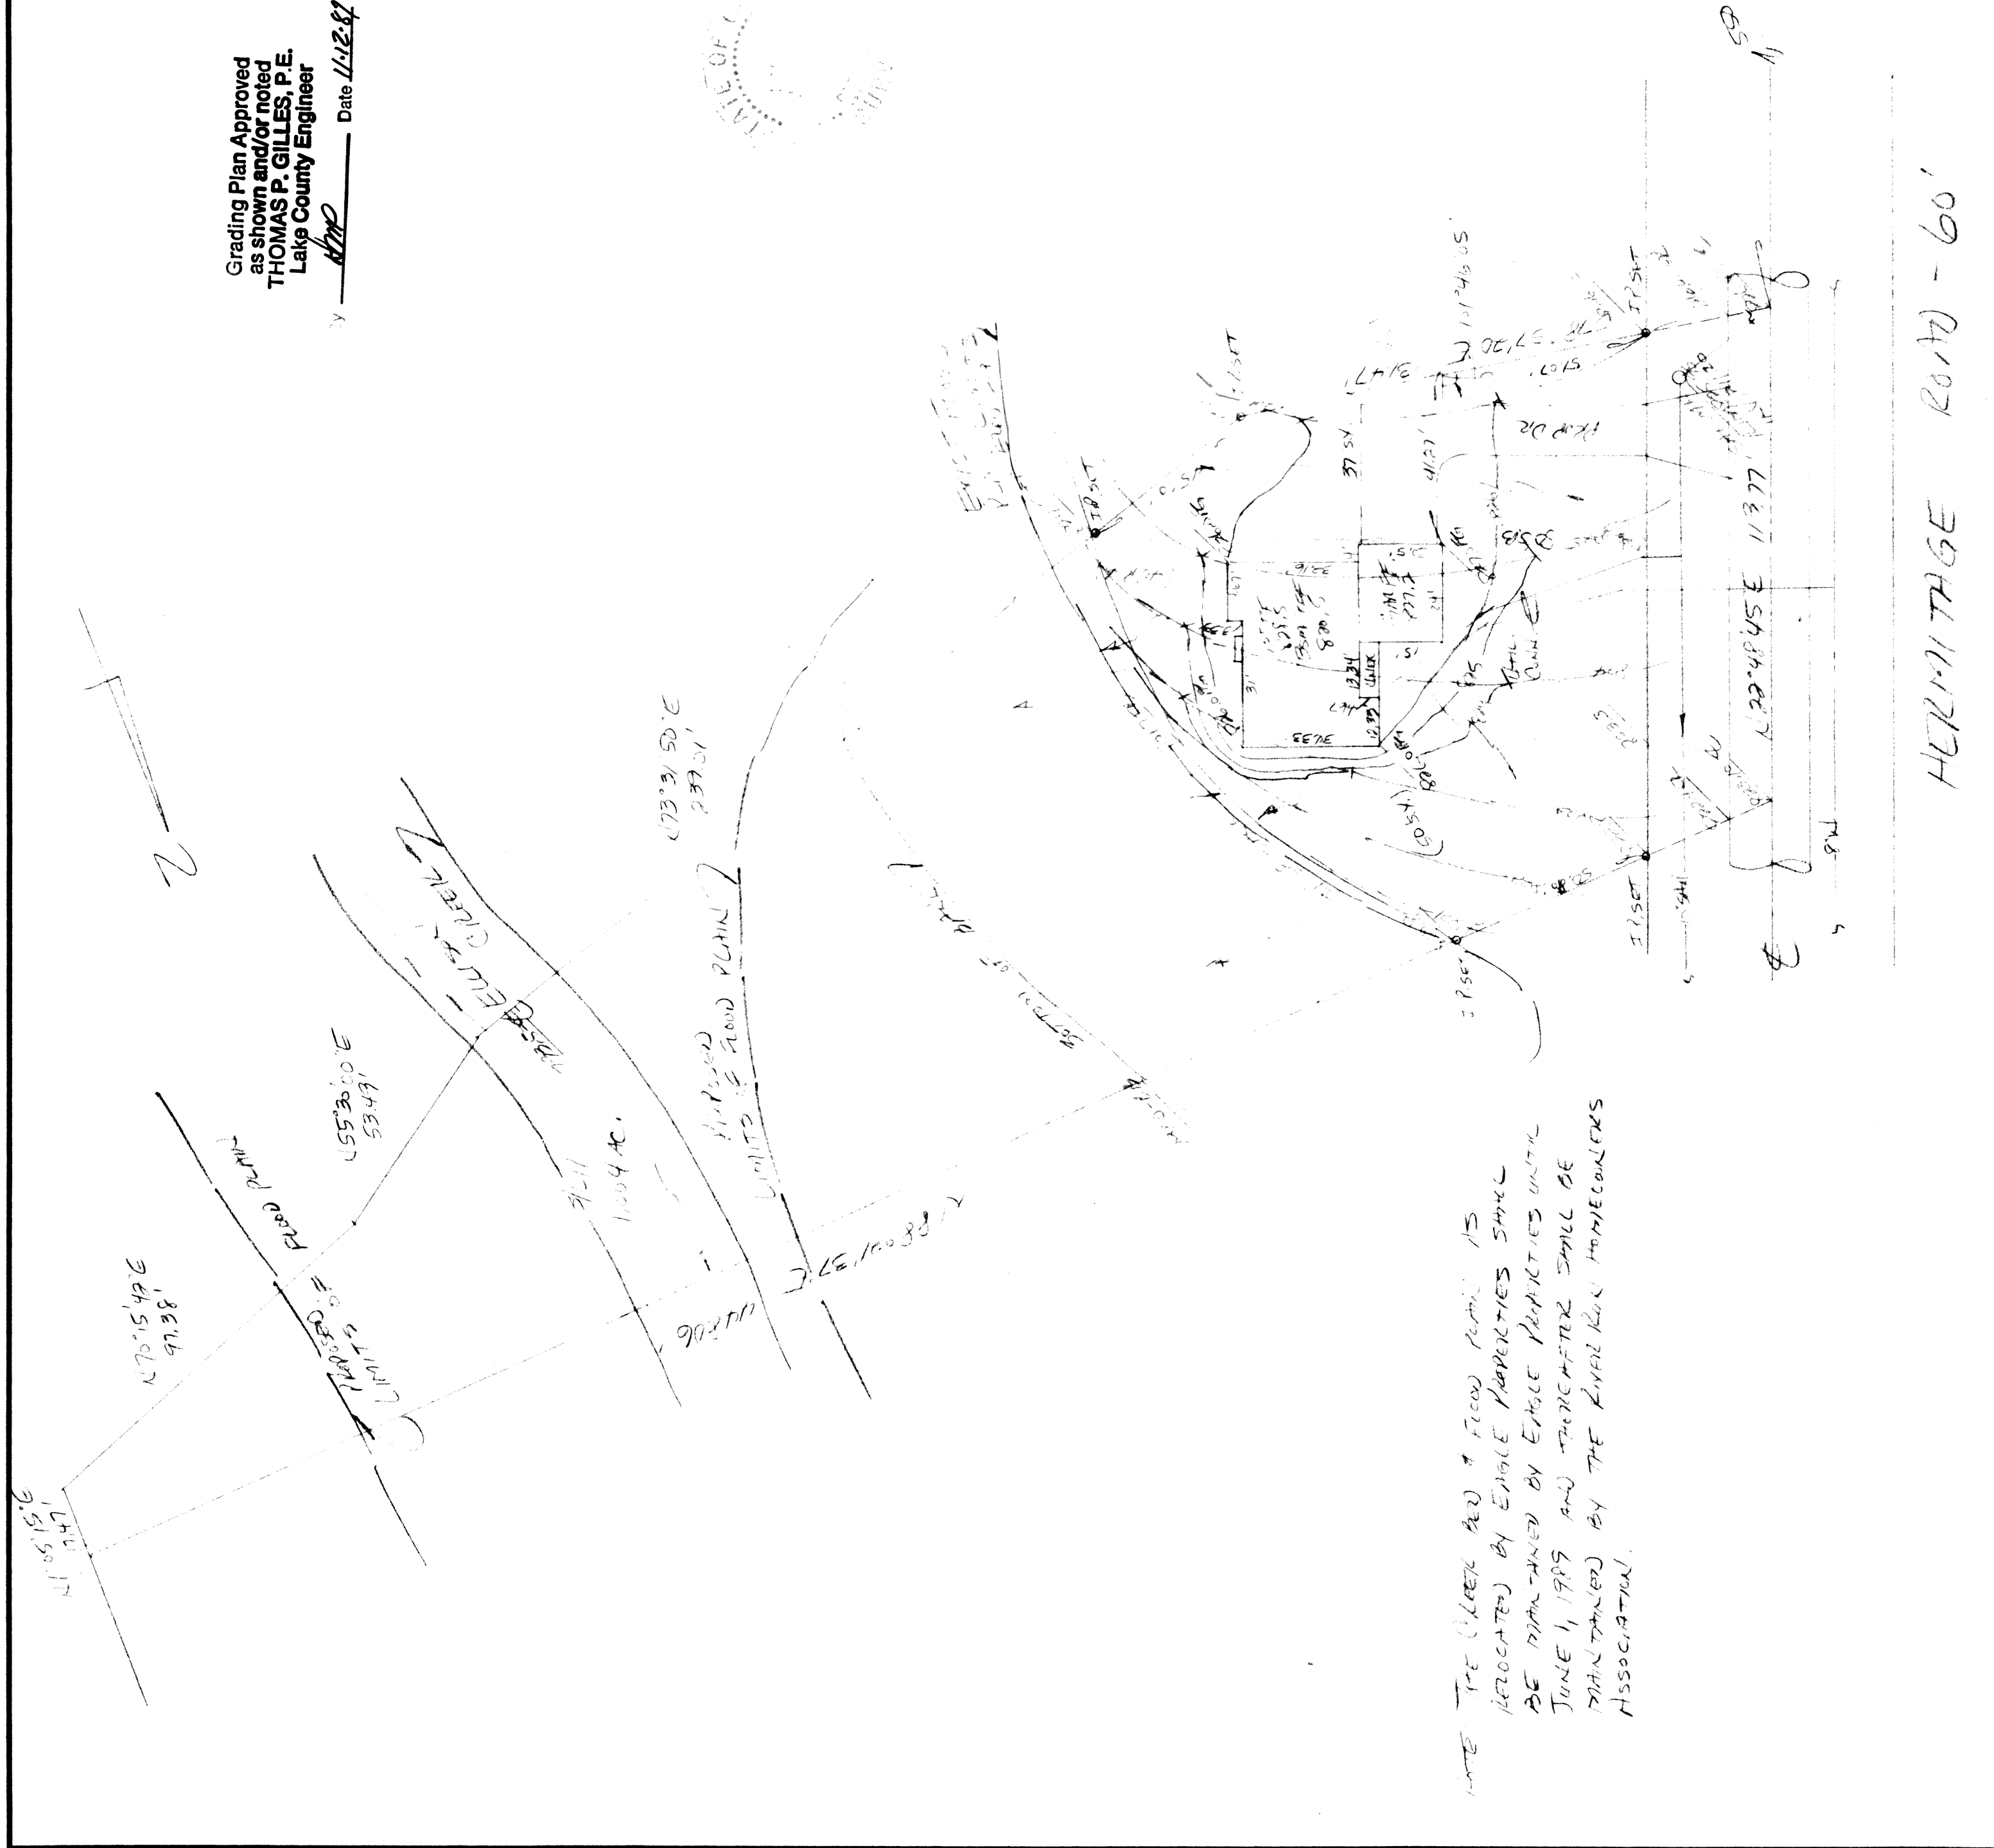

Grading Plan Approved
as shown and/or noted
THOMAS P. GILLES, P.E.
Lake County Engineer
Date 1/12/81

SITE PLAN
CONCORD TOWNSHIP, LAKE COUNTY, OHIO
for: *KIM SMITH HOPKINS*
CLIENT OWNER

ADDRESS	STREET	CITY	ZIP
<i>Ever Run Sub</i>			
SUBDIVISION	NAME	LOT	TRACT
<i>11</i>	<i>Vol. 17, PG. 10</i>		
SUBLOT NO.	STREET	VOLUME	PAGE
		PERM. PARCEL NO.	STREET

LEGEND

SANITARY MANHOLE	WATER VALVE (GAS)
STORM MANHOLE	WATER METER (GAS)
INLET OR CATCH BASIN	AS BUILT ELEVATION
HYDRANT	INDICATES DIRECTION OF SURFACE DRAINAGE
EXISTING CONTOURS	
PROPOSED CONTOURS	
EXIST. ELEV.	PROP. ELEV.

REMARKS

ALL BOUNDARY DATA SHOWN WAS OBTAINED FROM (DEEDS, RECORDED SUBDIVISION PLAT OR OTHER PUBLIC RECORDS)

LOCATIONS AS SHOWN OF ADJACENT WELLS AND SEPTIC TANKS OBTAINED FROM LAKE COUNTY HEALTH DEPARTMENT

DESIGN CERTIFICATION

THIS PLAT WAS PREPARED BY ME, AND IS CORRECT TO THE BEST OF MY KNOWLEDGE AND BELIEF.

CHECK LIST

NAME	SURVEYOR	REGISTRATION NO.
<i>Thomas P. Gilles</i>		
PLAN PREPARED BY:		
<i>BABCOCK • JONES & ASSOCIATES, INC.</i>		
PAINESVILLE, OHIO		
REVISIONS		
NO.	DATE	BY
1	<i>11/12/81</i>	<i>TP</i>
2	<i>11/12/81</i>	<i>TP</i>
3	<i>11/12/81</i>	<i>TP</i>
4	<i>11/12/81</i>	<i>TP</i>
5	<i>11/12/81</i>	<i>TP</i>

WATER MAIN SIZE	LOCATION
SAN. SEWER SIZE	% GR. LOC.
SAN. MH. CAST. ELEV.	INV. ELEV.
SAN. CONN. SIZE	% GR. LOC.
STORM SEWER SIZE	% GR. LOC.
STORM MH. CAST. ELEV.	INV. ELEV.
PAV'T TYPE	GRADE CURBS
GAS LINE LOC.	SIZE PRESSURE
SEPTIC TANK LOCATION	& DUPPLICATION AREA
WELL LOCATION	
ISOLATION RADIUS	FROM WELL

"AS BUILT" CERTIFICATION

I, HEREBY CERTIFY THAT THE CIRCLED GRADES ARE EXISTING FINISH GRADES CHECKED IN THE FIELD ON 19 19 19 AND ARE CORRECT TO THE BEST OF MY KNOWLEDGE AND BELIEF.

REGISTERED SURVEYOR	REG. NO.
<i>Thomas P. Gilles</i>	<i>11111</i>

ALBERT KIM LINE
STATE ROUTE 70

HERMITAGE ROAD - 60'