



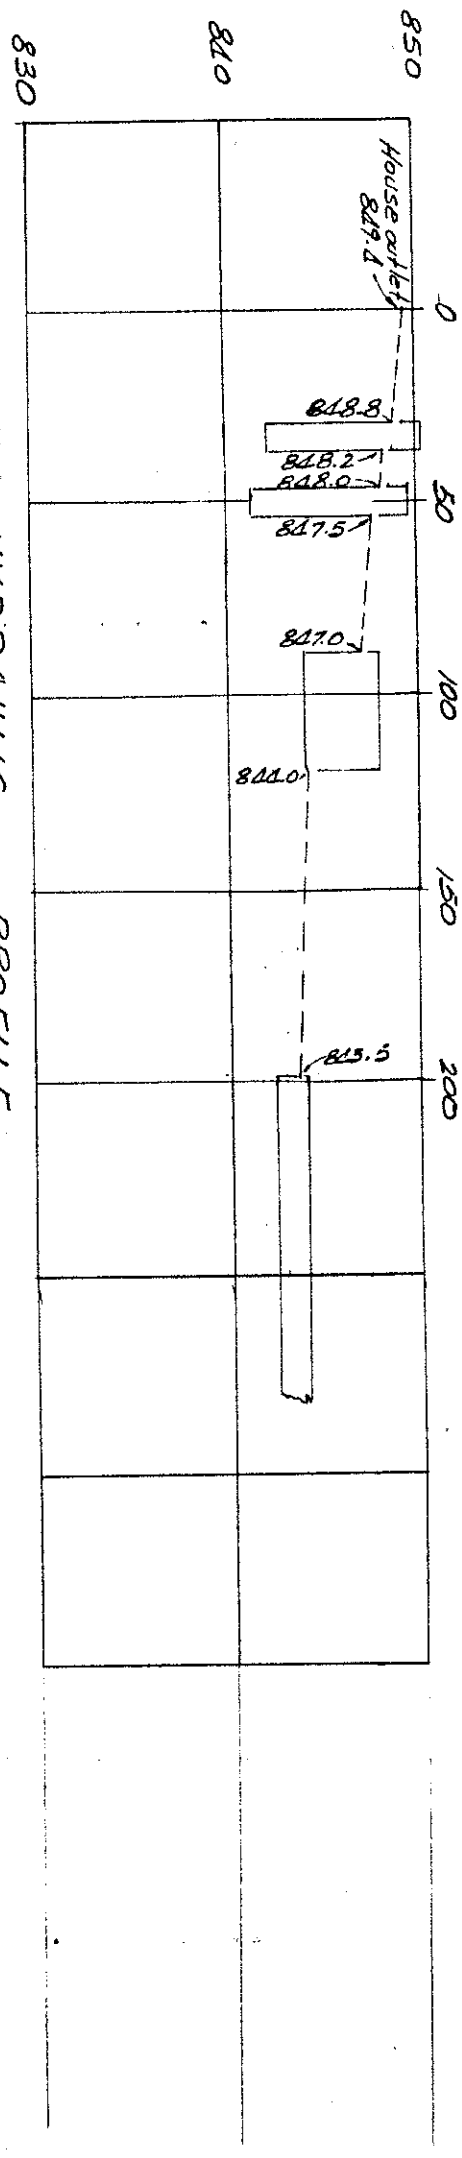

HYDRAULIC PROFILE

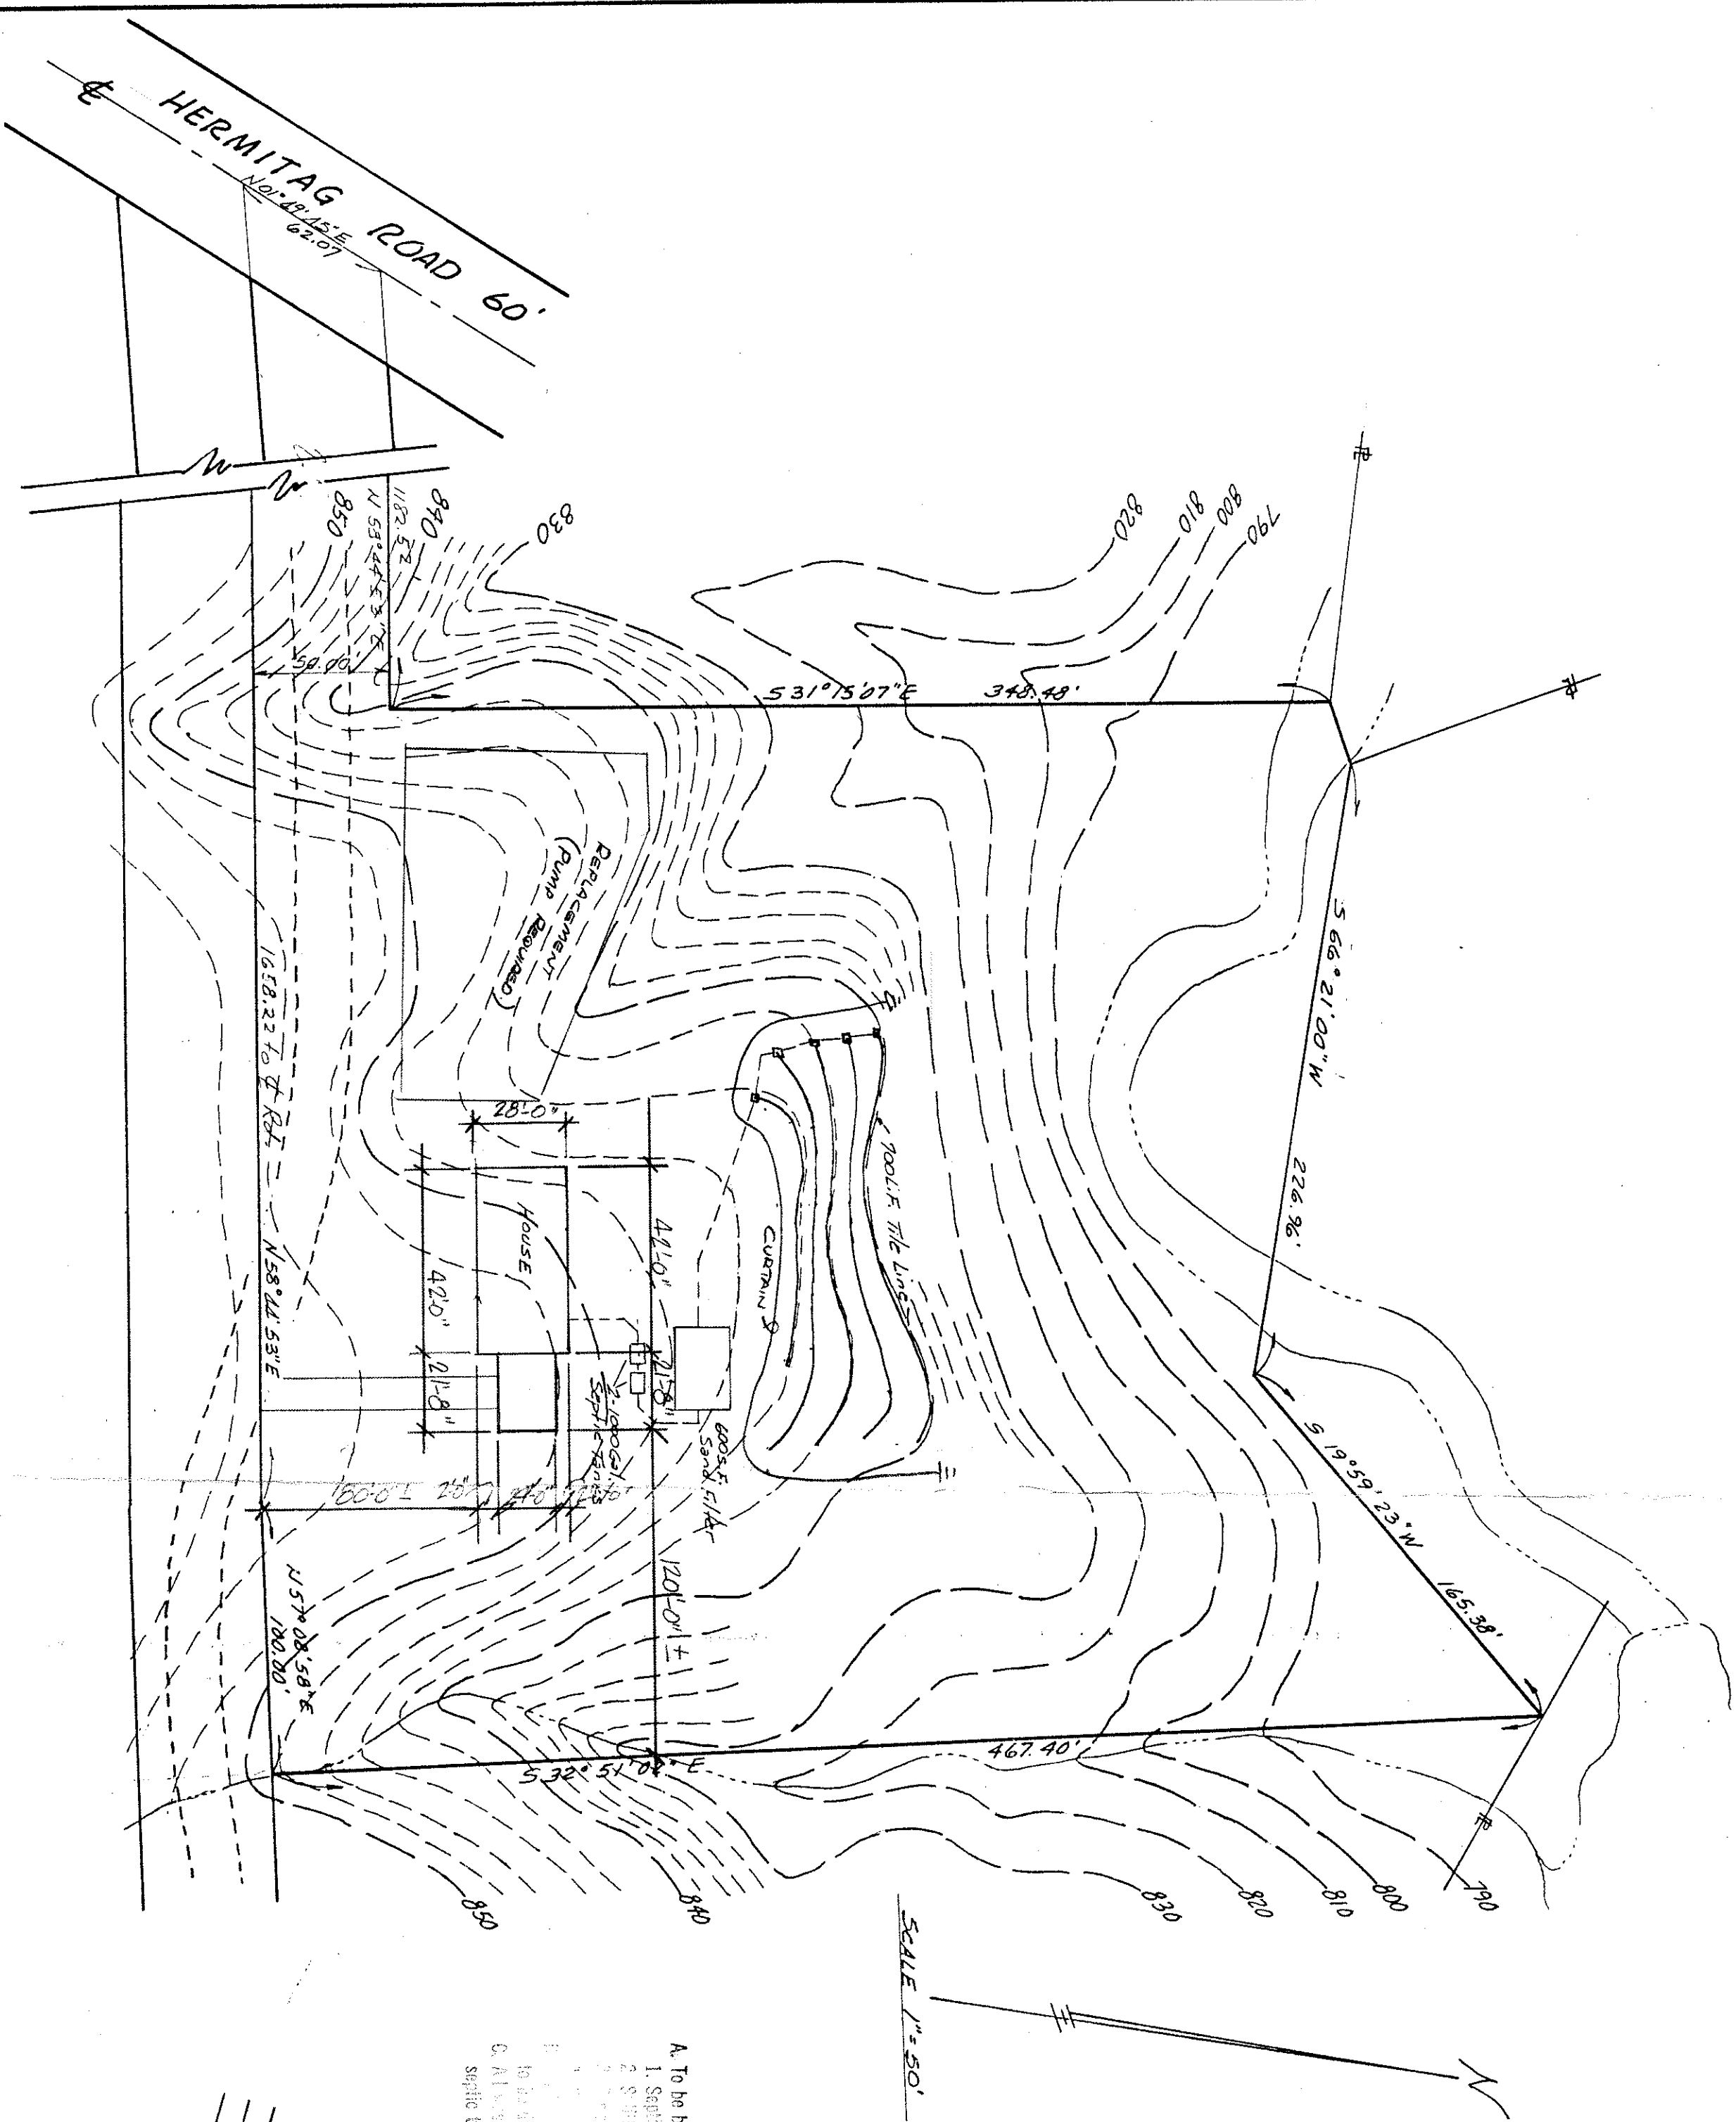


PROPOSED LOCATION OF
HOUSE & WASTEWATER DISPOSAL
SYSTEM FOR
DAVID & KATHY KASNAKEY
51.15 EWER RD - CONCORD TWP

#5728

3-17-88

Ten J. Mearns

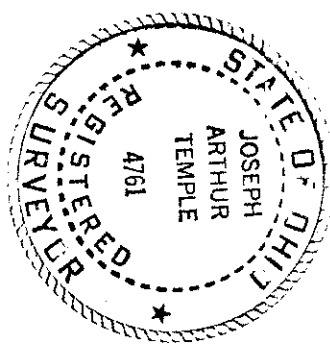

- A. To be brought to finished grade
- 1. Septic tank, including covers
- 2. 8" water line cover
- 3. 4" vent line to roof
- 4. 4" vent line to roof
- B. 4" water line to be installed to the septic tank
- C. All waste water to be discharged into septic tanks

LOW YIELD WATER
FIXTURES REQUIRED
ON ALL:
— Shower Head
— Toilet

Reviewed and Accepted
LAKE COUNTY HEALTH DISTRICT
Date 3-11-88
By Robert R. S. M.P.H.
Health Commissioner

SEWAGE DISPOSAL PERMIT MUST BE
OBTAINED BY A LAKE COUNTY LICENSED
INSTALLER BEFORE INSTALLATION IS
STARTED.