



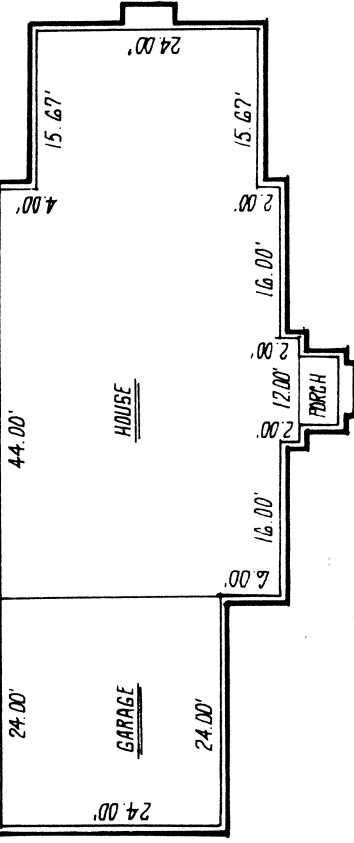

PARCEL NO. 3 HOUSE DETAIL

- PROPOSED -
100 YEAR FLOOD PLAIN ELEV. 786.25 FOR PARCEL NO. 3

MIKE & EVELYN SPISAK
VOL. 334 PG. 448

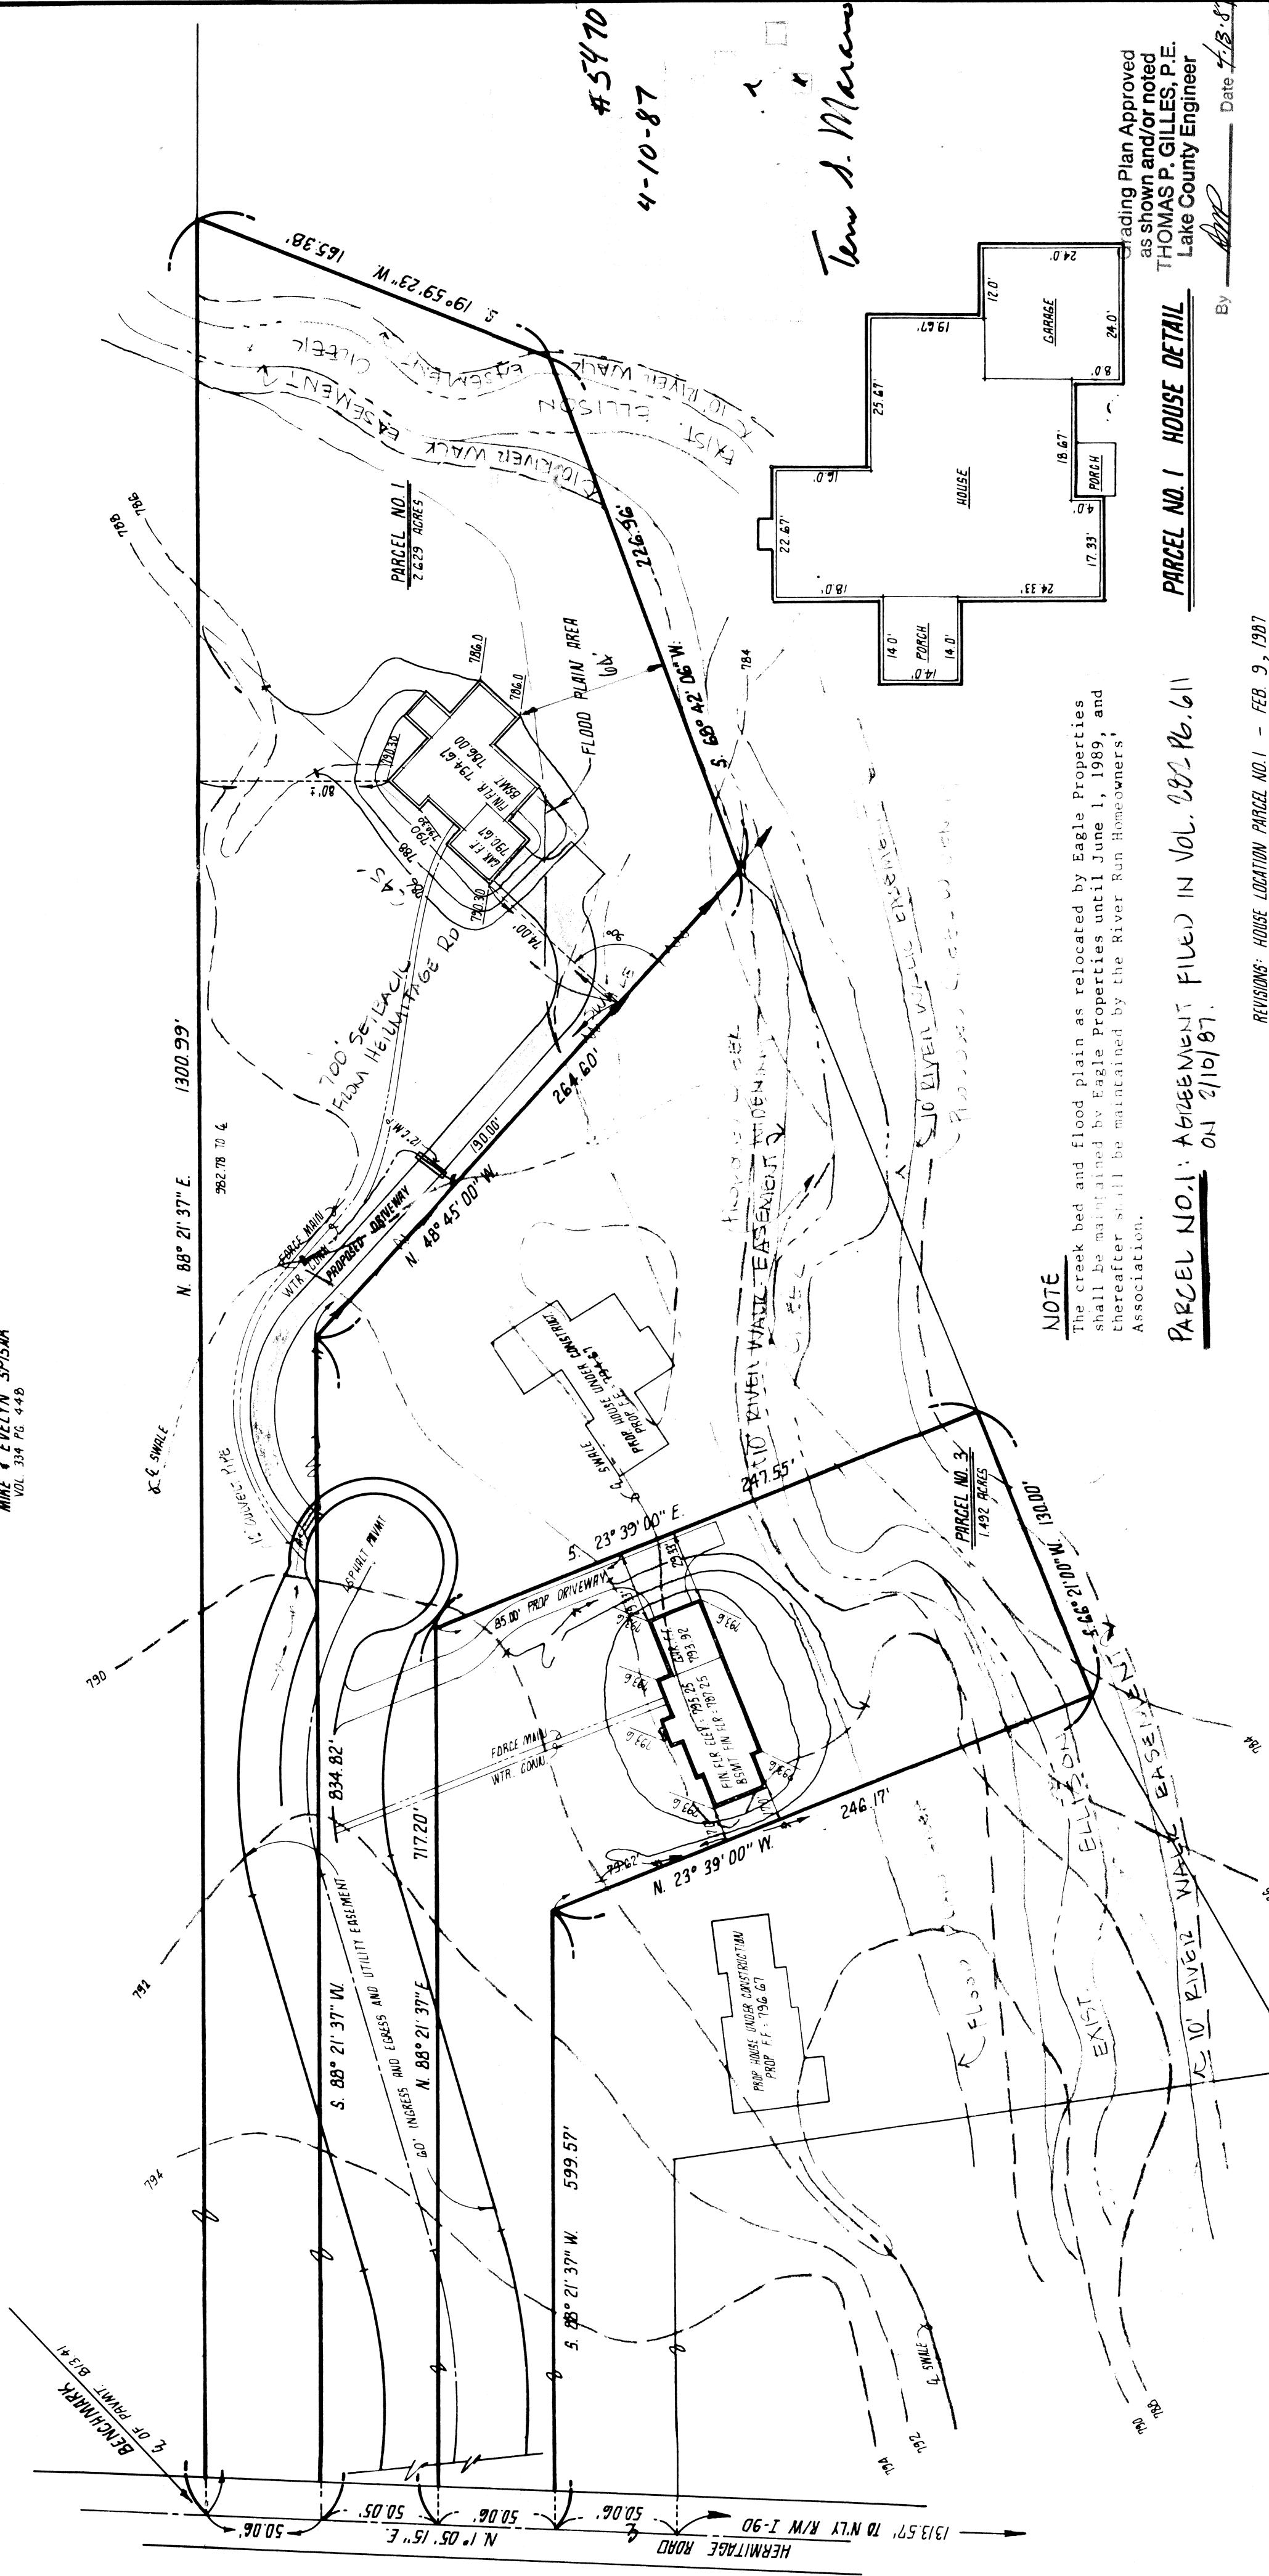


NOTE

The creek bed and flood plain as relocated by Eagle Properties shall be maintained by Eagle Properties until June 1, 1989, and thereafter shall be maintained by the River Run Homeowners' Association.

PARCEL NO. 1: AGREEMENT FILED IN VOL. 282 PG. 611 ON 2/10/87.

PARCEL NO. 1 HOUSE DETAIL

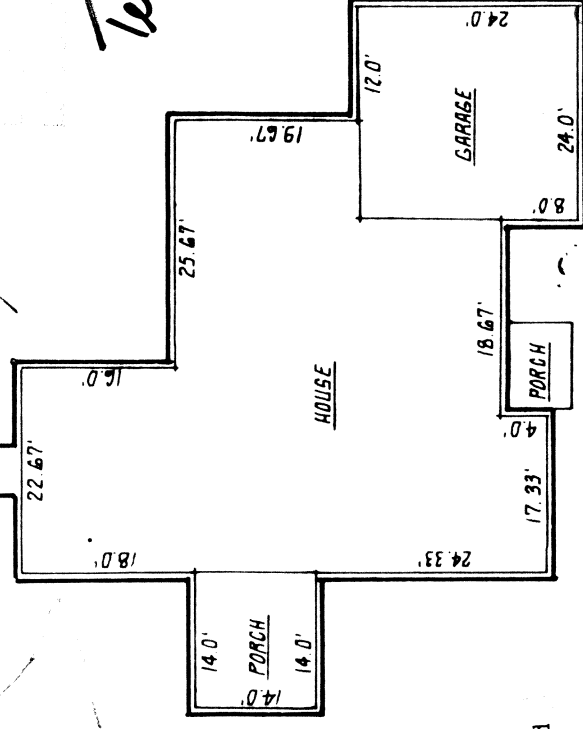

Grading Plan Approved
as shown and/or noted
THOMAS P. GILLES, P.E.
Lake County Engineer

By *[Signature]* Date 4-10-87

REVISIONS: HOUSE LOCATION PARCEL NO. 1 - FEB. 9, 1987

- PROPOSED -
100 YEAR FLOOD PLAIN ELEV. 785.00 FOR PARCEL NO. 1

SITE PLAN FOR: EAGLE PROPERTIES

BEING PART OF LOT NO. 24 IN TRACT NO. 4 IN CONCORD TOWNSHIP, LAKE COUNTY, OHIO
BEING PARCEL NUMBER 1 (2.629 ACRES)

CERTIFICATION
THIS PLAT WAS PREPARED BY ME
AND IS CORRECT TO THE BEST OF
MY KNOWLEDGE AND BELIEF
[Signature]
REC'D SURVEYOR NO. 5244



COLPETZER WOODS
CONSULTANTS, INC.
MENTOR, OHIO 44060

DATE 1-7-87
SCALE 1"=50'
DRAWN BY JW
CHK'D BY

SHEET ONE OF ONE
CONTRACT NO. 07-729