


V:\2002\2021\1102111 50.dwg 02/15/2005 02:20:12 PM Copy to: B:\Barrington\Cons... 3 Group

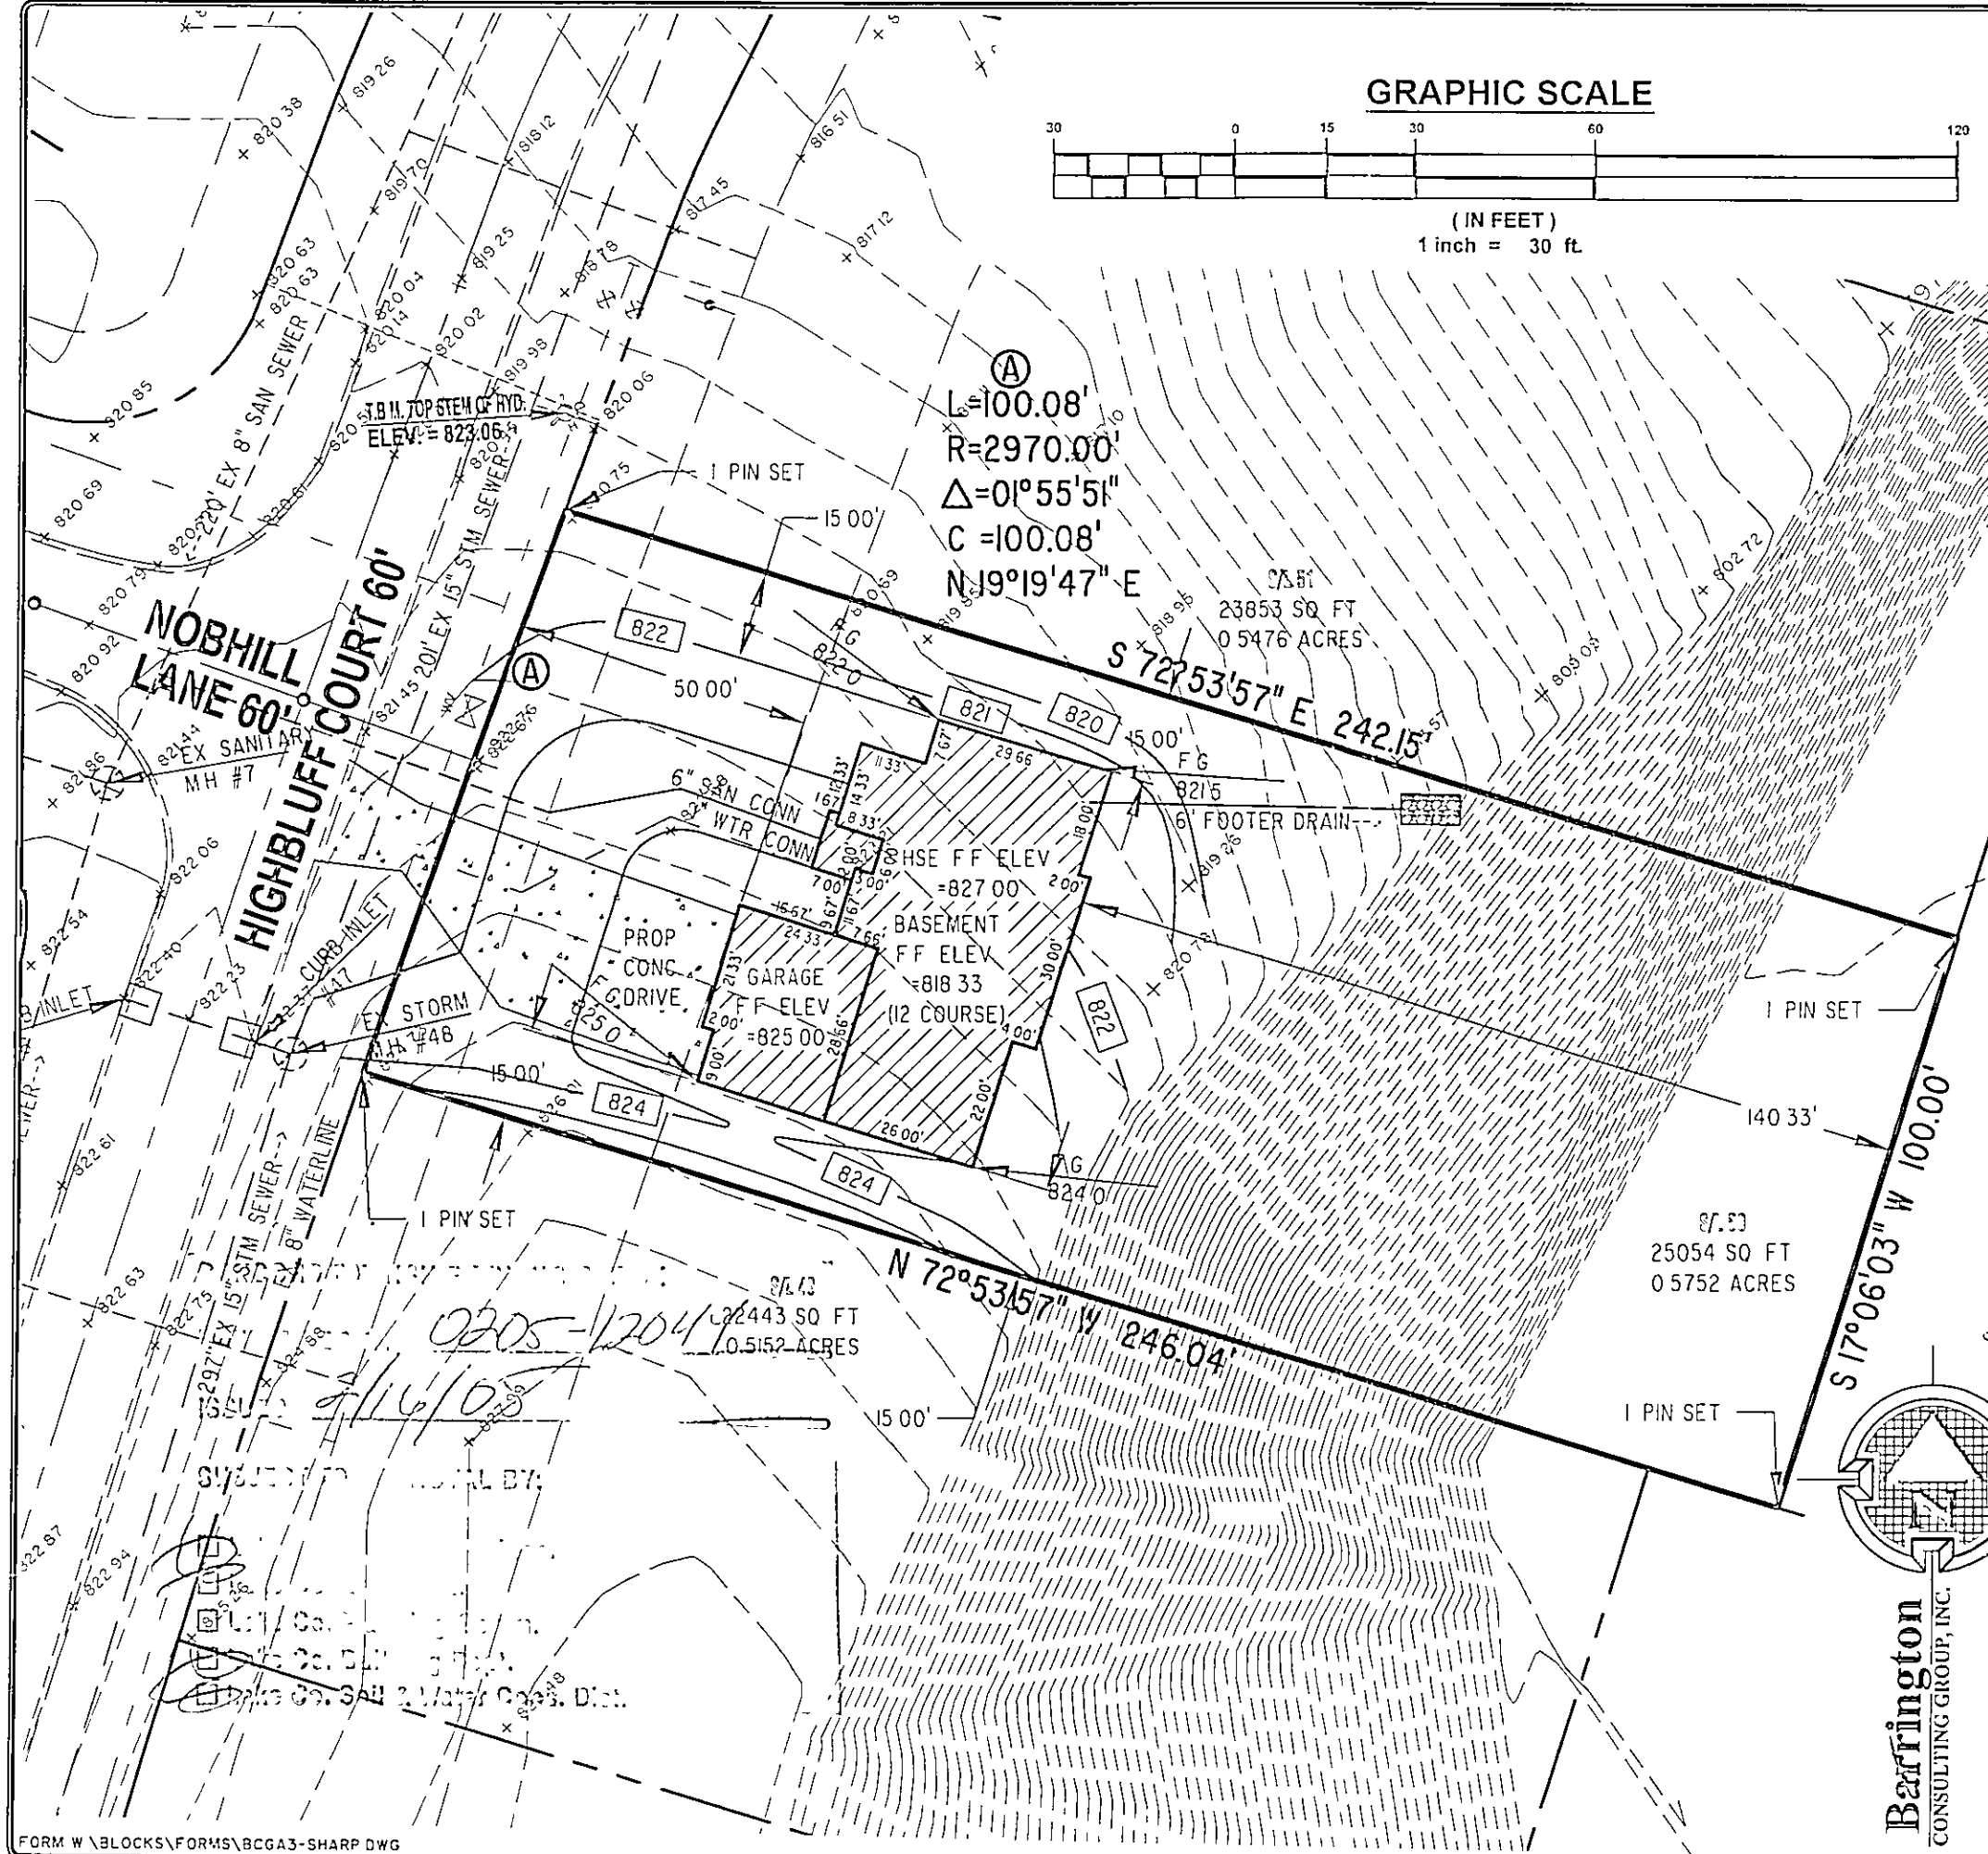

GENERAL NOTES:

- 1 BENCHMARK - TOP STEM OF EXISTING FIRE HYDRANT LOCATED IN FRONT SUBLOT 51, ELEVATION = 823.06
- 2 DRIVEWAY APRON TO BE 6" THICK CONCRETE.
- 3 ALL DOWNSPOUTS TO BE OUTLETED TO SPLASH BLOCKS
- 4 CONTRACTOR RESPONSIBLE FOR CONTACTING THE OHIO UTILITY PROTECTION SERVICE (1.800.362.2764) AND ALL UTILITY COMPANIES A MINIMUM OF 48 HOURS PRIOR TO CONSTRUCTION.
5. THE LOCATION BOTH HORIZONTAL AND VERTICAL OF EXISTING UNDERGROUND UTILITIES SHOWN HEREON, HAVE BEEN OBTAINED BY A DILIGENT AND COMPREHENSIVE SEARCH OF AVAILABLE RECORDS. VERIFICATION BY FIELD OBSERVATION HAS BEEN CONDUCTED WHERE PRACTICAL, HOWEVER, BARRINGTON CONSULTING GROUP, INC DOES NOT GUARANTEE THE COMPLETENESS, NOR ACCURACY THEREOF
6. CONTRACTOR SHALL VERIFY ELEVATIONS OF LATERAL INVERTS IN THE FIELD PRIOR TO FOUNDATION EXCAVATION.
7. SEE SHEET 2 FOR EROSION AND SEDIMENT-CONTROL PLAN
8. SEE SHEET 2 FOR SEEDING INFORMATION

CERTIFICATION :

"I THE UNDERSIGNED HEREBY CERTIFIES THAT THIS TOPOGRAPHY INDICATED BY 1 FOOT CONTOURS AND ELEVATION SHOWN HEREON REPRESENTS AN ACTUAL SURVEY MADE BY ME ON THE 10th DAY OF APRIL, 2003 AND THE ELEVATIONS WERE TAKEN AT AN APPROPRIATE INTERVAL AND AS OF THAT DAY THEY EXISTED AS INDICATED HEREON.

"I HEREBY CERTIFY THAT THIS PLAN WAS PREPARED BY ME AND IS CORRECT TO THE BEST OF MY KNOWLEDGE AND BELIEF"


DAVID W. NOVAK, P.S. No 7507

CERT 1204

SANITARY M.H. #7	CURB INLET #46
RIM = 821.70	TBCURB = 822.40
INV. = 806.04	GUT = 822.02
	INV. 12"E = 817.84
STORM M.H. #48	CURB INLET #47
RIM = 822.65	TBCURB = 822.37
INV. = 815.67	GUT = 822.01
	INV. 12" E = 817.74
	INV. 12" W = 817.68

REVISIONS	BY
REVISED HOUSE FEB 14 2005	WSO
REVISED HOUSE FEB 15, 2005	DWN

Barrington
CONSULTING GROUP, INC.
9114 TYLER BLVD., MENTOR, OHIO 44060
PHONE 440.205.1260 FAX 440.205.1262
BCG@BarringtonCGI.com

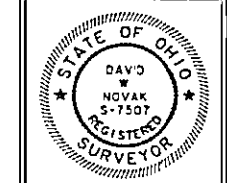

SITE PLAN
7309 HIGHBLUFF COURT, SIL 50 HERMITAGE BLUFFS No. 2
CONCORD TWP., OHIO 44077
EYE-WILL DEVELOPMENT, INC.

DRAWN WSO
CHECKED DWN
DATE FEB 14, 2005
SCALE 1" = 30'
JOB NO 02111-50
SHEET 112
OF SHEETS