



REVISIONS	BY
ADDED FLOOD PLAIN JULY 8, 2007	WSO
RAISED F.F. ELEV. JULY 24, 2007	WSO

Barrington
CONSULTING GROUP, INC.
9114 TYLER BLVD., MENTOR, OHIO 44060
PHONE 440.265.1260 FAX 440.265.1262
BCG@BarringtonCGI.com

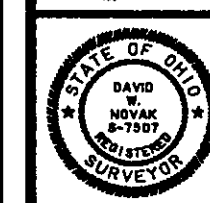

SITE PLAN
7341 HIGHBLUFF CT., CONCORD TWP., OHIO 44077
S/L 43 HERMITAGE BLUFFS SUBDIVISION PL. 2 VOL. 42 PG. 13
EYE-WILL DEVELOPMENT

WSO
CHECKED
DWN
DATE
JULY 09, 2007
SCALE
1" = 30'
JOB NO.
0211-043
SHEET
1/2
OF SHEETS

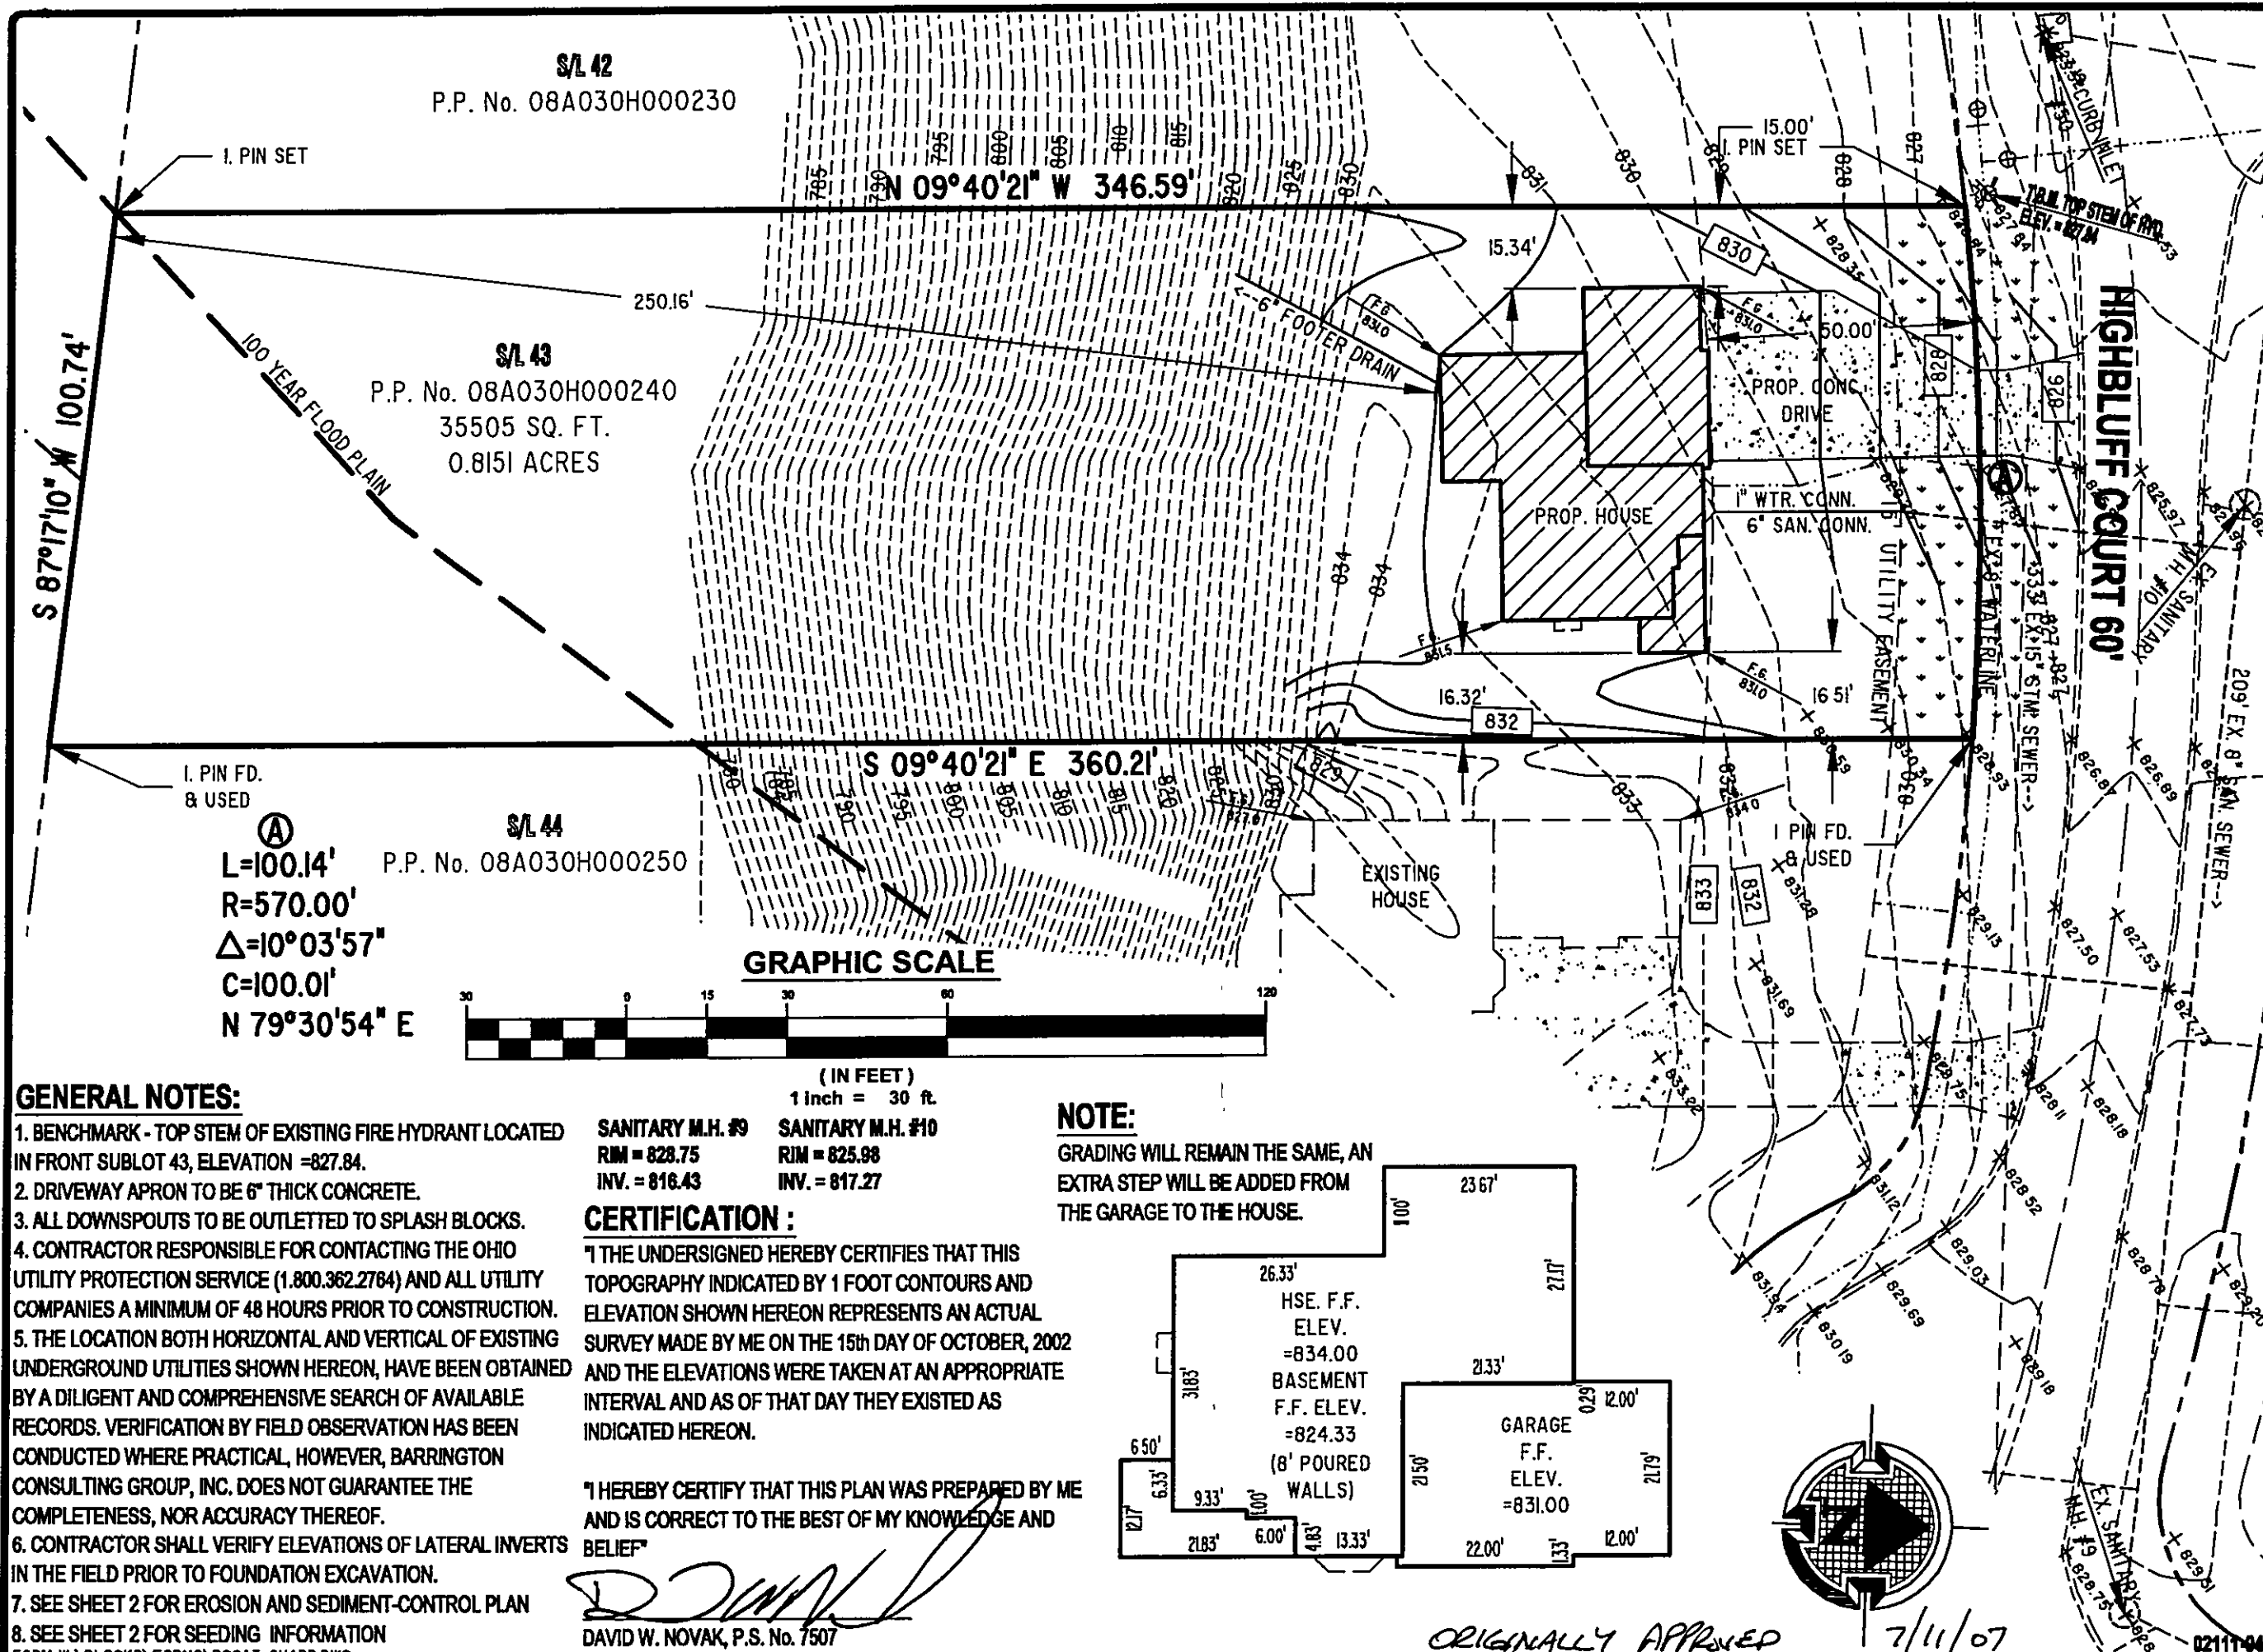

W:\2002\0211\11SL 43\02111-043.dwg, 7/24/2007 11:26:38 AM, Copyright Barrington Consulting Group