


BENCHMARK - RIM OF SAN MH.
IN FRONT OF SILE #8
ELEVATION - 817.05

N. 80° 51' 10" E. 200.14'

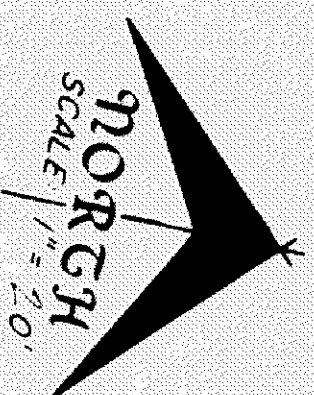

SITE PLAN

CONCORD TWP. LAKE COUNTY, OHIO

for: **RAY ZITZLER**
OWNER
PO BOX 25 MADISON 44057
CITY ZIP

ADDRESS STREET

Subdivision **W-104** NAME
VOL. - PG. **8** HARRY HORSE
SUBLOT NO. STREET

LOT	TRACT
VOLUME	PAGE
PERM. PARCEL NO.	STREET

LEGEND

SANITARY MANHOLE	WATER VALVE (GAS)
WATER METER (GAS)	AS BUILT ELEVATION
INDICATES DIRECTION OF SURFACE DRAINAGE	

REMARKS

ALL BOUNDARY DATA SHOWN WAS OBTAINED FROM IDEEDS, RECORDED SUBDIVISION PLAT OR OTHER PUBLIC RECORDS.
LOCATIONS AS SHOWN OF ADJACENT WELLS AND SEPTIC TANKS OBTAINED FROM LAKE COUNTY HEALTH DEPARTMENT

DESIGN CERTIFICATION

THIS PLAT WAS PREPARED BY ME, AND IS CORRECT TO THE BEST OF MY KNOWLEDGE AND BELIEF.

NAME SURVEYOR REGISTRATION NO.

CHECK LIST

NO. OF BEDROOMS	WATER MAIN SIZE, LOCATION
DIMENSIONS	SAN. SEWER SIZE, % GR. LOC.
BEARINGS	SAN. MH. CAST ELEV., INV. ELEV.
TIE TO NEAREST STREET	SAN. CONN. SIZE, LOC. DEPTH
SUBLOT NO. PARCEL NO.	STORM SEWER SIZE, % GR. LOC.
SURROUNDING OWNERS	STORM MH. CAST ELEV., INV. ELEV.
BLDG. DIMENSIONS FIN. GR.	PAV'T TYPE GRADE CURBS
BLDG. TIES F.L.R. GRADES	GAS LINE LOC. SIZE PRESSURE
APPROX. TYPE WIDTH THICKNESS	SEPTIC TANK LOCATION & DUPLICATION AREA
SIDEWALK TYPE WIDTH THICKNESS	WELL LOCATION
CULVERT TYPE DIA. LENGTH	ISOLATION RADIUS FROM WELL
ROCK OUTCROPPINGS	

PLAN PREPARED BY:

AND DATE BY	DEBEVEC • SALO & ASSOCIATES, INC.
1	125 E. ERIE ST. PAINESVILLE, OHIO
2	
3	
4	
5	


DRAWN BY	SCALE	PHONE NO.
DATE	1" = 20'	352-9250
CHKD. BY	DATE	DRAWING NO.
CRWN	07/16/82	
CHIEF	APPD. BY	178845

"AS BUILT" CERTIFICATION

I, HEREBY CERTIFY THAT THE CIRCLED GRADES ARE EXISTING FINISH GRADES CHECKED IN THE FIELD ON 19
AND ARE CORRECT TO THE BEST OF MY KNOWLEDGE AND BELIEF.

REGISTERED SURVEYOR


REG. NO.

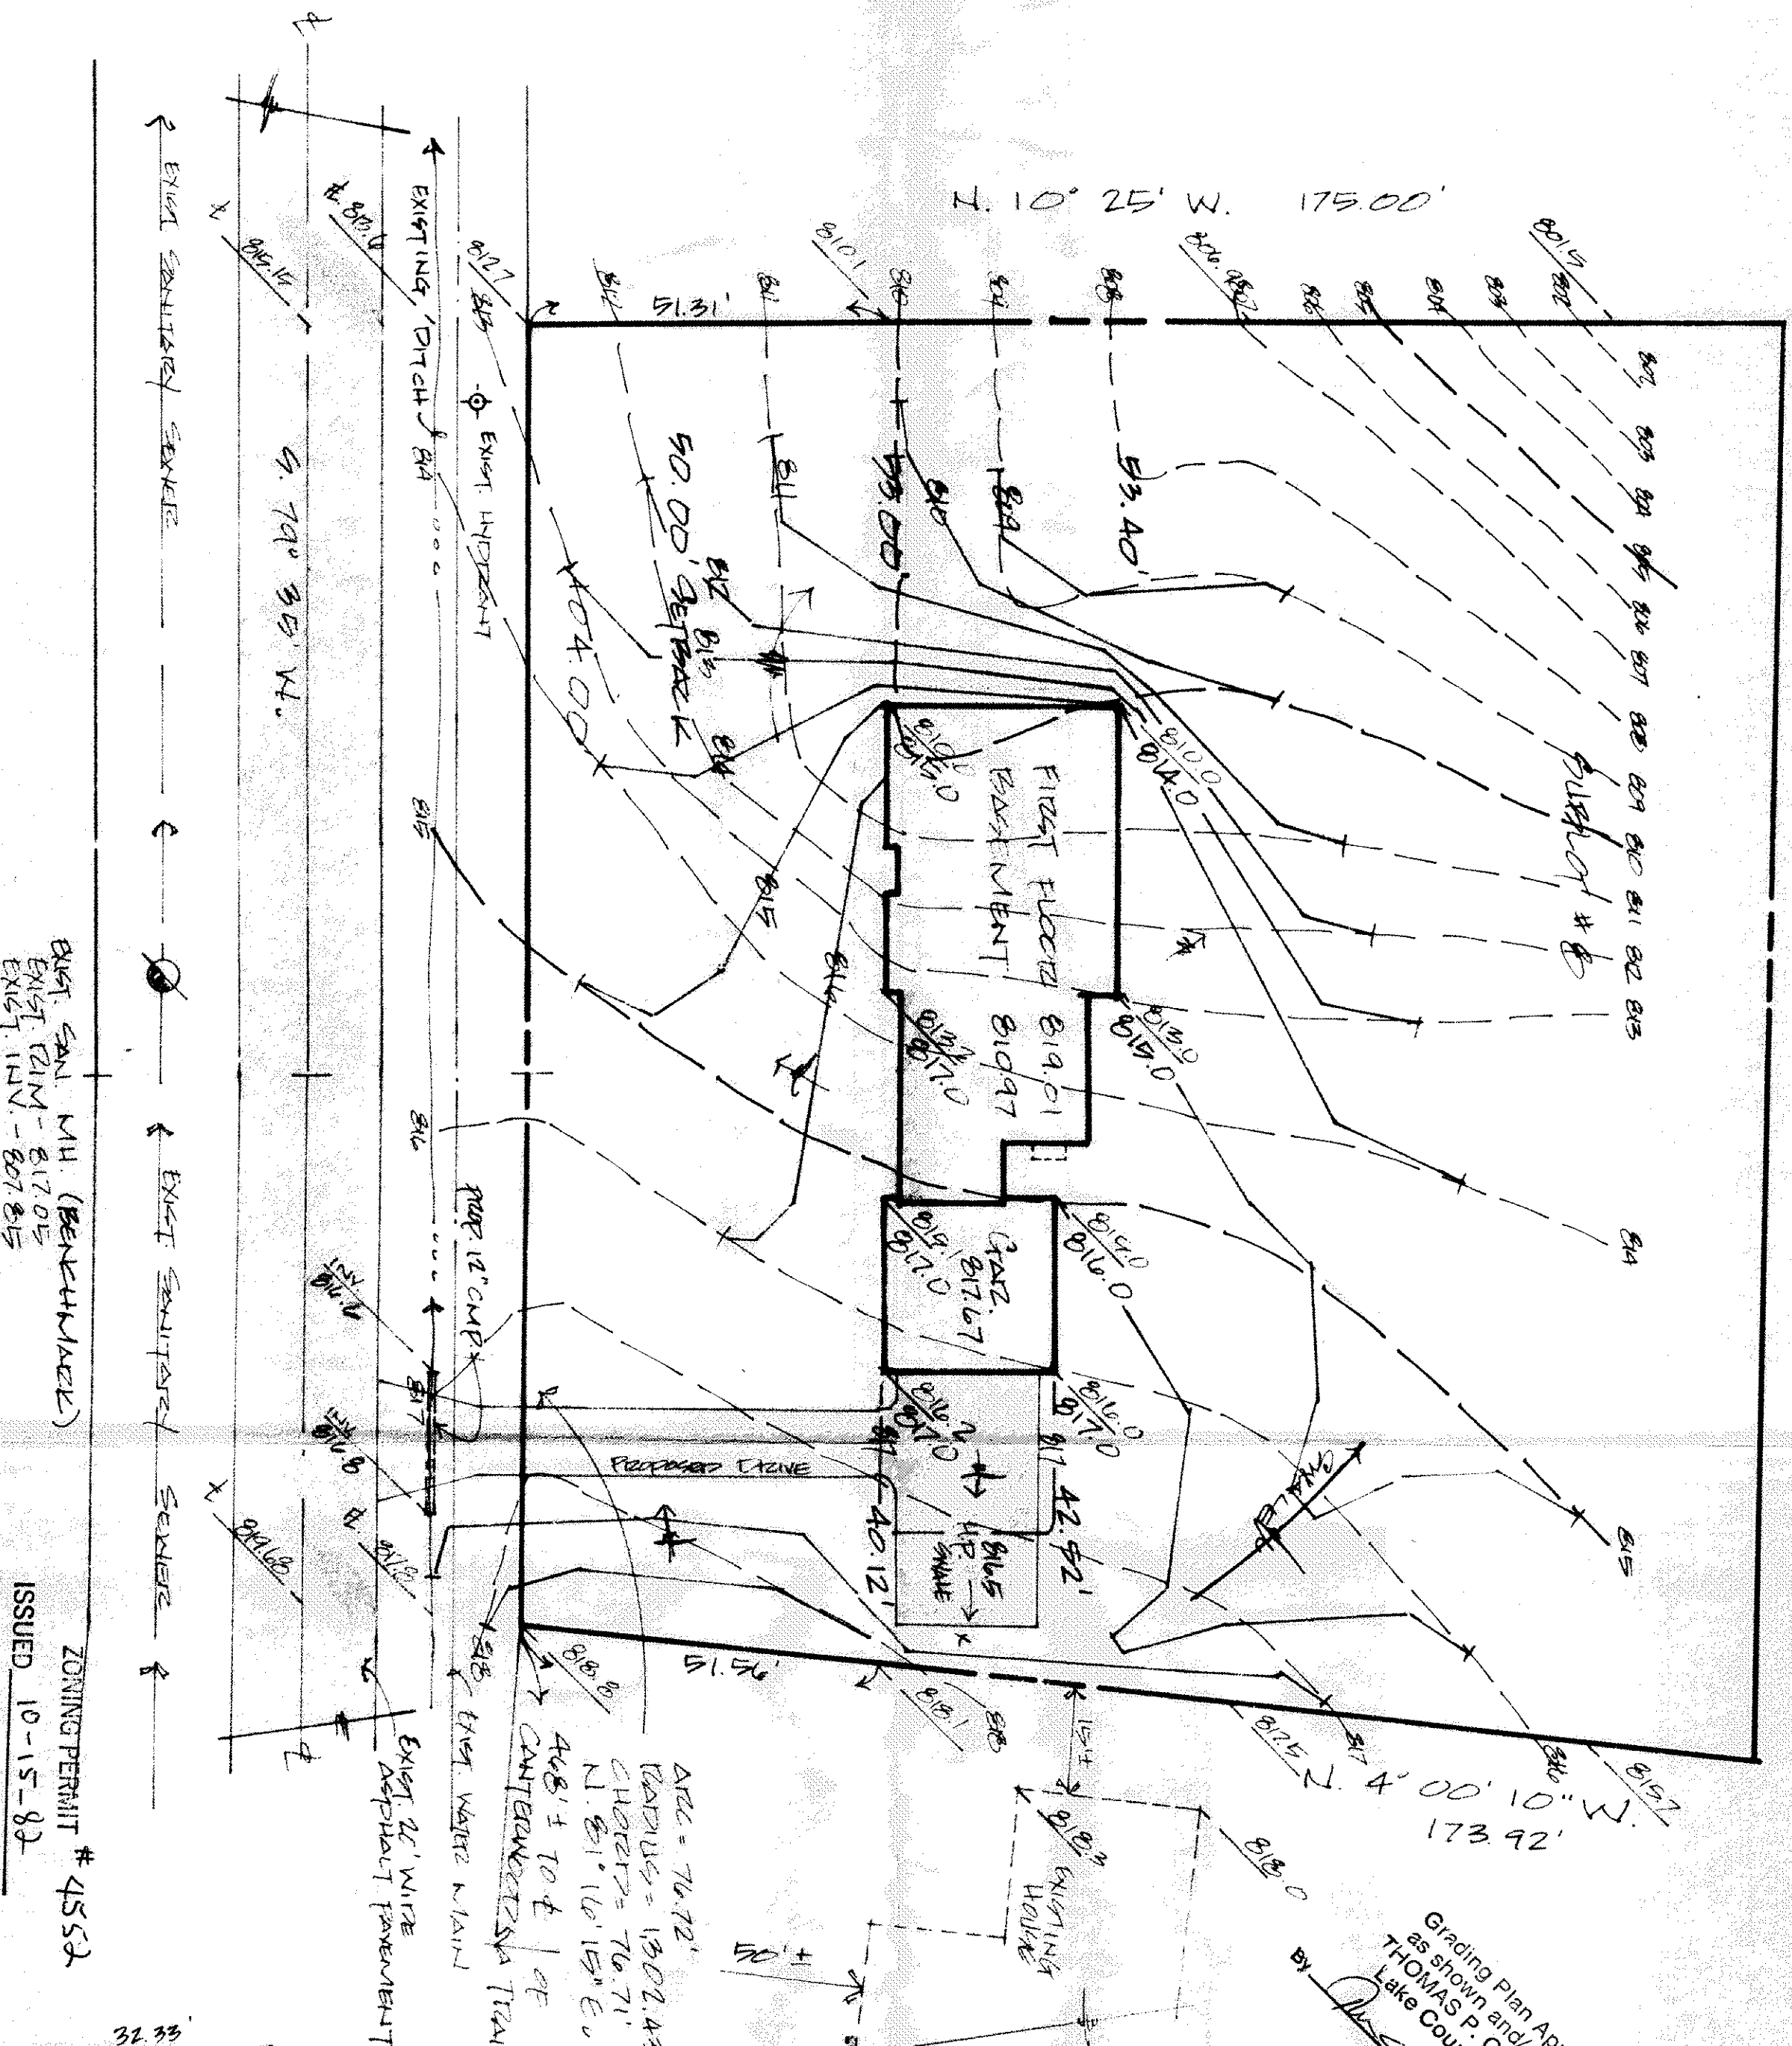

ZONING PERMIT # 4553
ISSUED 10-15-82

SUBJECT TO APPROVAL BY:

- ☐ Lake County Sanitary Eng.
 - ☒ Lake County Eng. Dept.
 - ☐ Lake County Planning Comm.
 - ☐ Lake County Bldg. Dept.
- Issued & Mailed

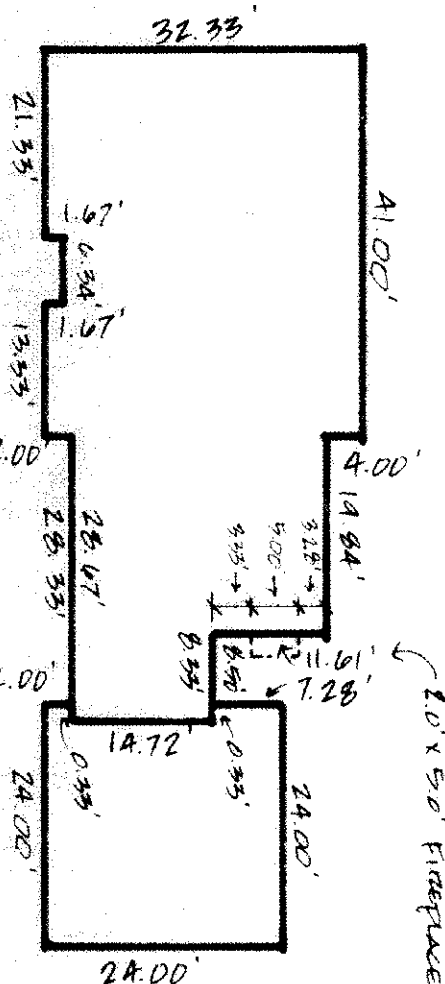

HARRY HORSE
SCALE: 1" = 20'
OCT 11 1982

W.C. # 58845