


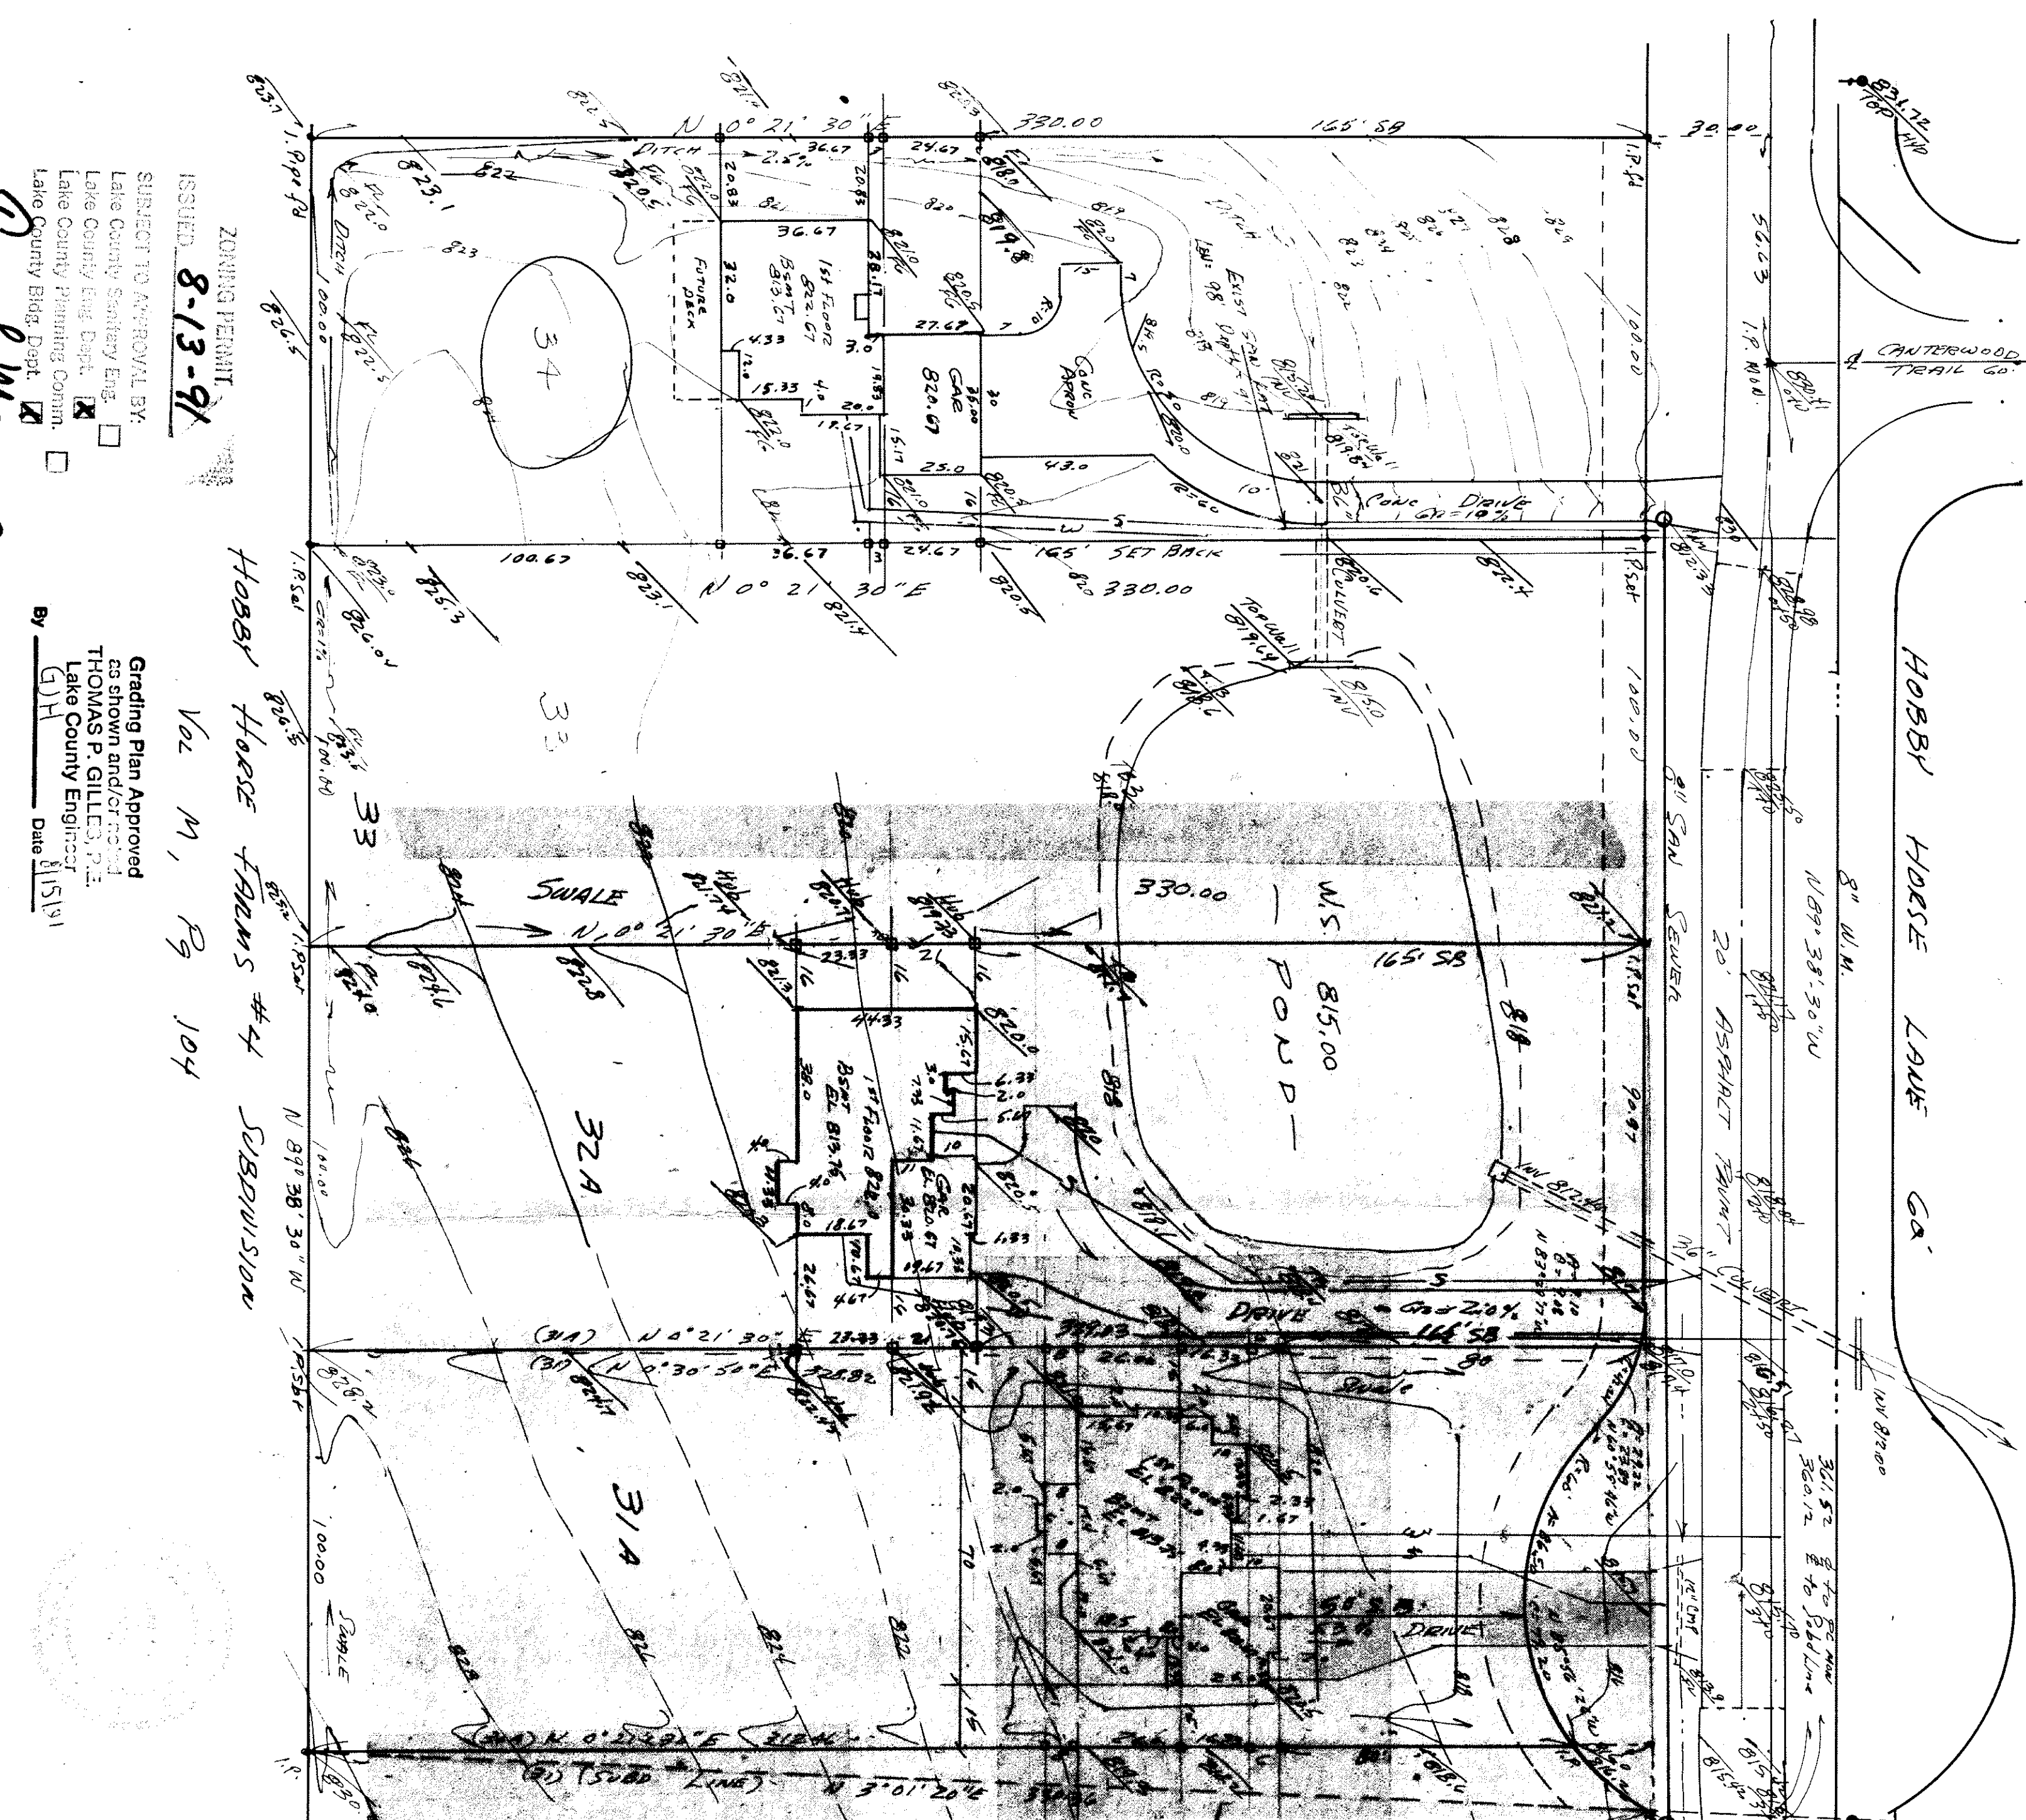

ZONING PERMIT
ISSUED **8-13-91**

SUBJECT TO APPROVAL BY:
Lake County Sanitary Eng. ☐
Lake County Eng. Dept. ☒
Lake County Planning Comm. ☐
Lake County Bldg. Dept. ☒

Grading Plan Approved
as shown and/or noted
THOMAS P. GILLES, P.E.
Lake County Engineer
By GPH Date 8/15/91

DESIGN CERTIFICATION

I, the undersigned, being a duly licensed Professional Engineer in the State of Ohio, do hereby certify that the above described work was done by me or under my direct supervision and that I am a duly licensed Professional Engineer in the State of Ohio.

THE ENGINEER'S CERTIFICATION

I hereby certify that the circled grades shown herein are existing finished grades checked in the field on data shown and are correct to the best of my knowledge and belief.

Reg. No.	Signature	Reg. No.	Date
54,33	Registered Surveyor's Signature	4514	10/2/88
54,34	Registered Surveyor's Signature	4514	11/2/87
54,35	Registered Surveyor's Signature	4514	11/2/87

LEGEND

Existing Elevation: 100.00
Proposed Elevation: 100.00
As-Built Elevation: 100.00
Future Ditch: 100.00

SITE PLAN

For Rev. Title
Woods Shore Drive, PO Box 15
Madison, Ohio 44047
Phone (216) 428-2055

OF SUBMIT NO. 11A, 13A, 33 & 34
Hobby Horse Lane GA
Lake County, Ohio

Prepared By:
Deevec-Salo & Associates, Inc.
560 E. 17th Street
Cincinnati, Ohio 45202
Phone (513) 941-2589

Scale: 1"=20'

22 34 402 6 1411
October 1998