


SCALE 1" = 30'

2 WORKING DAYS
BEFORE YOU DIG
CALL TOLL FREE 800-362-2764
OHIO UTILITIES PROTECTION SERVICE

THIS PROJECT IS EXEMPT FROM THE REQUIREMENTS OF THE OHIO ESC ACT, CHAPTER 604, AS IT IS A SITE PLAN SURVEY FOR A PRIVATE DEVELOPMENT. THE PROJECT IS NOT BEING SUBMITTED TO THE ESC FOR REVIEW.

Willard F. Schade Jr. 6008 11-06-03

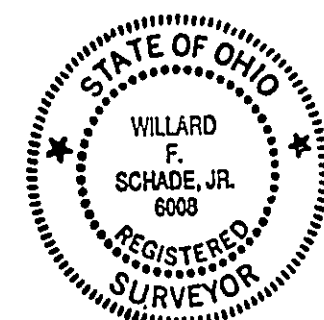

EXIST. & ELEVATION
PROPOSED ELEVATION
EXISTING CONTOUR
PROPOSED CONTOUR

LEARNED

1" FROM FIRE
CAPPED SQUARE
6008 FOUND

TOWNSHIP ZONING OF

PERMIT # 0204-11443
2/17/04

TO APPROVAL

County Engineer
Planning Comm.
Building Dept.
Soil & Water C.

Stormwater Management Plan
Approved as shown and/or noted
JAMES R. GILLS, P.E.
County Drainage Engineer
By 6/11 Date 3/10/04
See attached ESC notes

LOW POINT
PRIVATE DRAINAGE
TO S. WASH. ROAD

This project is exempt from
ESC Plan Review
Date 3-5-04
Lake SWCD

SCHADE SURVEYING COMPANY 403 E. 10th Street, Willard, OH 44091 440.951.6154		
SCALE 1" = 30'	APPROVED BY	DRAWN BY
DATE 11-6-2003		PS
SITE PLAN SURVEY FOR PHILLIP TEKHIPP HOOSE RD. 20' WIDENING & 1' LAKE COUNTY, OHIO		
015 1 104000 FOR PLANNING LOT 15, 29, TRACT 15, 4		DRAWING NUMBER 03-1493

LEE & SUEAN BASIC
01 774 PS 1481
01 20 13 LC 2.5
01 16 30-27-21
01 00 45 1

HOOSE ROAD 60'

Minimum 3' asphalt apron

WHEELER ROAD 60'

