

Example

Erosion and Sediment Control Site Plan

S/L #41 of the Conservation Hills Subdivision

Concord Township, Ohio April 29, 2002

Erosion and Sediment Control Schedule

Ingress-Egress
A stone access drive complete with under lying geo-textile fabric (20 feet wide and 50 feet long) for ingress and egress at the site shall be installed. This drive shall be the only entrance and exit to the site.

Silt Fence
All silt fence shall be installed prior to any earthwork activities at the site in the locations shown on the site plan as well as along the front of any lot that slopes towards the street.

Temporary Seeding
Disturbed areas of the site that are to remain idle for more than thirty (30) days shall be properly seeded and straw mulched within seven (7) days of completion of initial grading. Temporary seeding and mulching of a thirty (30) foot strip of the entire front of the lot shall be maintained on the site once initial grading is complete.

Stabilization of critical areas within fifty (50) feet of any stream or wetland shall be complete within two (2) days of the disturbance if the site is to remain inactive for longer than fourteen (14) days.

Mulching
Straw-mulch shall be applied at a rate of 1 bale per every ten (10) feet of curb, at a width of thirty (30) feet of the entire length of the lot. Wood chips may also be used but must be spread at a minimum depth of four inches over the thirty-foot width and must be accompanied by a properly installed silt fence.

Maintenance
Erosion and sediment controls shall be inspected every seven (7) days or within 24 hours of a 0.5" or greater rainfall event. Necessary repairs shall be made at this time.


Note:
All erosion and sediment control specifications, applications, and timetables are based on the descriptions and standards of The Ohio Department of Natural Resources "Rainwater and Land Development Manual" and can be found in the Lake County Erosion and Sediment Control Rules as adopted December 21, 1999.

The specified erosion and sediment control standards are general guidelines and shall not limit the right of the county to impose, at any time, additional, more stringent requirements. Nor shall the standards limit the right of the county to




125 East Erie Street
Painesville, Ohio 44077
Phone: (440) 350-2730
Fax: (440) 350-2601
www.lakecountyohio.org/soil

Construction Entrance Detail

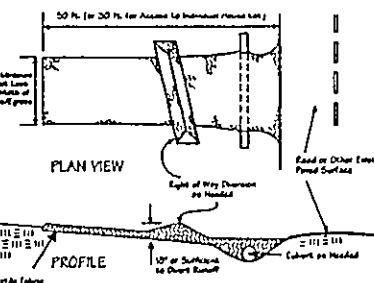

Silt Fence Detail

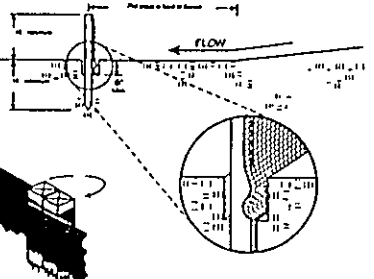

Temporary Seeding Specifications

Seeding Date	Cover	lb./1,000 ft ²	Per Ac.
March 1 to August 15	Orch	3	4 bushel
	Tall Fescue	1	42 lb.
	Annual Ryegrass	1	42 lb.
	Perennial Ryegrass	1	42 lb.
	Tall Fescue	1	42 lb.
August 16 to November 1	Orch	3	2 bushel
	Tall Fescue	1	42 lb.
	Annual Ryegrass	1	42 lb.
	Perennial Ryegrass	1	42 lb.
	Tall Fescue	1	42 lb.
November 1 to Spring Seeding	Orch	3	42 lb.
	Tall Fescue	1	42 lb.
	Annual Ryegrass	1	42 lb.
	Perennial Ryegrass	1	42 lb.

Note: Other approved seed types may be substituted.

- NOTES**
1. PROPOSED EXISTING GROUND GRADES
 2. OVERLAND DRAINAGE FLOW
 3. BENCH MARK TOP AND FRONT OF SUBLOT NO. ELEV.
 4. 970 EXISTING CONTOURS
 5. 970 PROPOSED CONTOURS
 6. IPS = 5/8" IRON PIN SET WITH CAP
 7. ROOF DRAINS SHALL DISCHARGE TO SPLASH BLOCKS
 8. CONTACT Q.C.P.S. TWO WORKING DAYS BEFORE DIGGING 1-800-362-2764

CERTIFY THAT THE BOUNDARY SURVEY IS IN ACCORDANCE WITH CURRENT MINIMUM STANDARDS FOR BOUNDARY SURVEYS IN THE STATE OF OHIO
Ralph W. Kempke P.S. 6257

I CERTIFY THAT ACTUAL FIELD OBSERVATION OF ELEVATIONS HAVE BEEN MADE BY ME ON THE CIRCLE GRADES ACCURATELY DEPICT THE AS-BUILT CONDITIONS OBSERVED BY ME ON

Ralph W. Kempke P.S. 6257


FINISH FLOOR GRADES

GARAGE FLOOR 967.54
1ST FLOOR 969.83
BASEMENT FLOOR 960.54
BOTTOM OF FOOTER 959.54

SIL 14
VACANT LOT

SILT FENCING
TEMP. SEEDING & MULCHING
CONSTRUCTION ENTRANCE WITH UNDERLAIN FILTER FABRIC

Stoned construction entrance with underlain filter fabric
Temporary seeding and mulching of all disturbed areas (see details on sample sheet)
Storm sewer inlet protection for rear yard drains and catch basins
Temporary seeding within 50 feet of any stream or wetland (as necessary)
Silt fencing (where necessary)

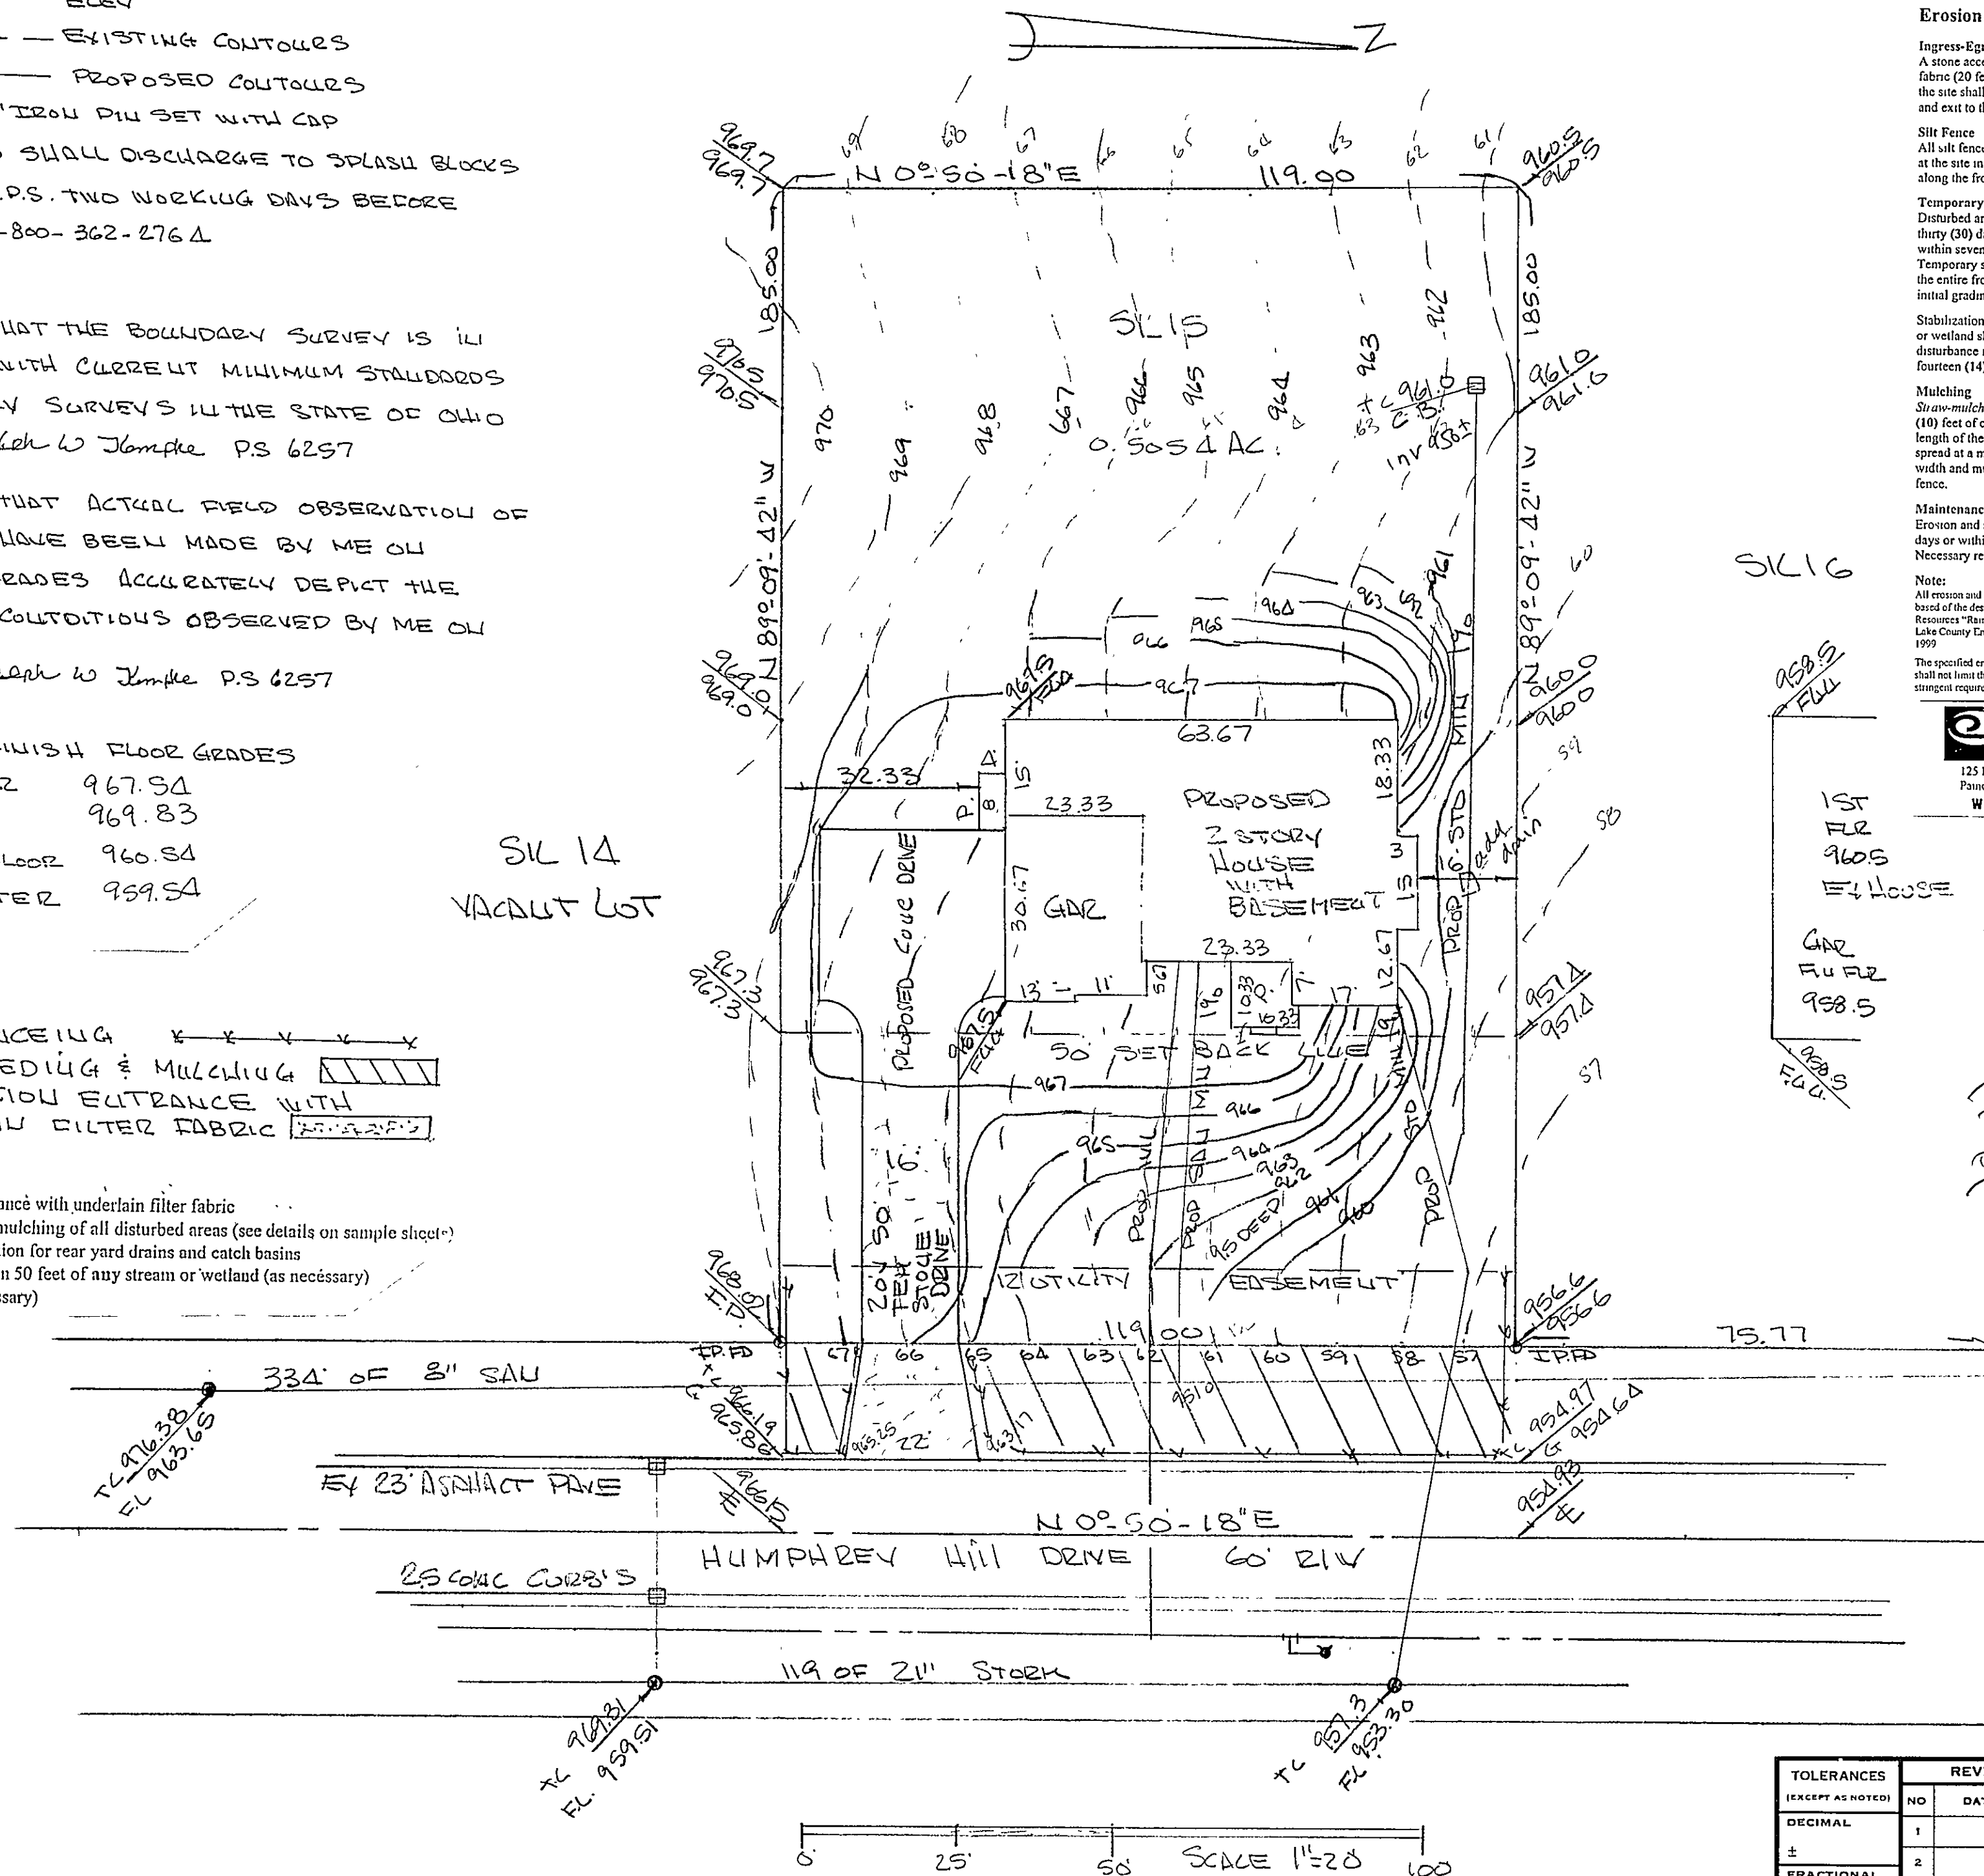

SIL 16

958.5
FULL

1ST
FLR
960.5

HOUSE

GAR
FLR
958.5

958.5
FULL

CONCORD TOWNSHIP ZONING OFFICE

ZONING PERMIT # 0704-11770

ISSUED 7/20/04

SUBJECT TO APPROVAL BY:

- ☒ Lake Co. Sanitary Engineer
- ☒ Lake Co. Eng. Dept.
- ☐ Lake Co. Planning Comm.
- ☐ Lake Co. Building Dept.
- ☐ Lake Co. Soil & Water Cons. Dist.


Superintendent Management

Approved as shown and/or noted

JAMES R. GILLS, P.E.

County Drainage Engineer

By G.H. Date 7/23/04

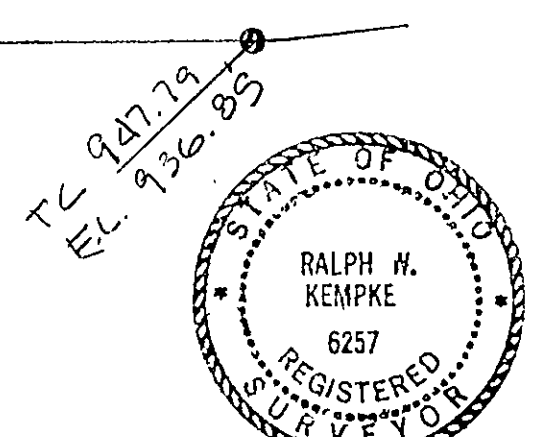

Ralph W. Kempke
1-440-639-8912

TOLERANCES (EXCEPT AS NOTED)			REVISIONS			SITE PLAN FOR		
DECIMAL	±	FRACTIONAL	NO.	DATE	BY	BARR PROS. CONST. INC.		
±		±	1			OF SIL 15 MOUNTAIN SIDE FARMS		
±		±	2			CONCORD, OHIO VOL 43 PG 29		
±		±	3			DRAWN BY	SCALE	MATERIAL
±		±	4			CHK'D	DATE	DRAWING NO.
±		±	5			TRACED	APP'D	